RS 6/79

RECORD SURVEY
OF A PORTION OF
LOT 62 S.C.C.A. LANDS
AS SHOWN ON MAP RECORDED IN MAP BOOK
PAGE 18 RIVERSIDE COUNTY RECORDS.
SURVEY MADE AT REQUEST
OF LACY MATHIS

Davidson and Fulmor, Civil Engineers — September 1923.

Scale 1" = 100'

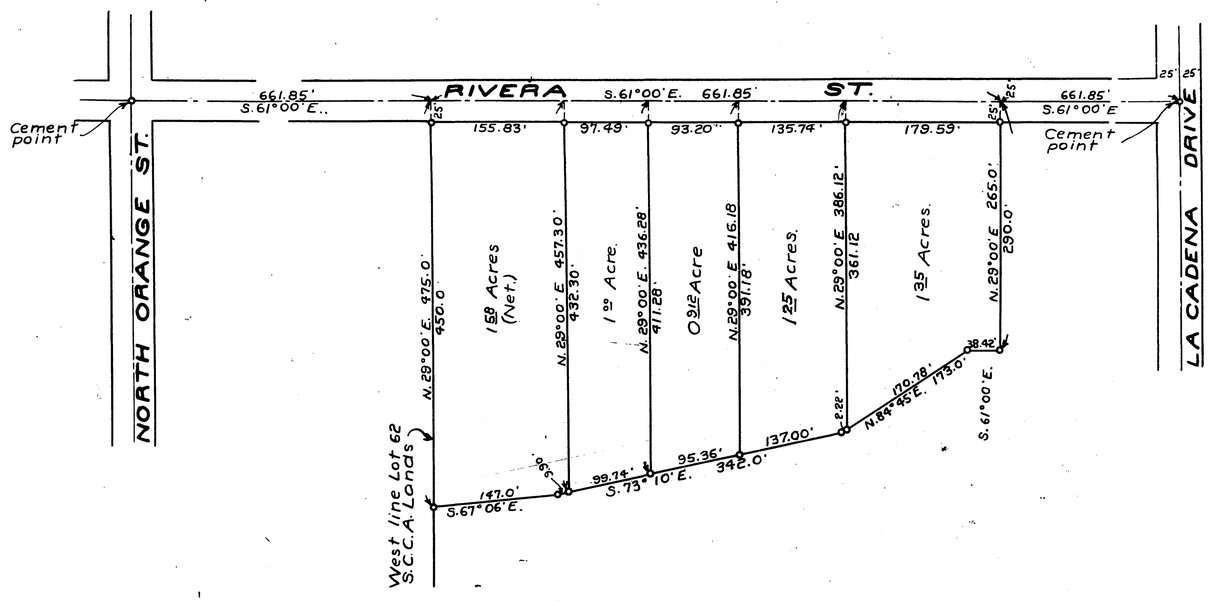

2"x2"x15" redwood stakes set at all points delineated thus, o
Acreage shown includes 1/2 the width of street except tract shown as net.

I hereby certify that I am a Licensed Land Surveyor of the State of California and that this map correctly represents a survey made under my supervision in September 1923 and that all the monuments delineated hereon actually exist and their positions are correctly shown.

A.C. Fulmor
Licensed Land Surveyor

RS 6/79

CB 1 RS 6/79