


BOOK	ONE	PAGE	2
DATE	DRAWN	CHKDBY	APP. BY

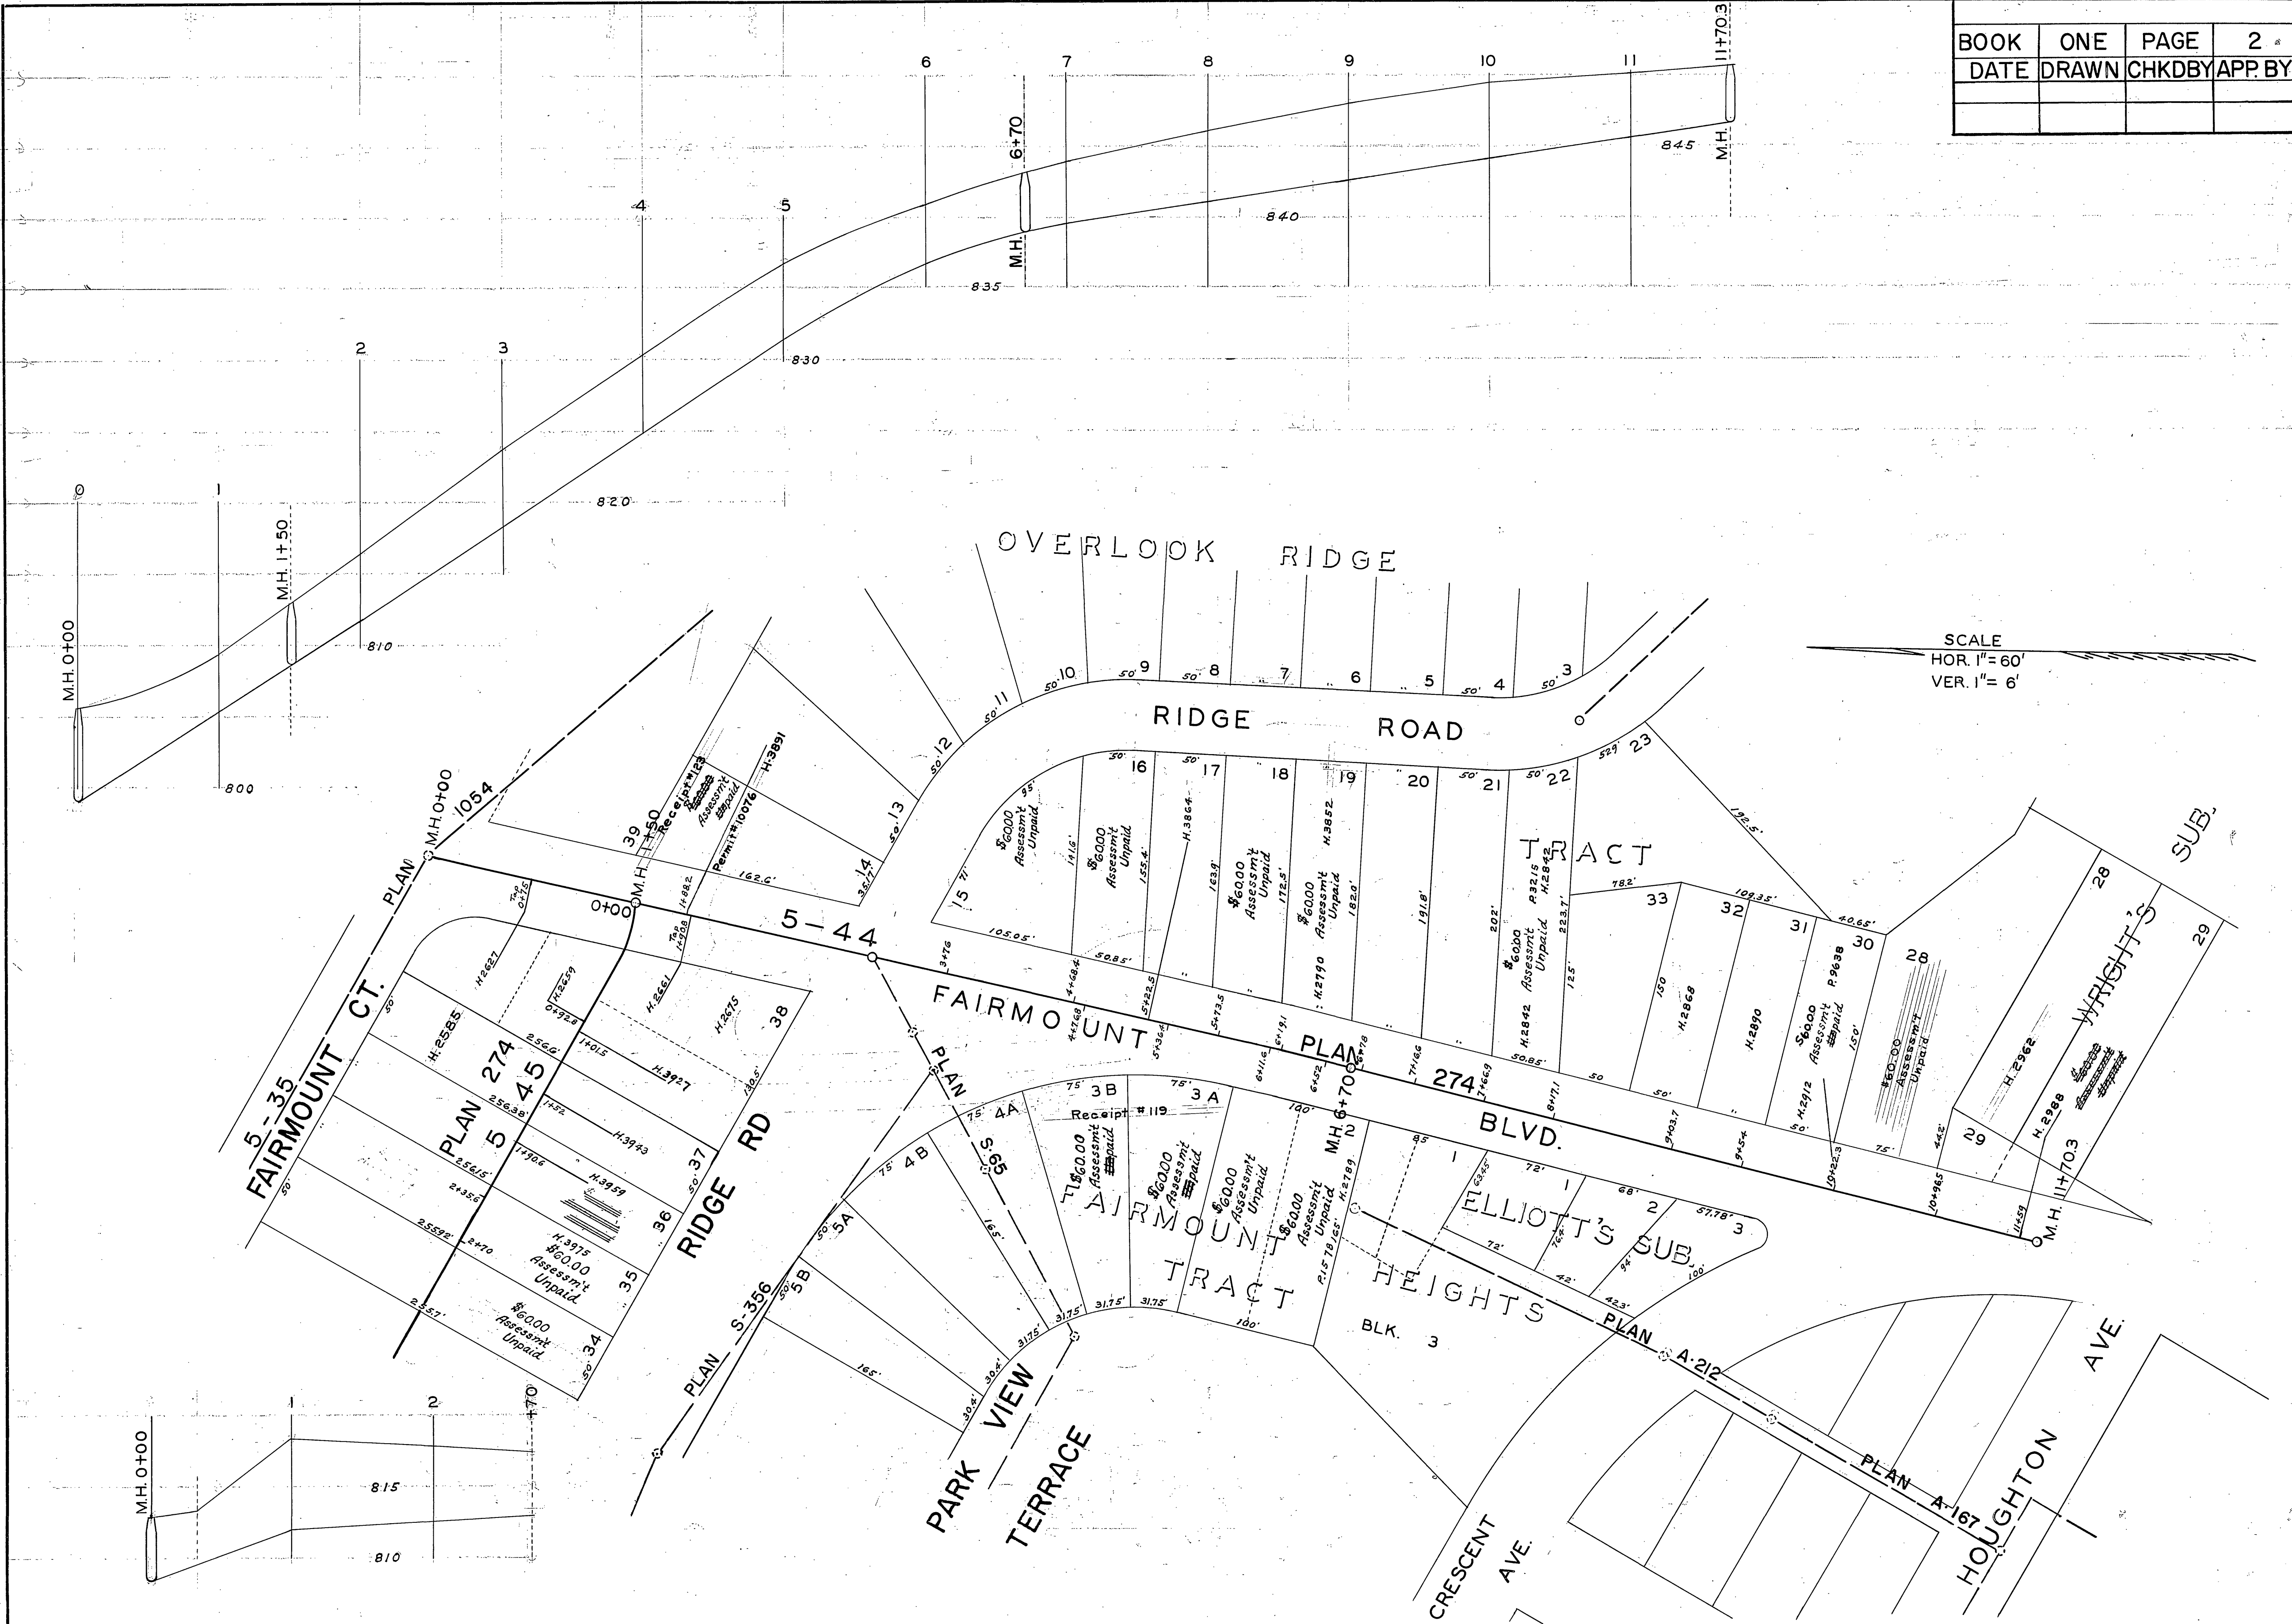

SCALE
 HOR. 1" = 60'
 VER. 1" = 6'