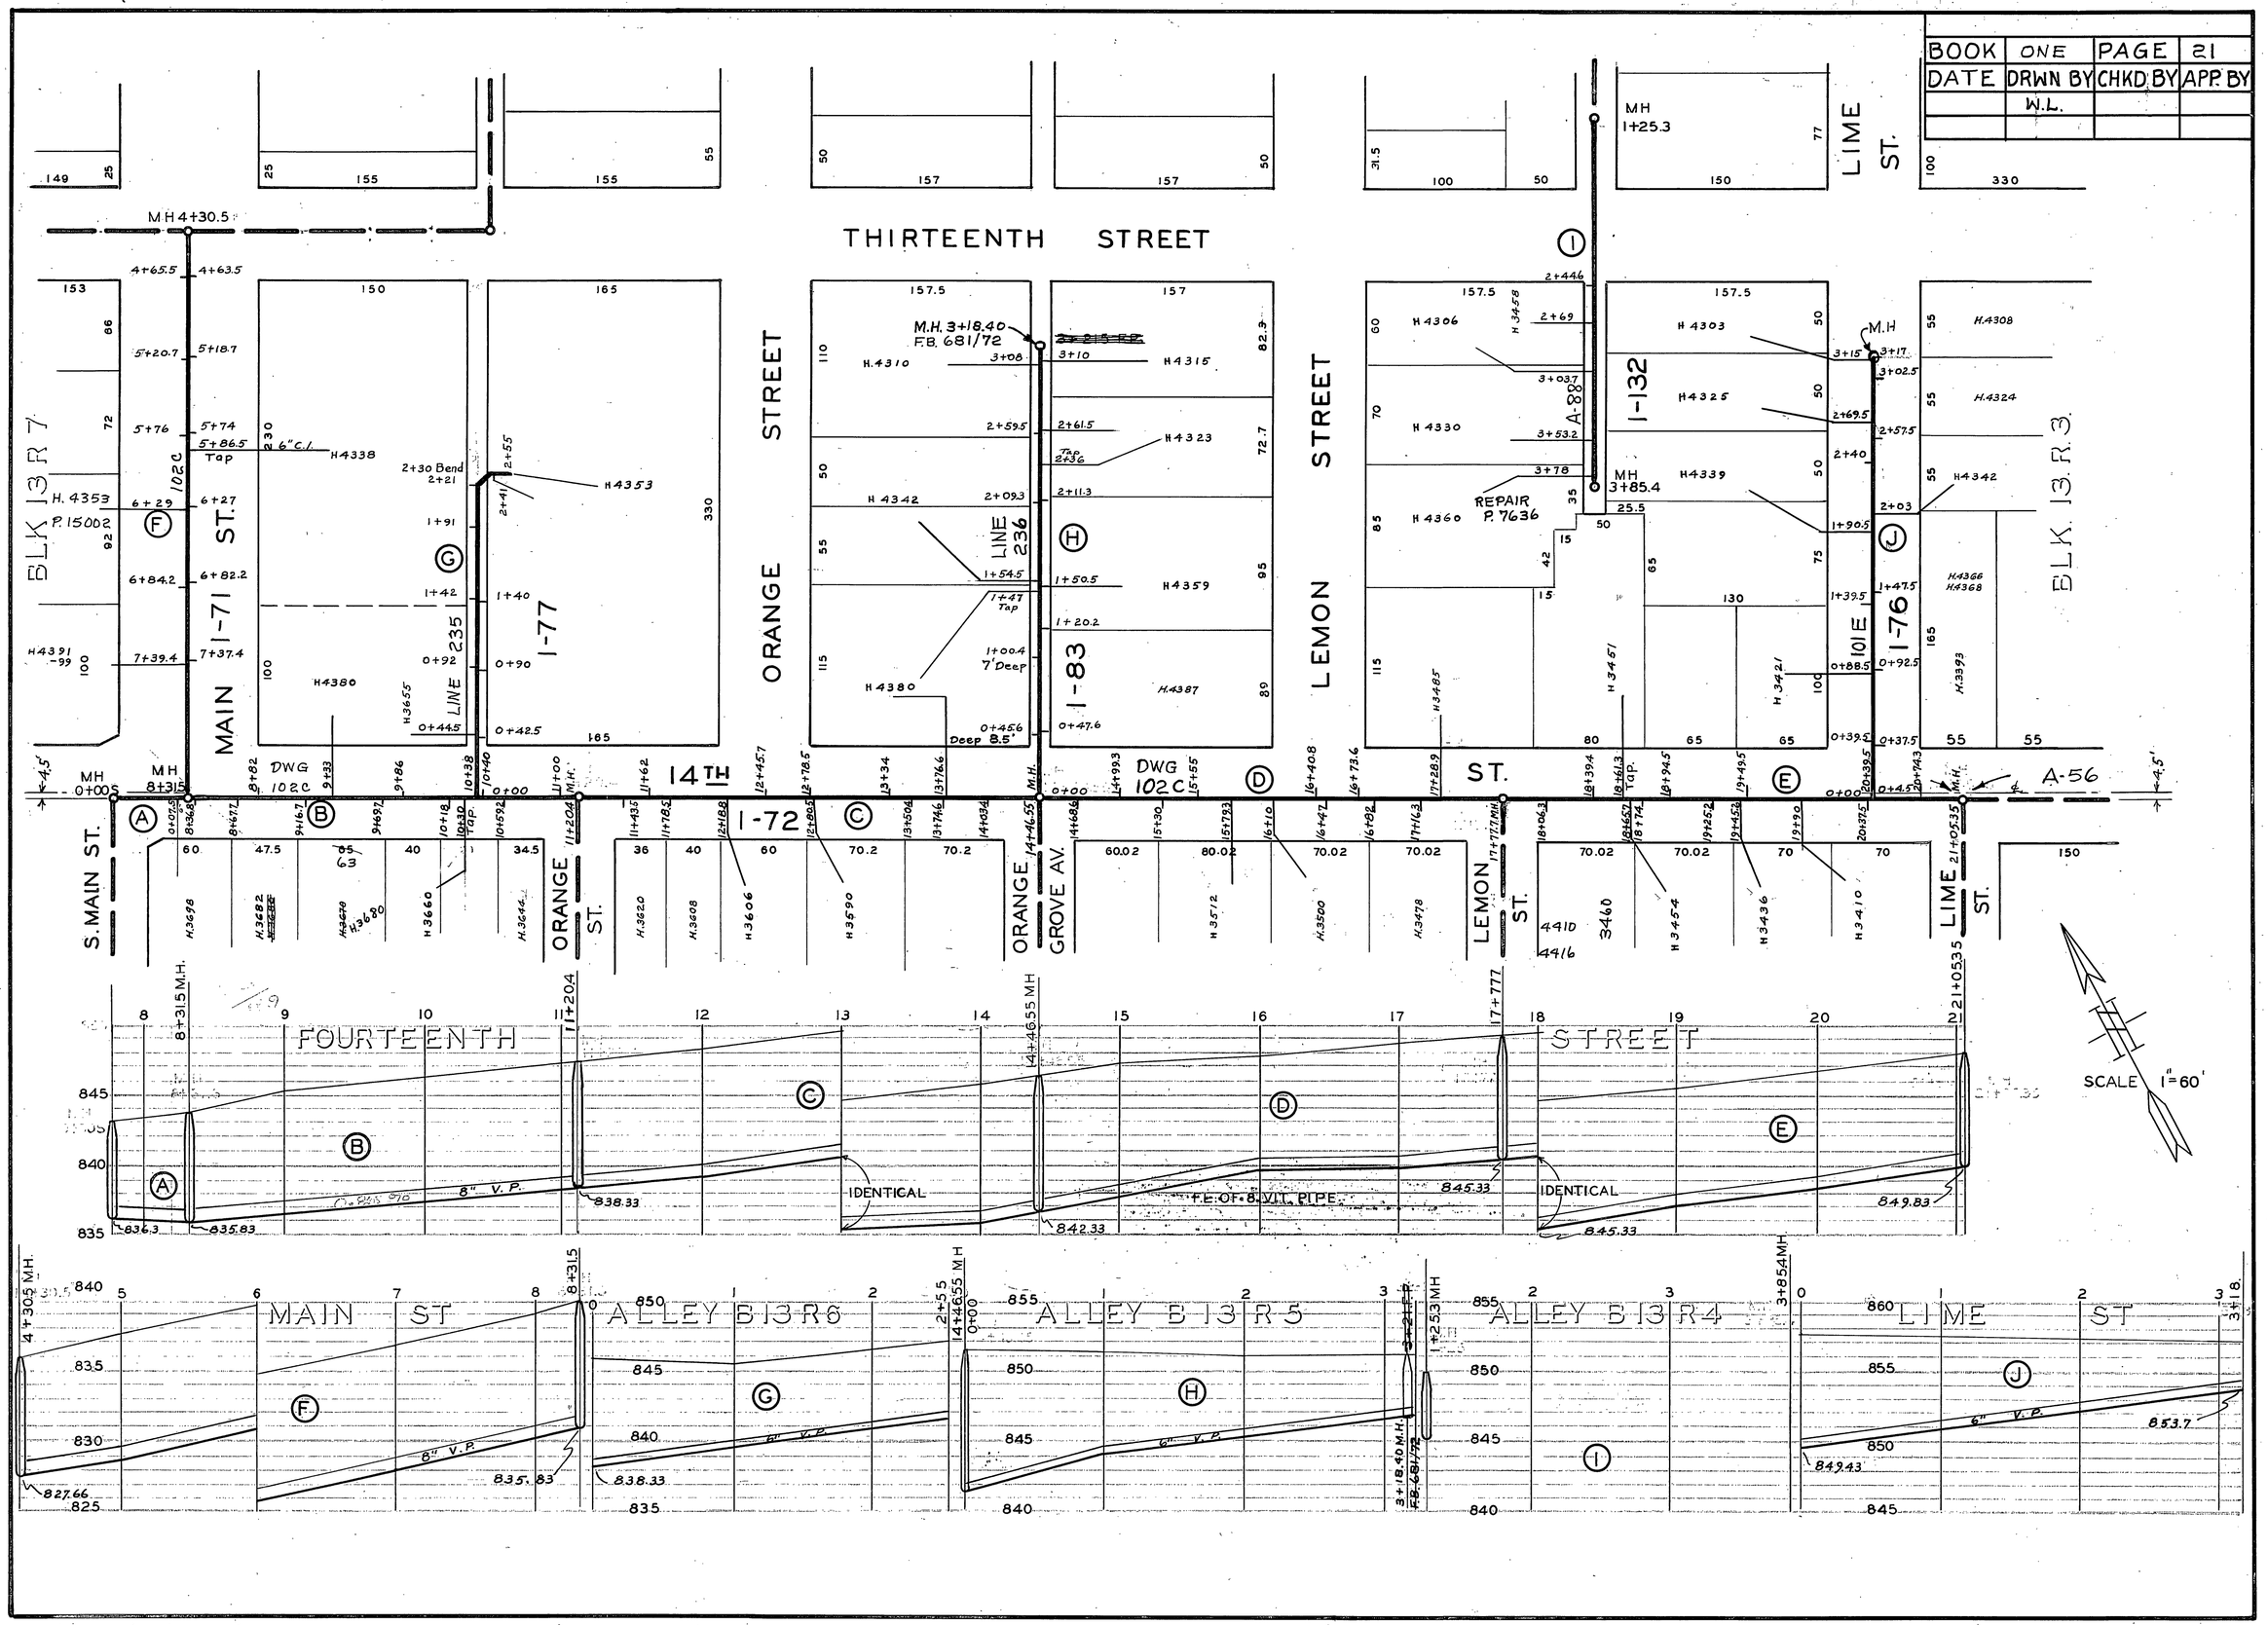BOOK	ONE	PAGE	21
DATE	DRWN BY	CHKD BY	APP. BY
	W.L.