111

BOOK	ONE	PAGE	32

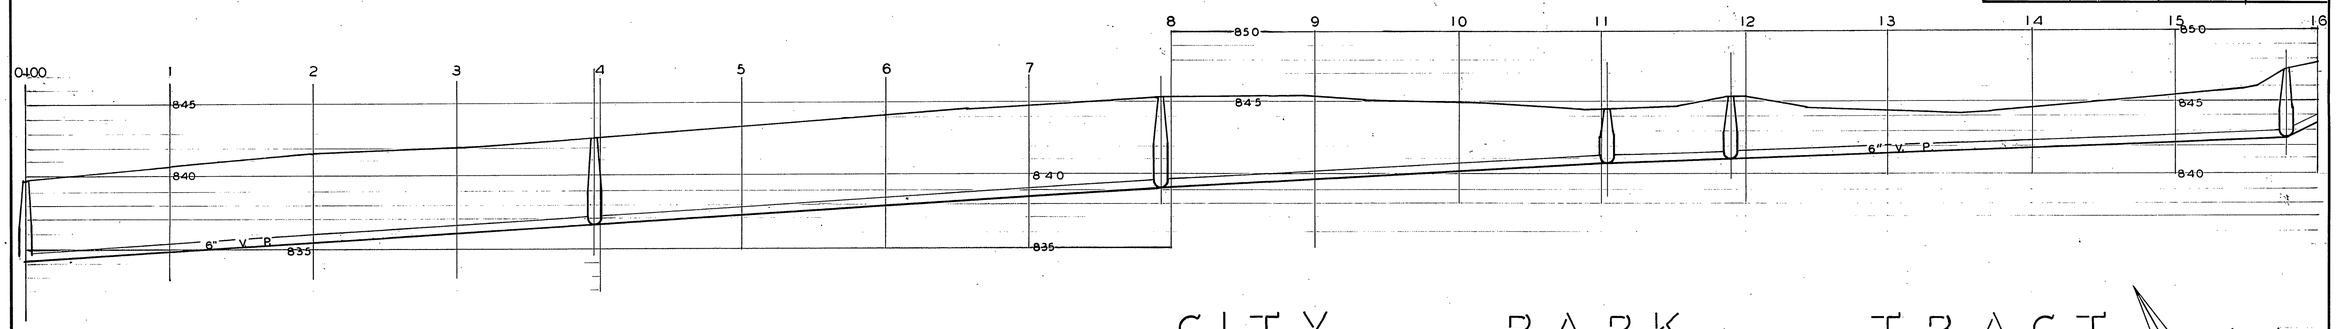

SEWER PROFILES
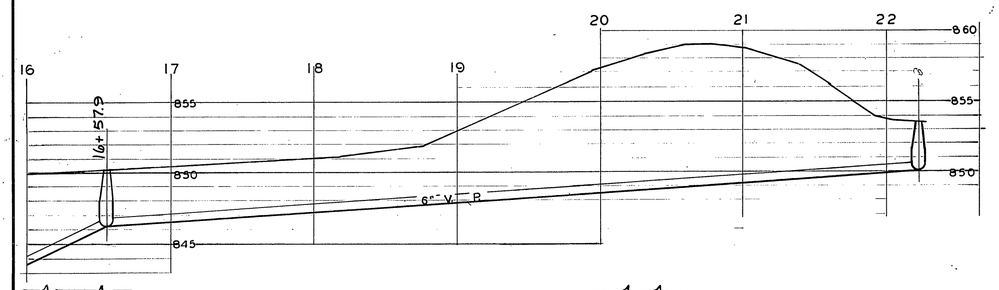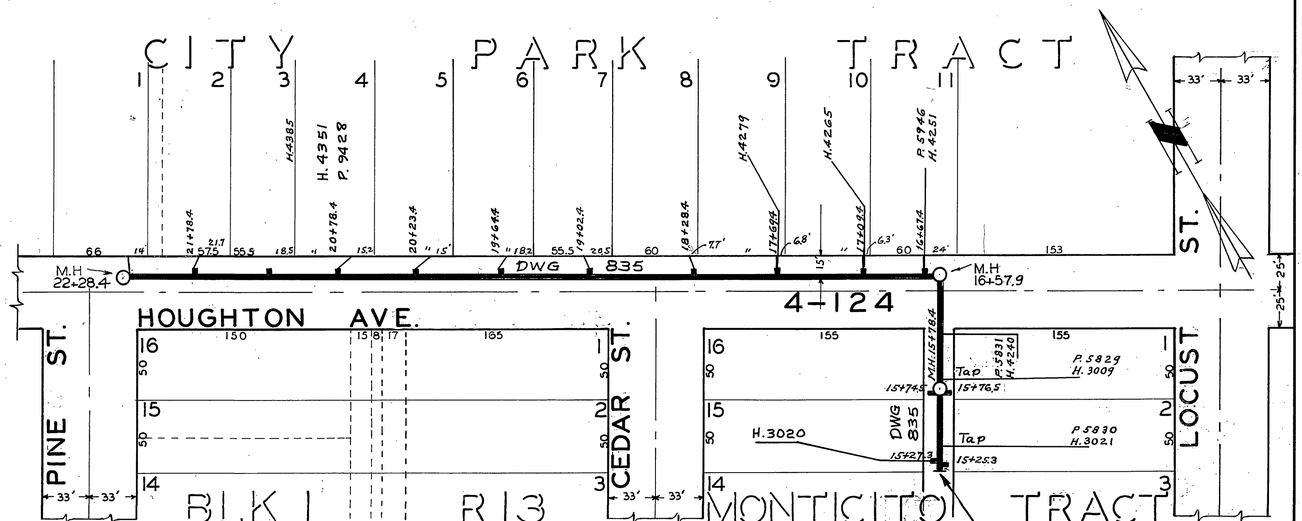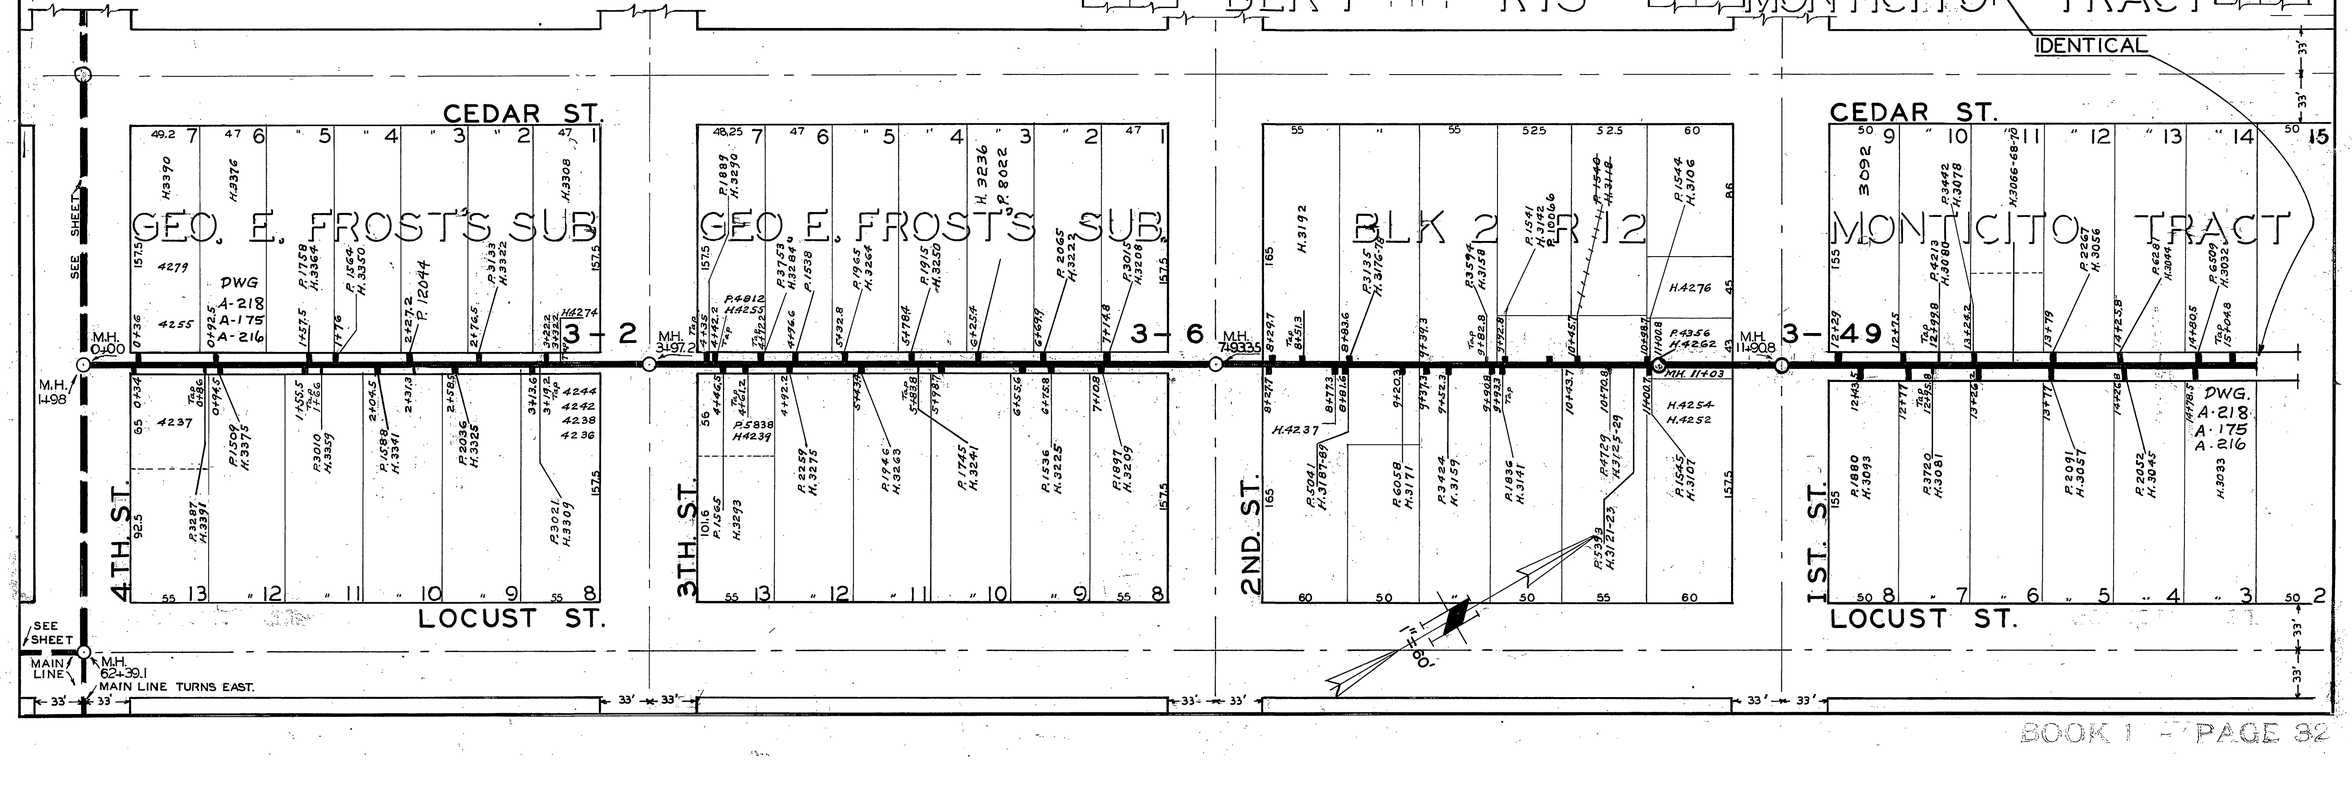
SCALE HOR. 1" = 60'
VER. 1" = 6'