


BOOK	ONE	PAGE	47

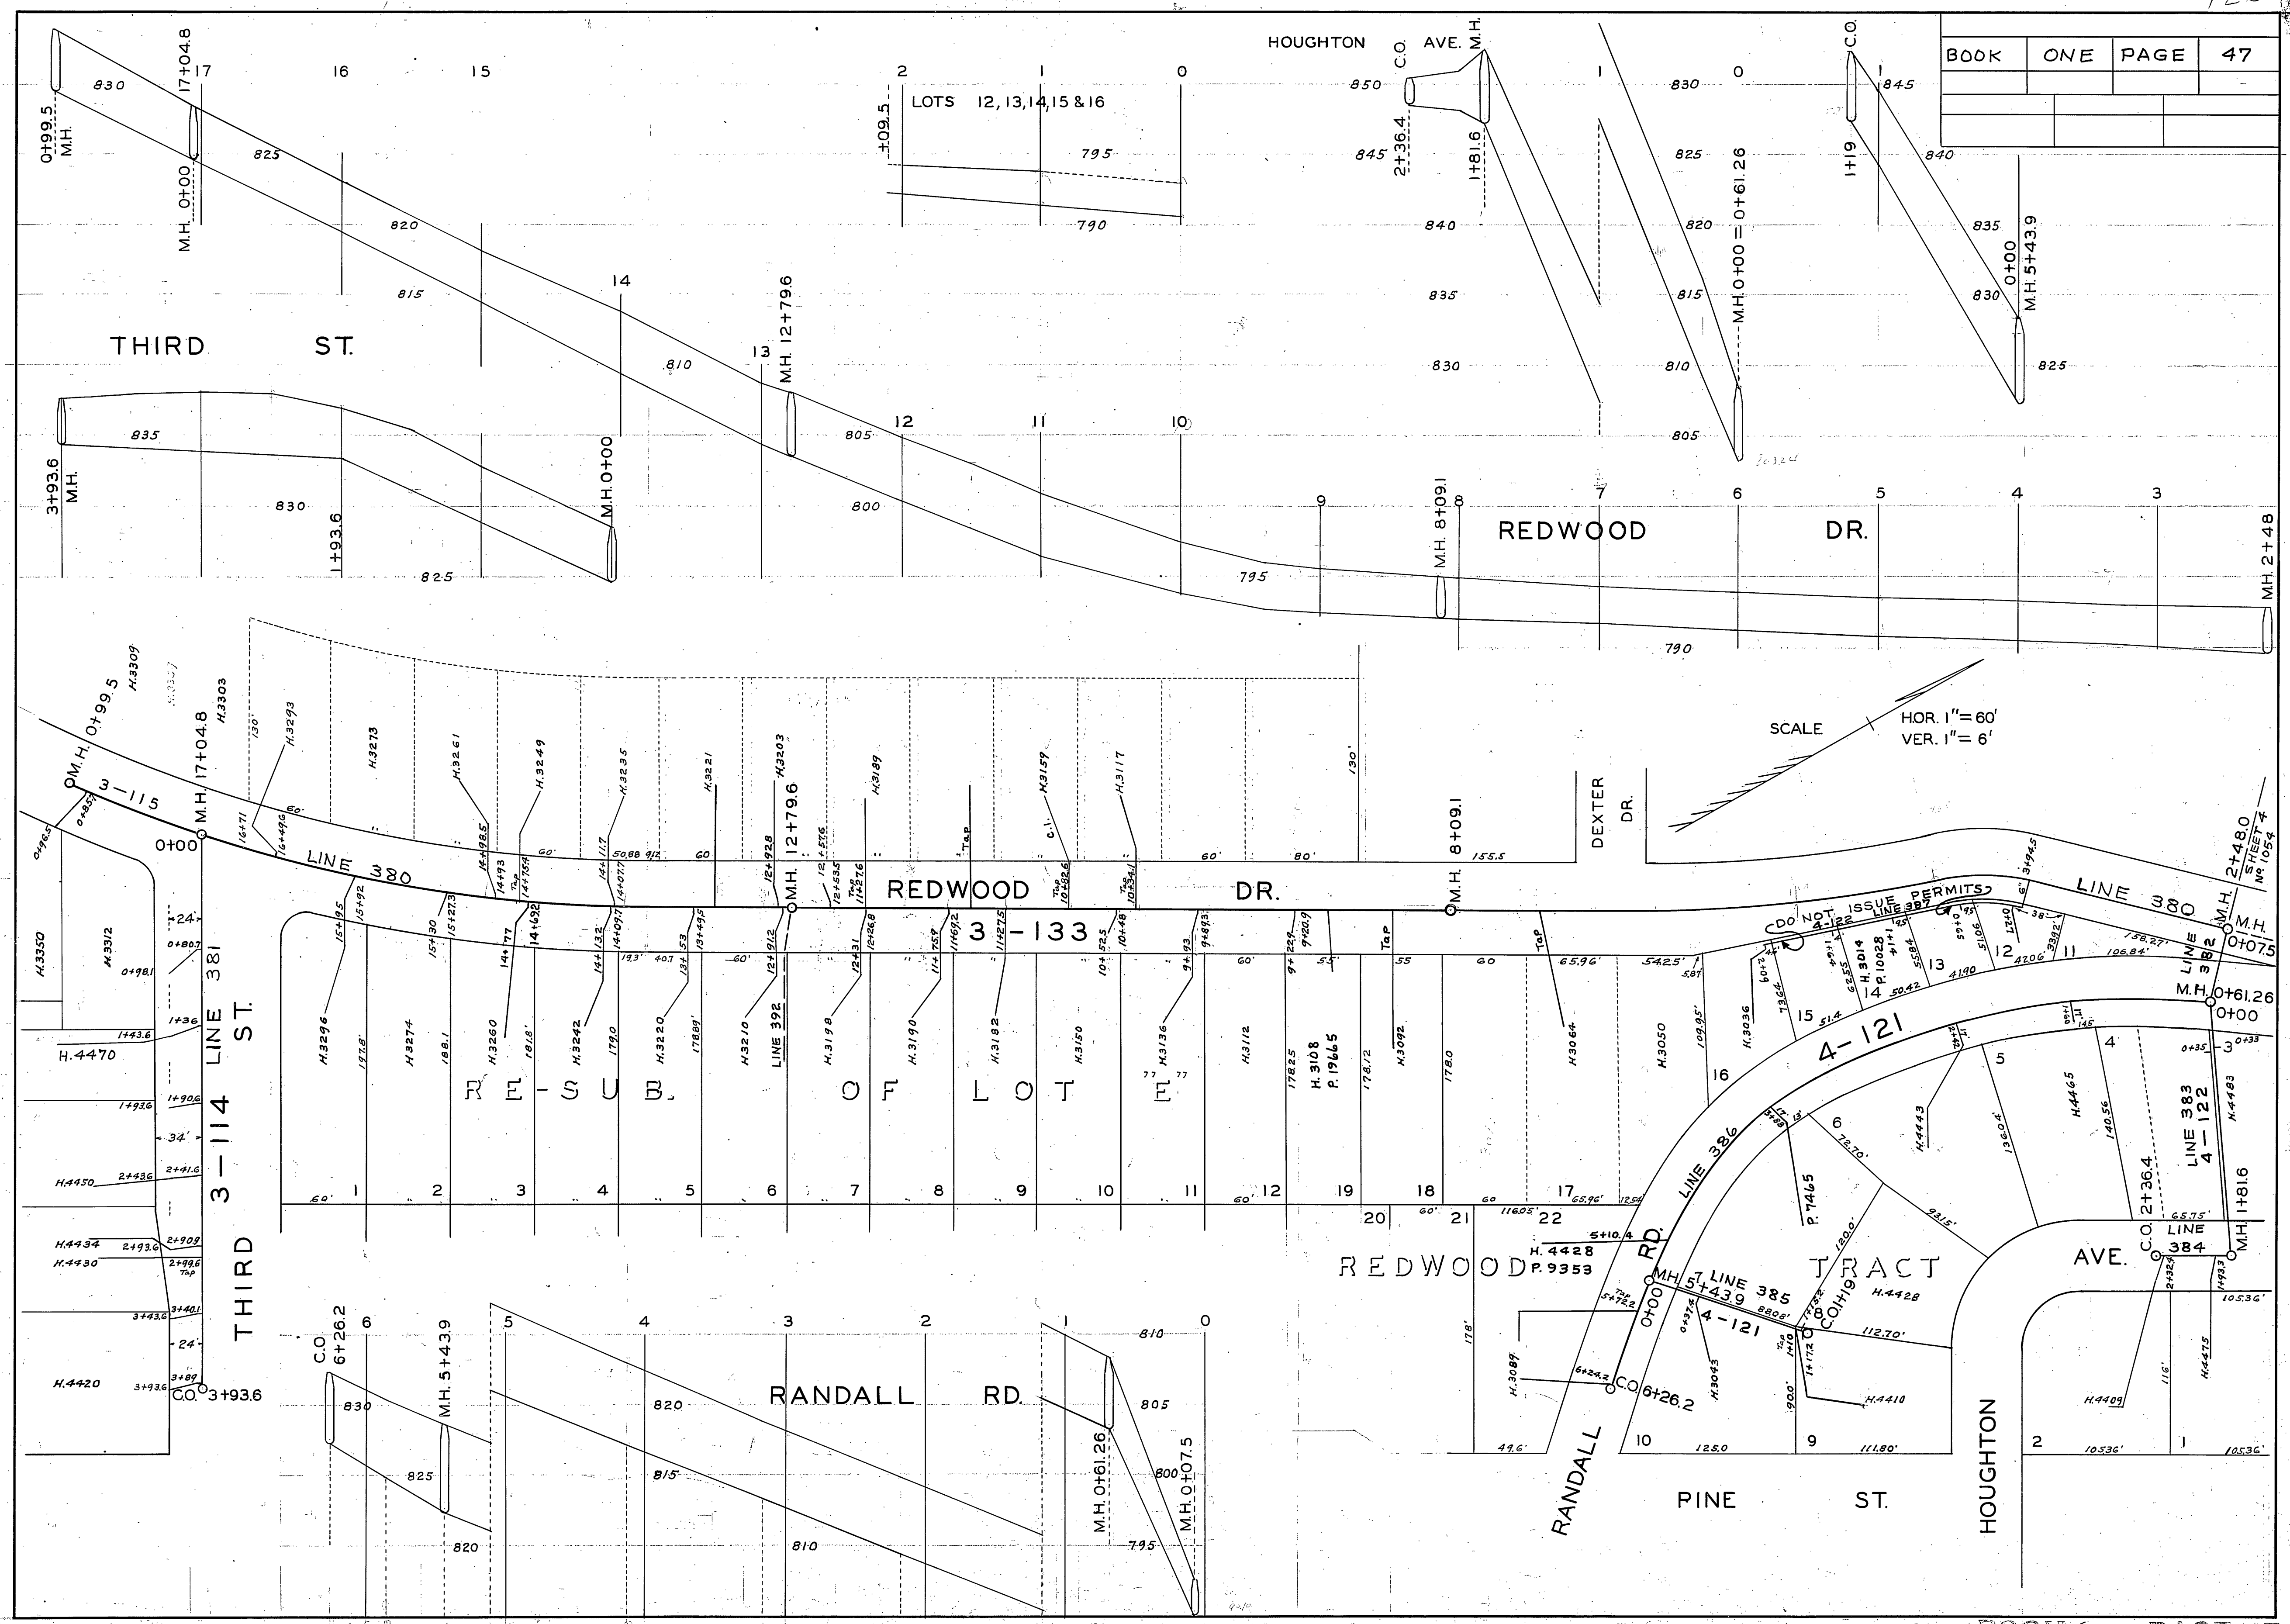

SCALE  
 HOR. 1" = 60'  
 VER. 1" = 6'

DO NOT ISSUE PERMITS  
 LINE 387