


BOOK	ONE	PAGE	49

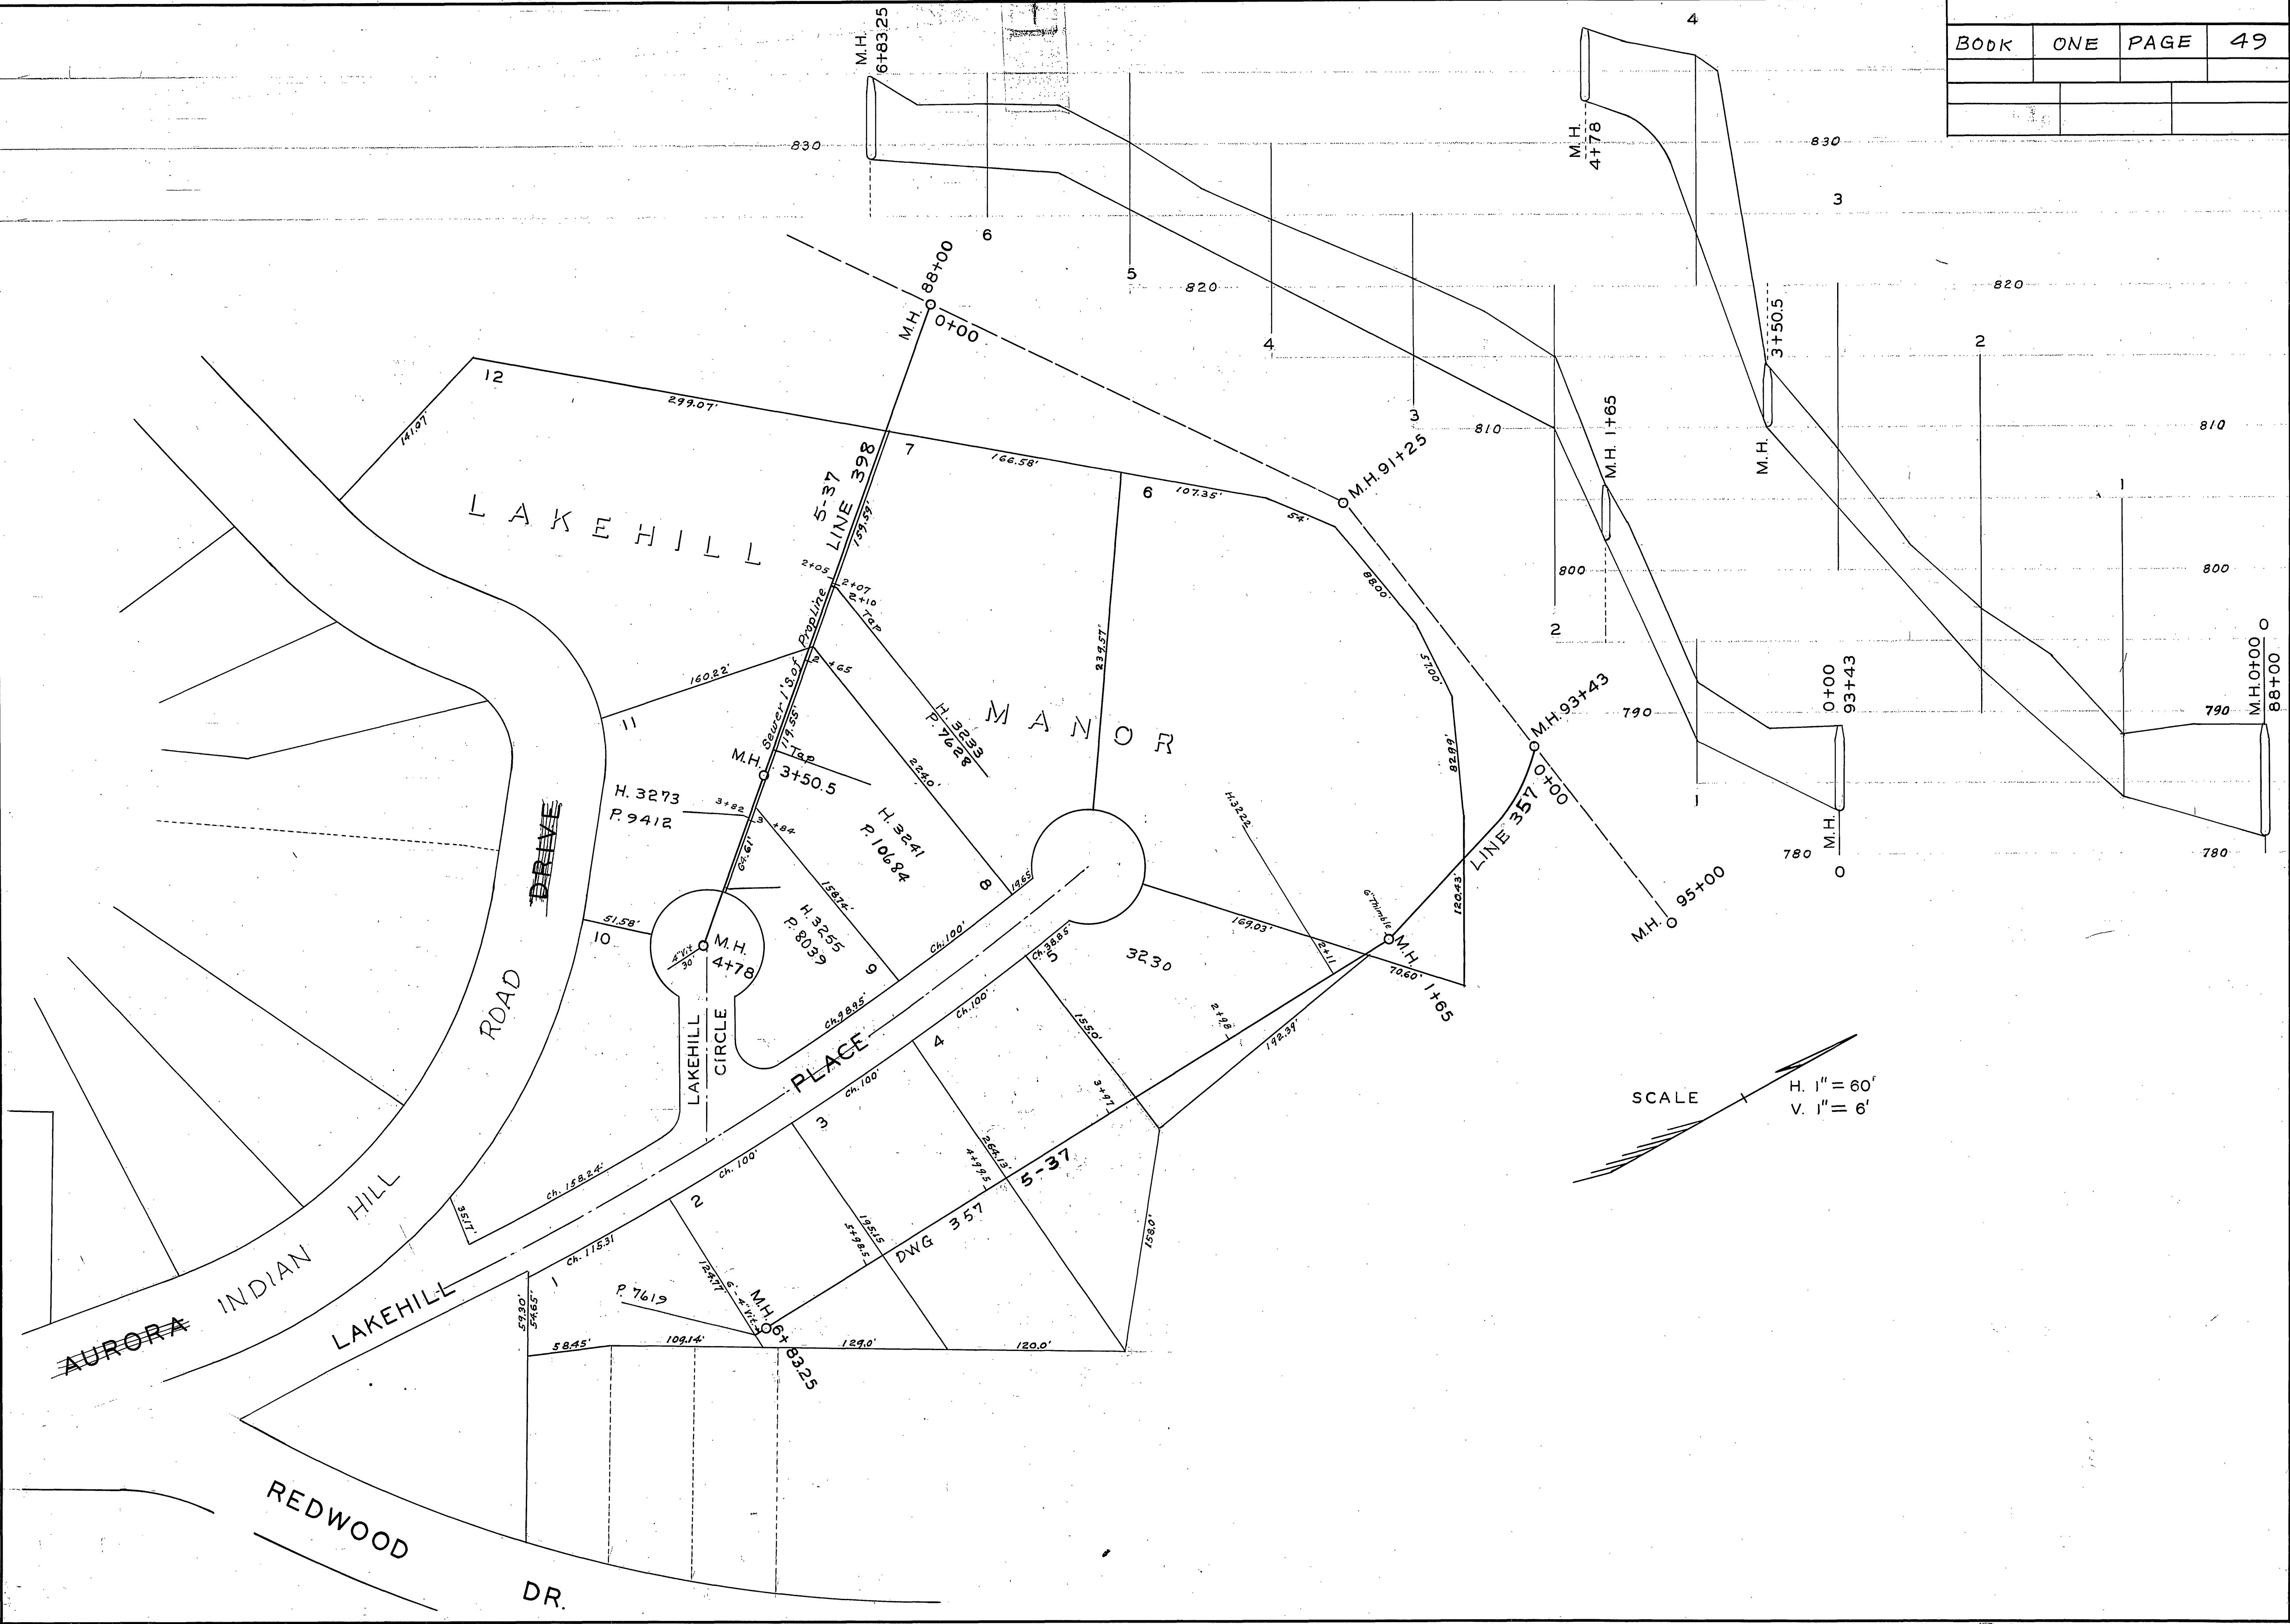

SCALE
 H. 1" = 60'
 V. 1" = 6'