

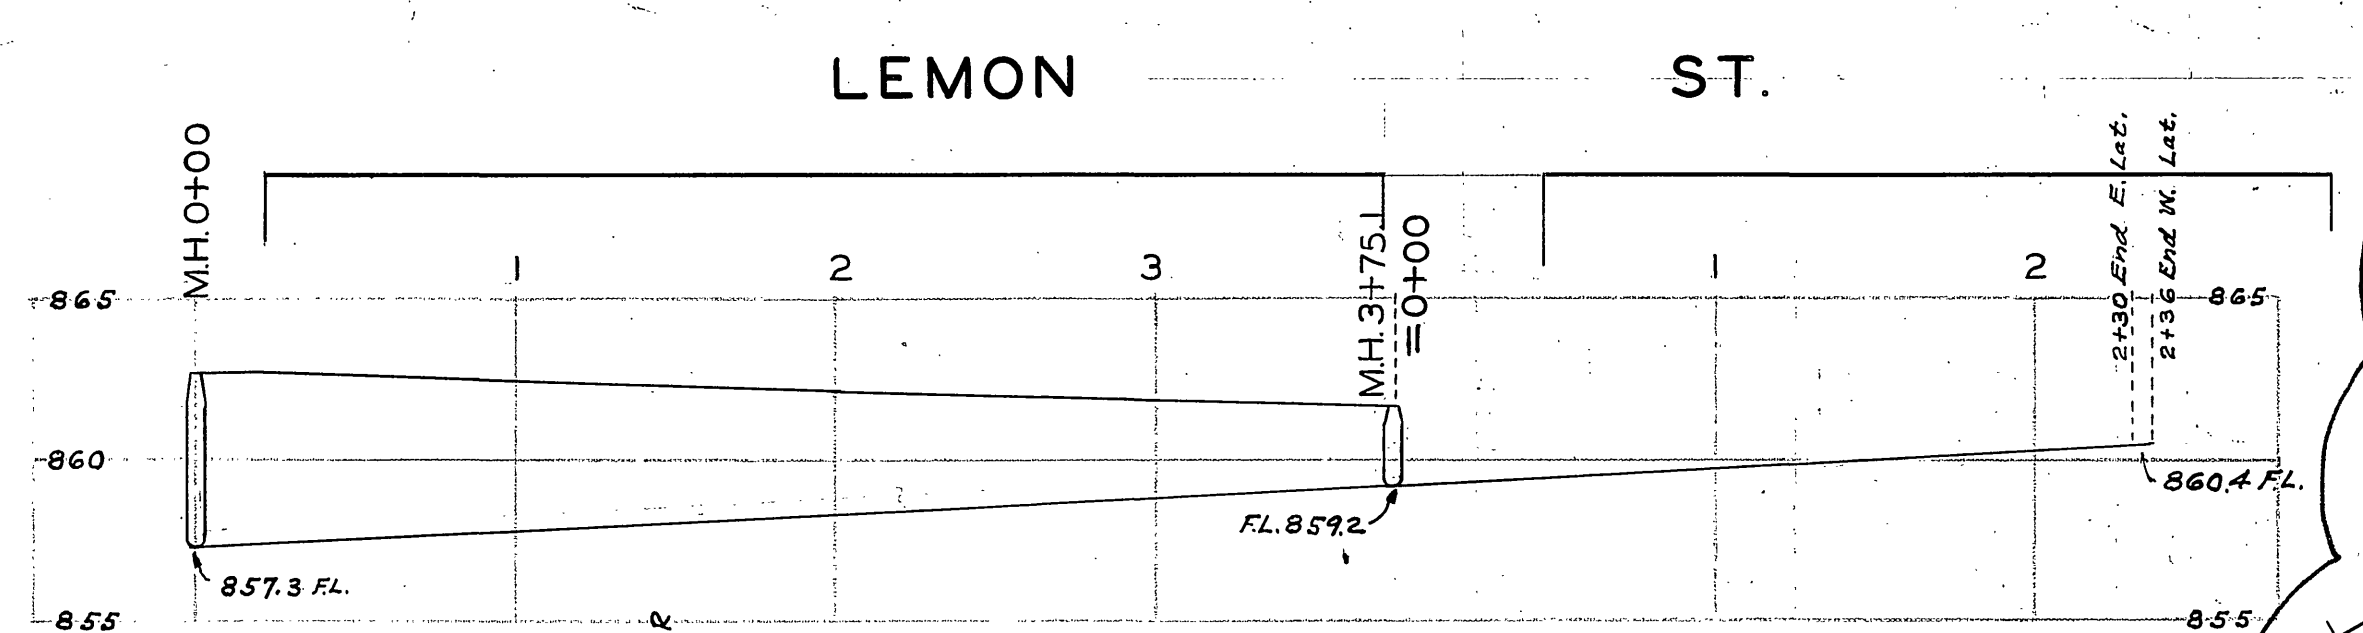
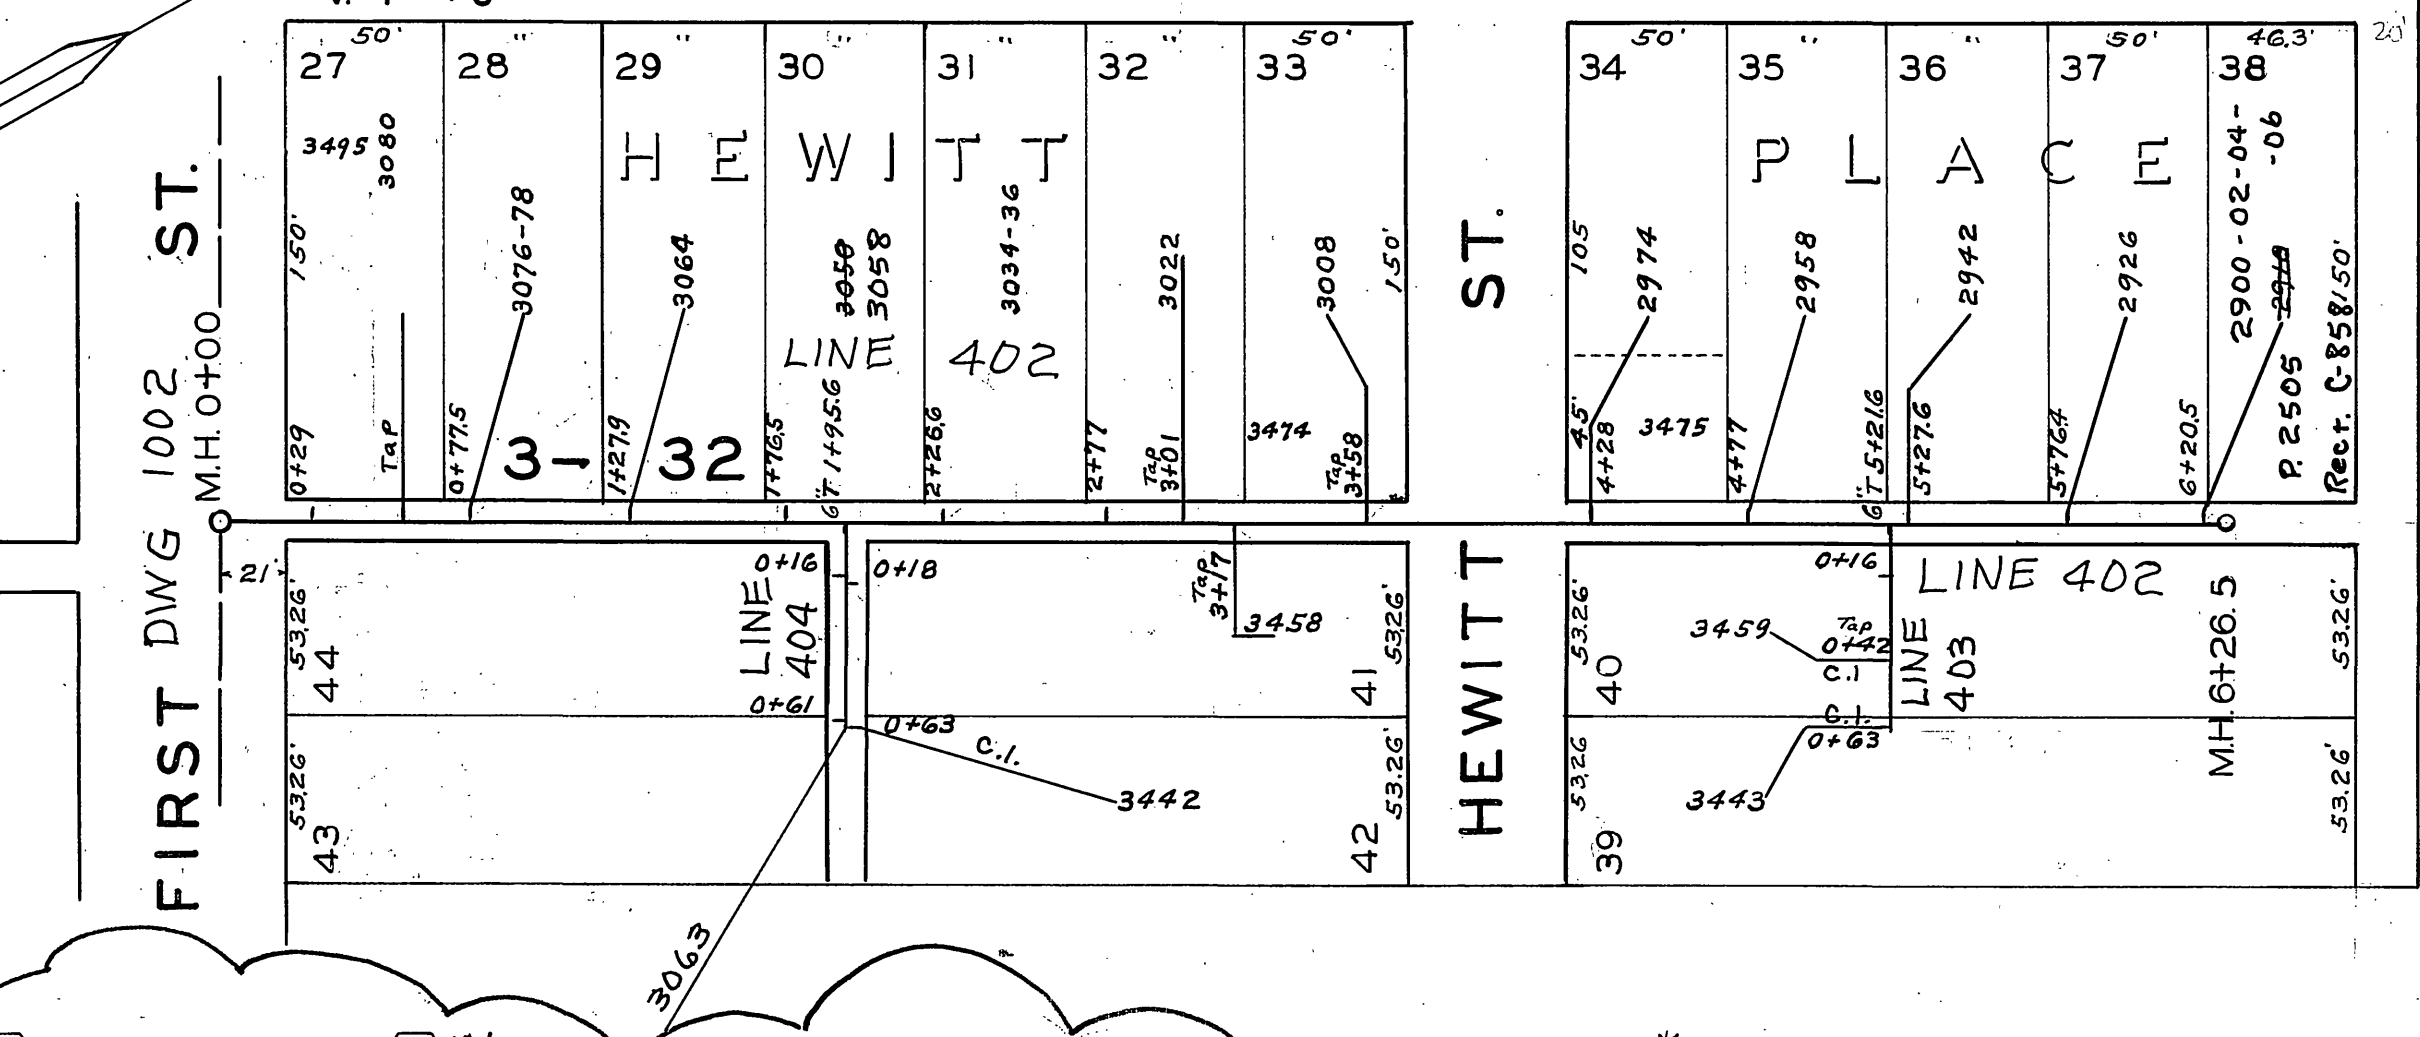
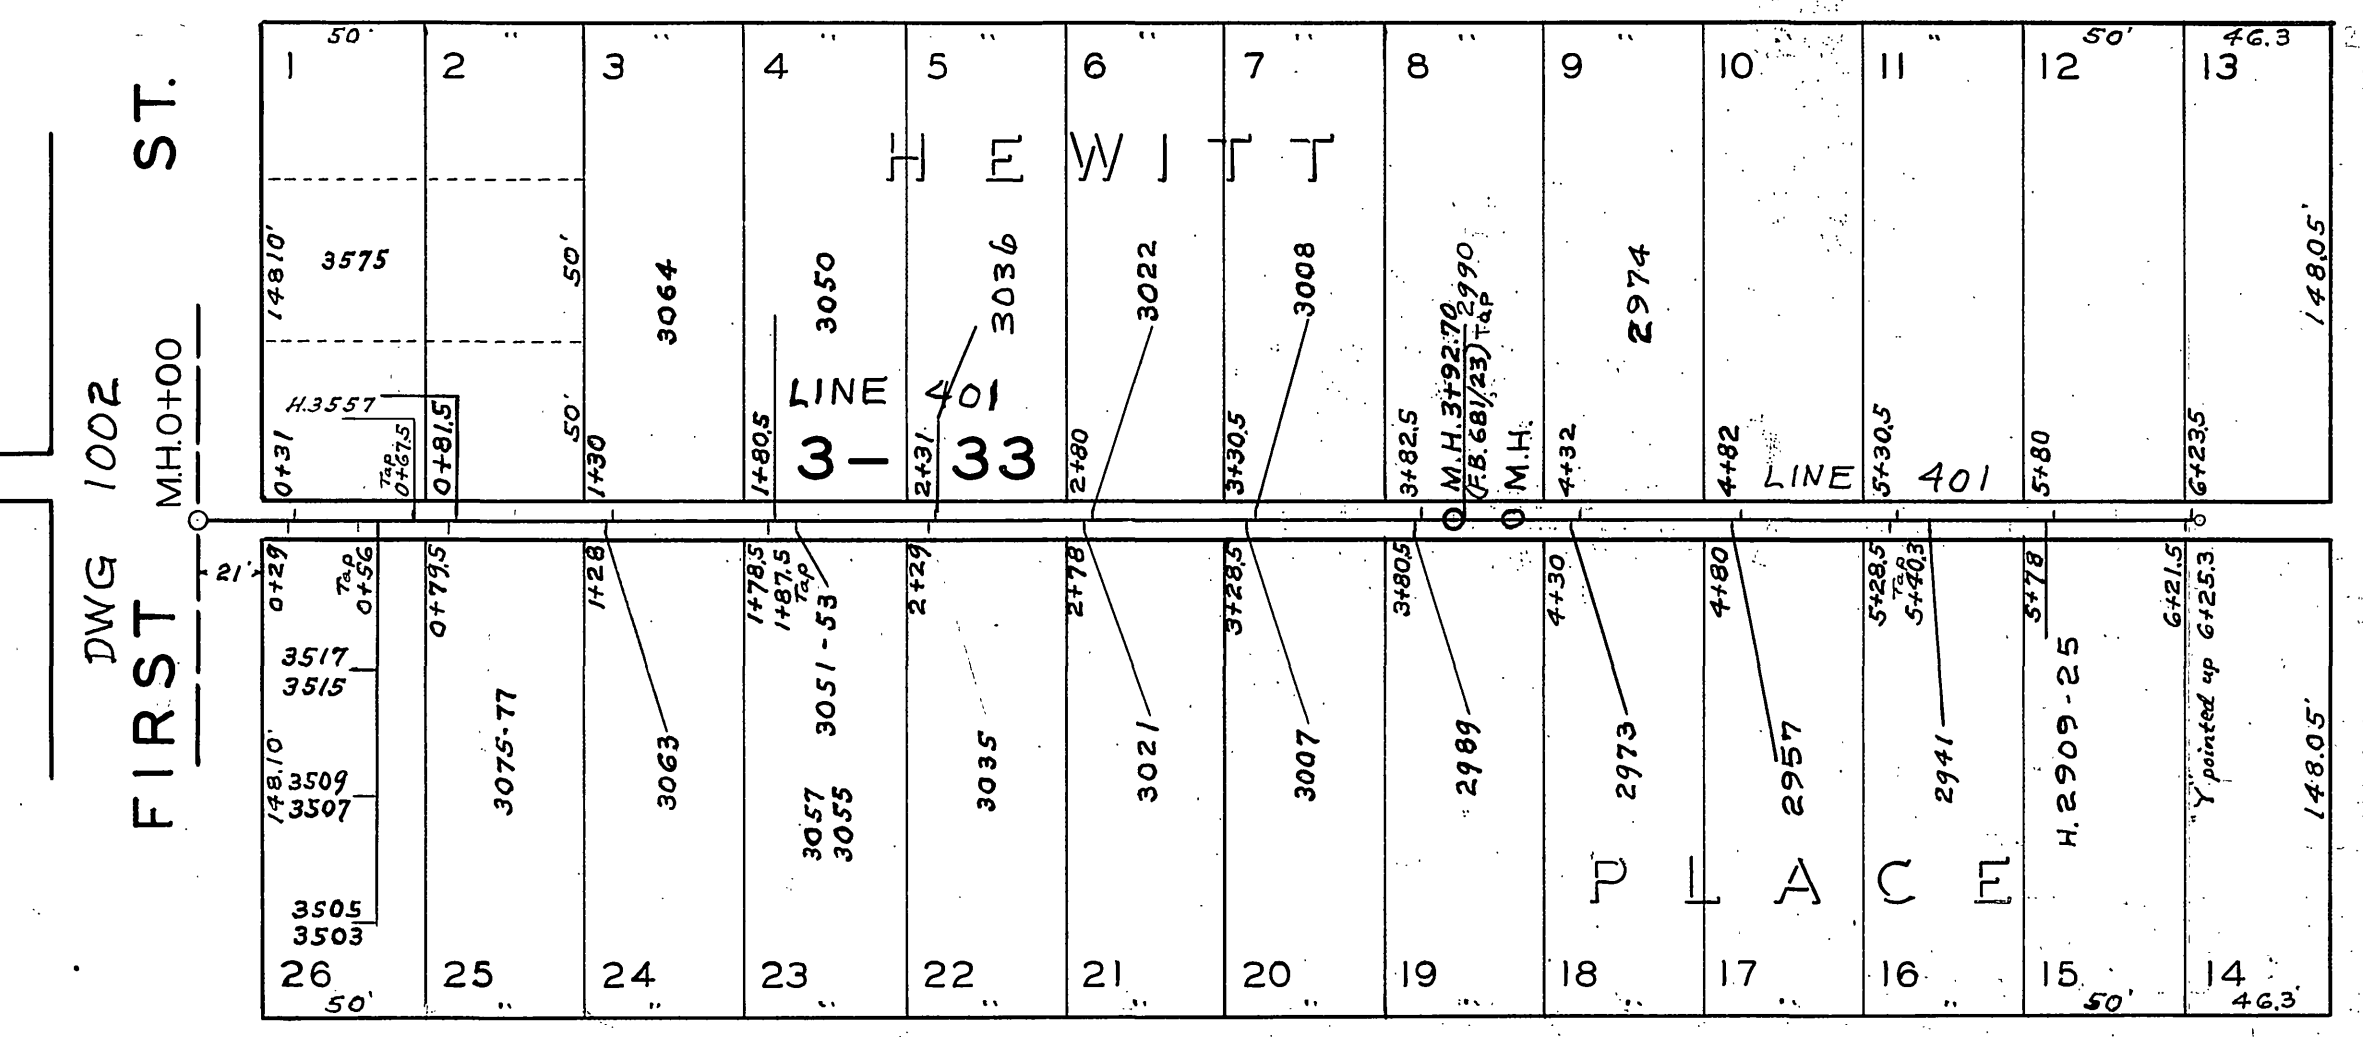


ORANGE ST.

LEMON ST.

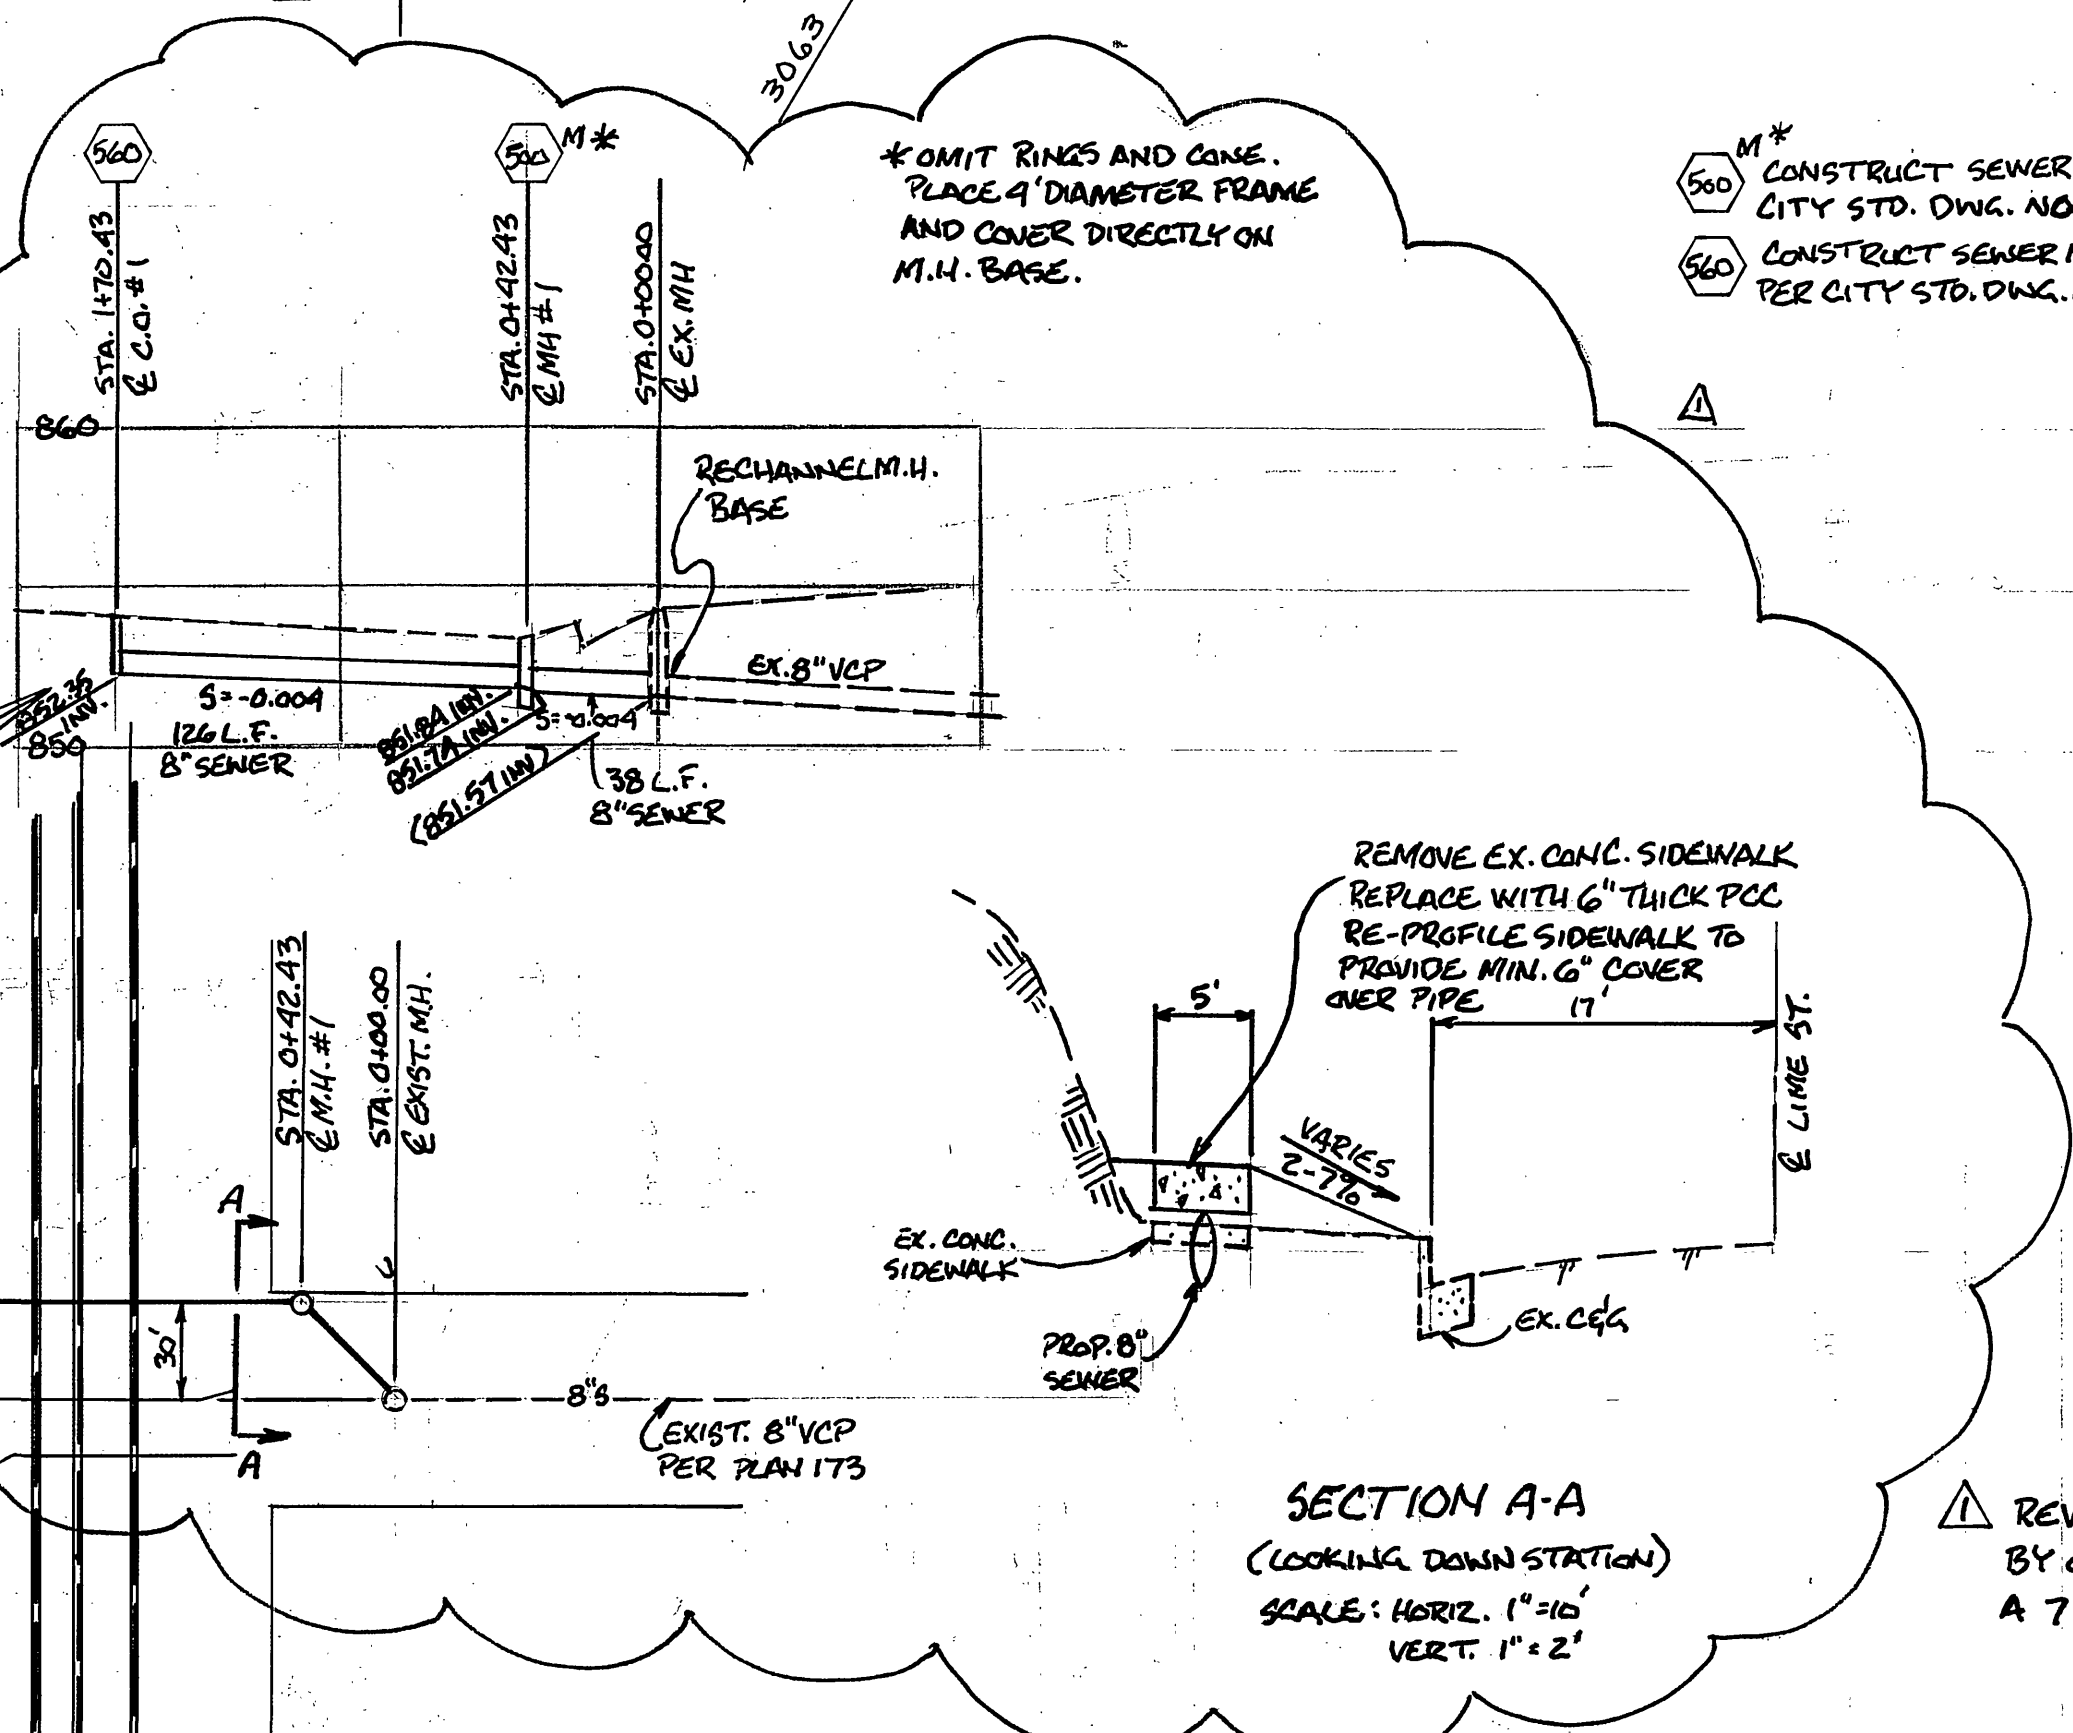

LEMON ST.

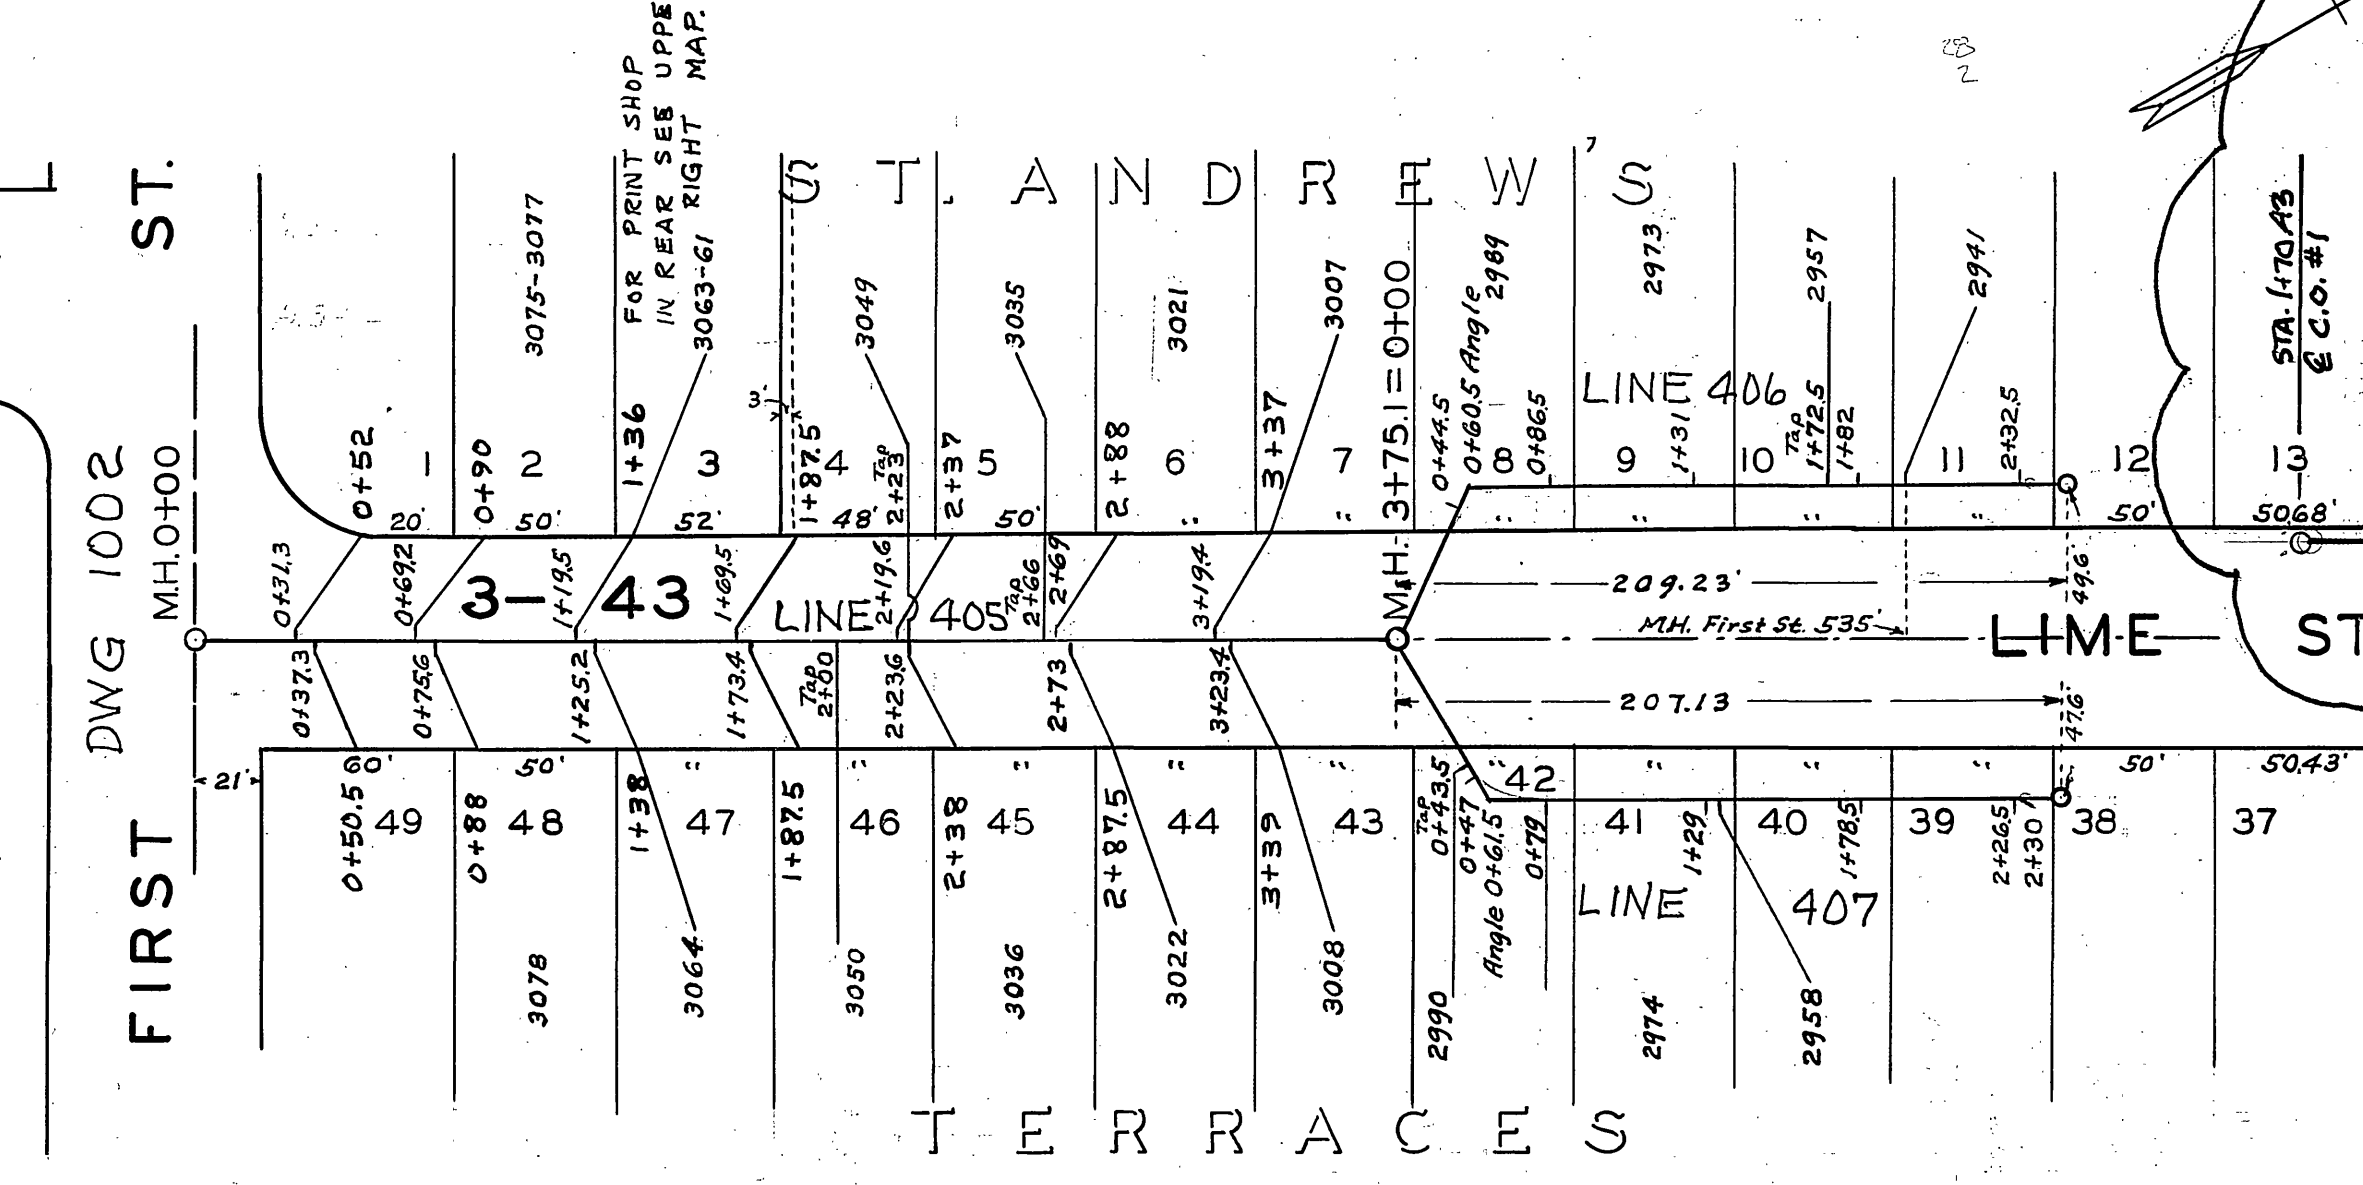

SECTION A-A
(LOOKING DOWN STATION)
SCALE: HORIZ. 1"=10'
VERT. 1"=2'

△ REVISIONS PREPARED BY CITY STAFF AS A 7% JOB