


BOOK	TWO-A	PAGE	2-A
------	-------	------	-----

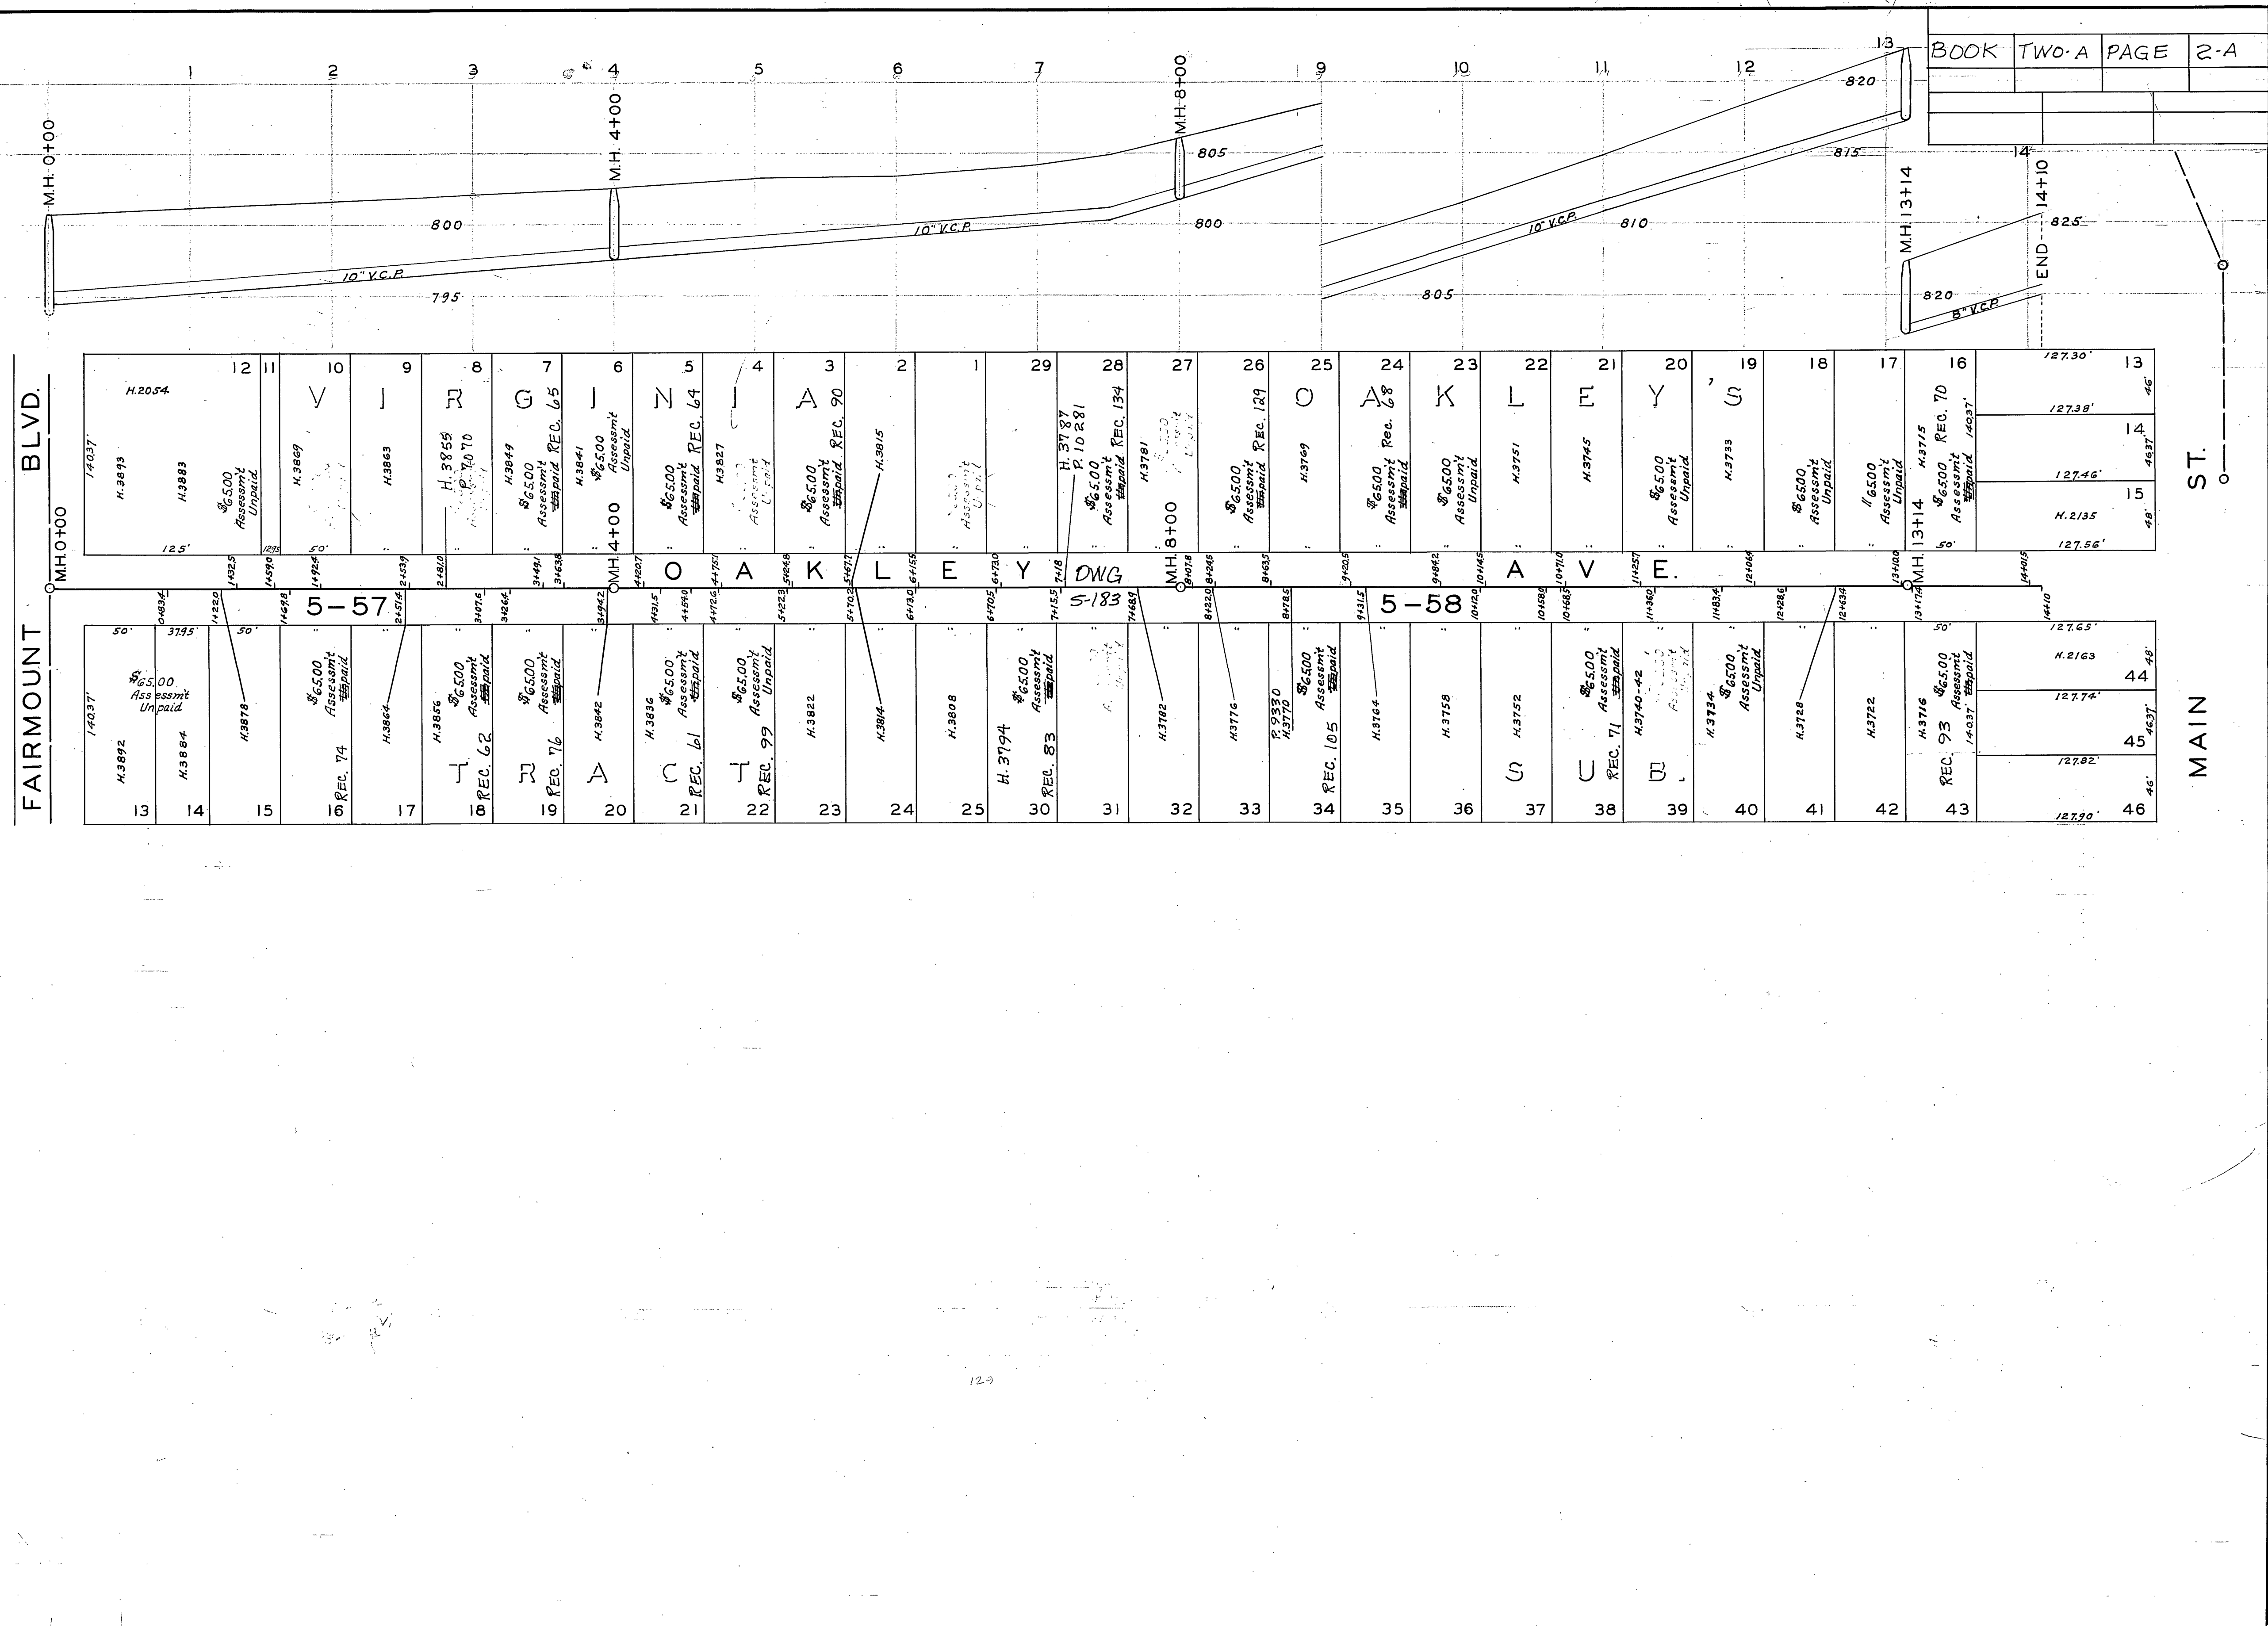

FAIRMOUNT BLVD.

ST. MAIN

13	14	15	16	17	18	19	20	21	22	23	24	25	26	27	28	29	30	31	32	33	34	35	36	37	38	39	40	41	42	43	44	45	46
H. 3892	H. 3884	H. 3878	REC. 74	H. 3864	H. 3856	REC. 62	REC. 76	A	REC. 99	H. 3822	H. 3814	H. 3808	H. 3794	REC. 83	H. 3782	H. 3776	REC. 105	H. 3764	H. 3758	H. 3752	REC. 71	REC. 42	H. 3734	H. 3728	H. 3722	REC. 93	H. 3716	H. 3710	H. 3704	H. 3698	H. 3692	H. 3686	


2-A signed