


BOOK	TWO	PAGE	16

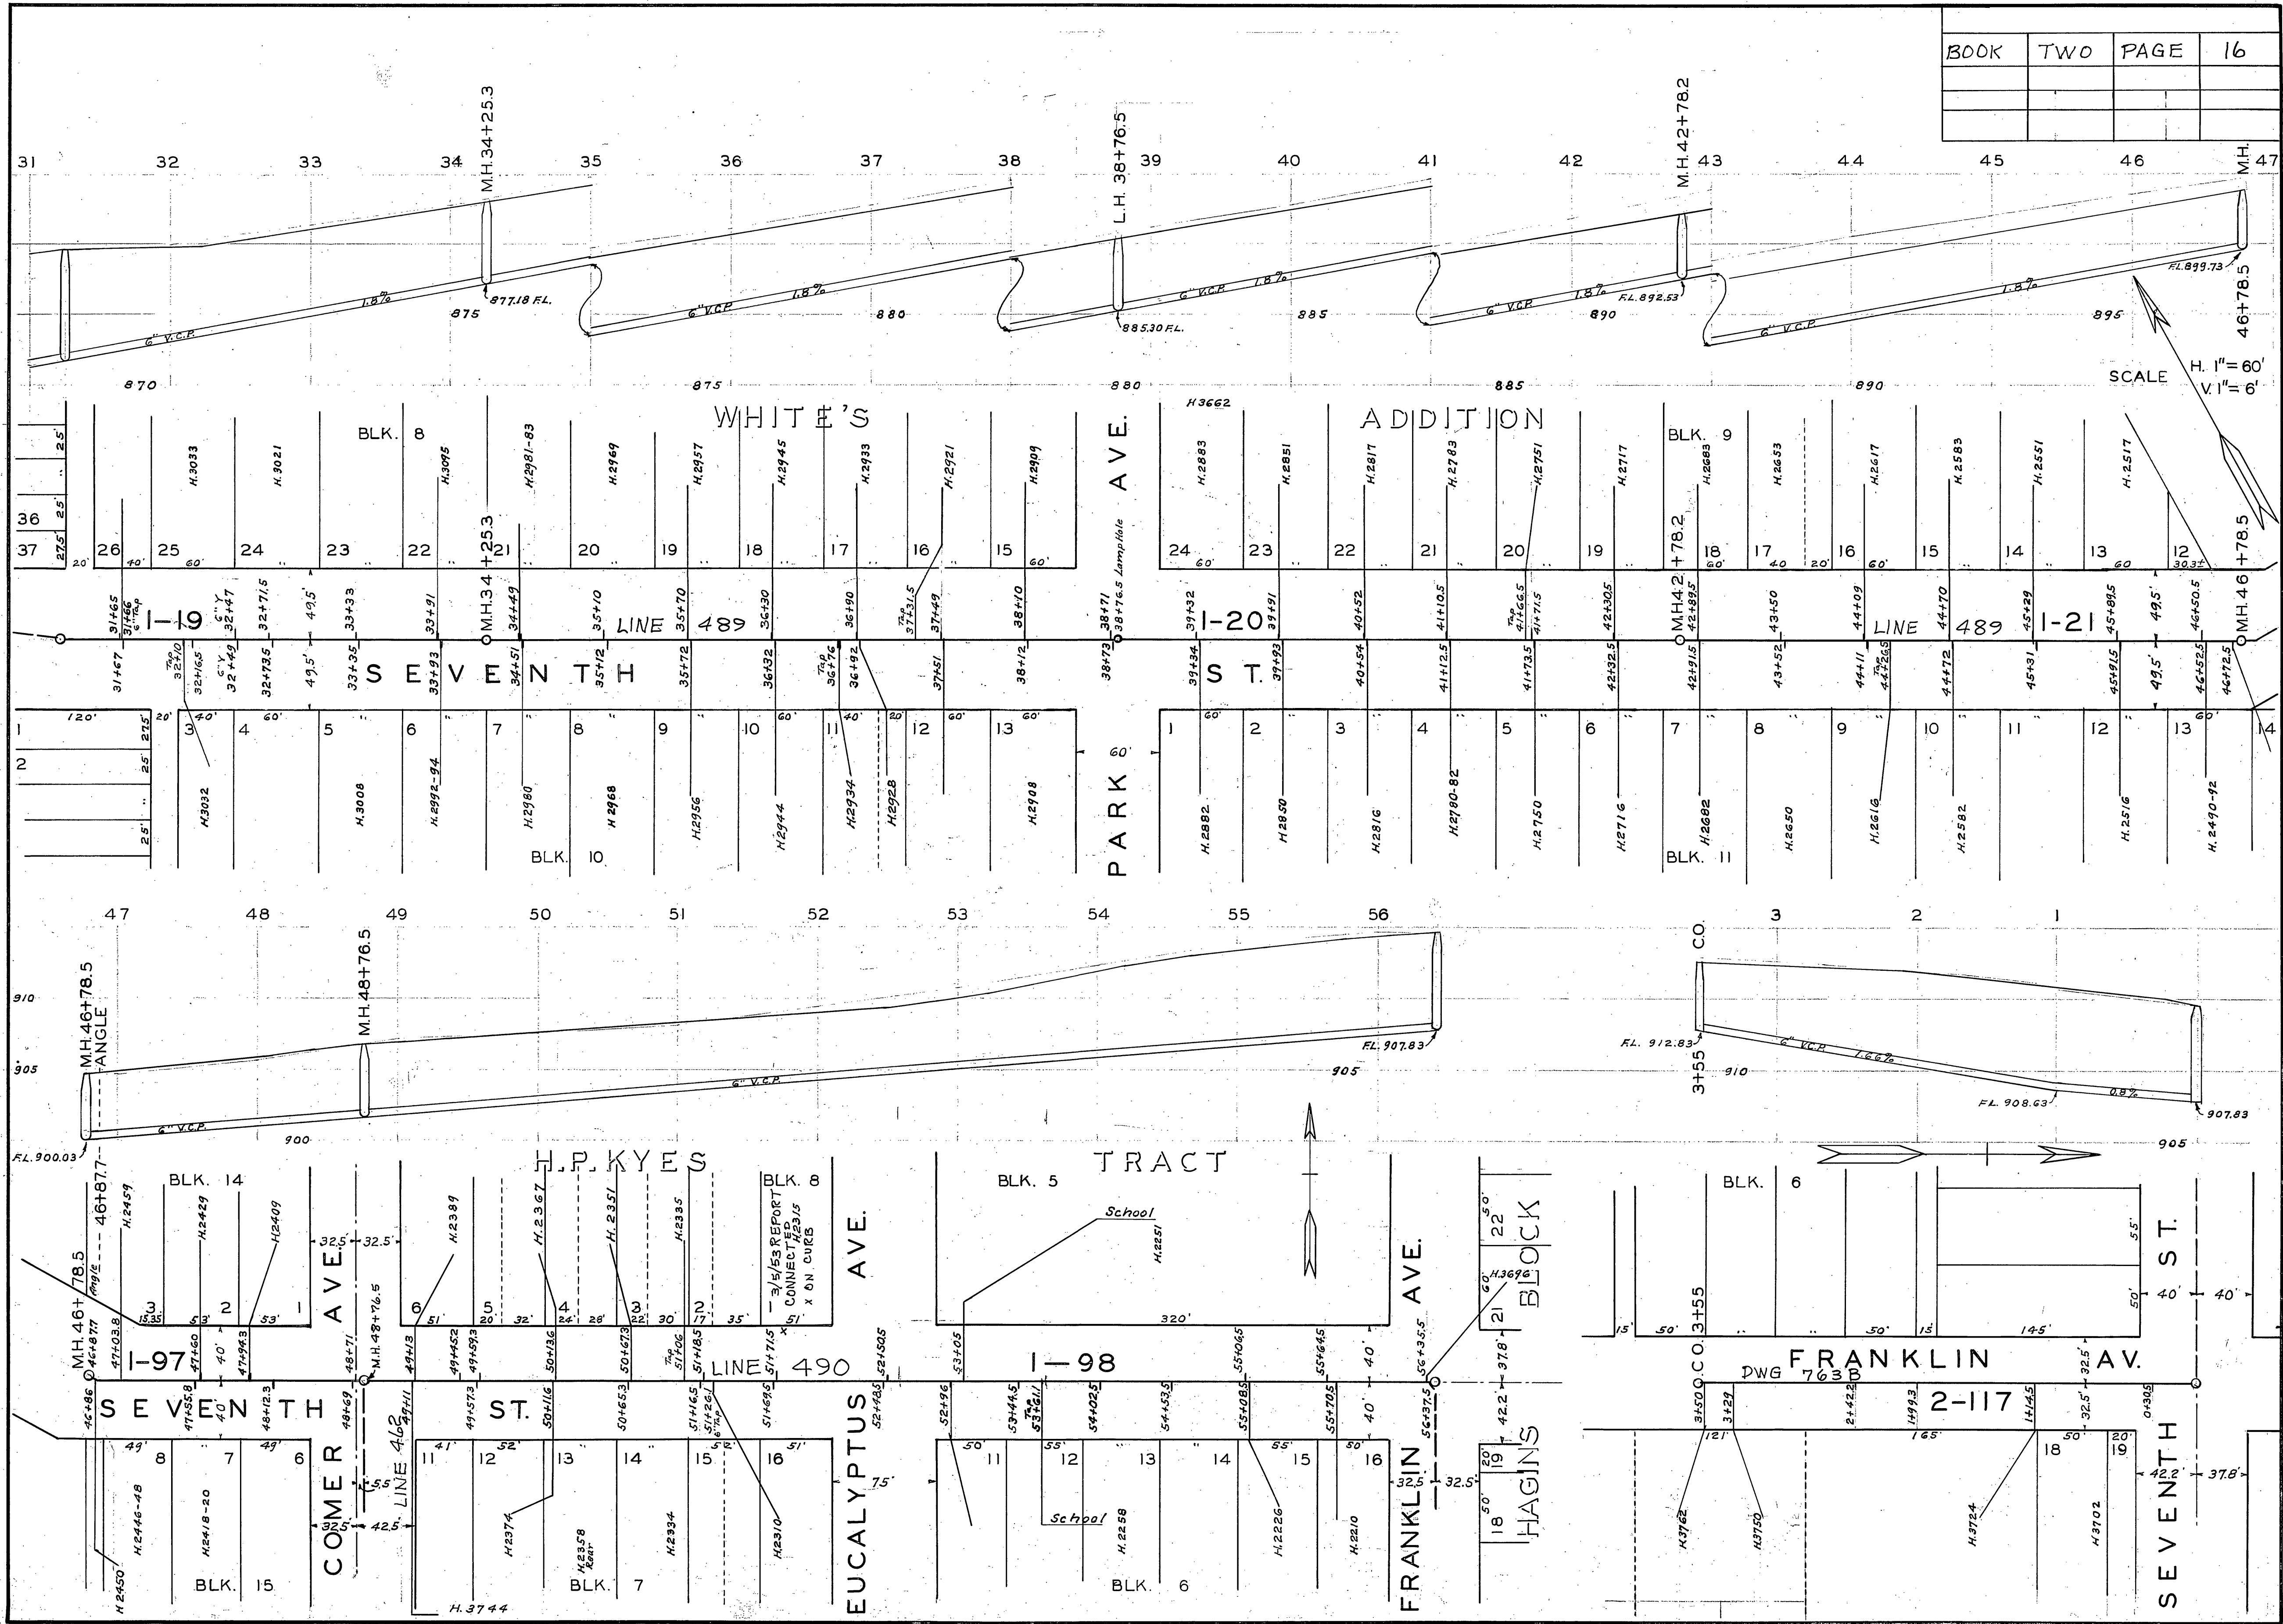

SCALE H. 1" = 60' V. 1" = 6'