


BOOK	TWO	PAGE	19

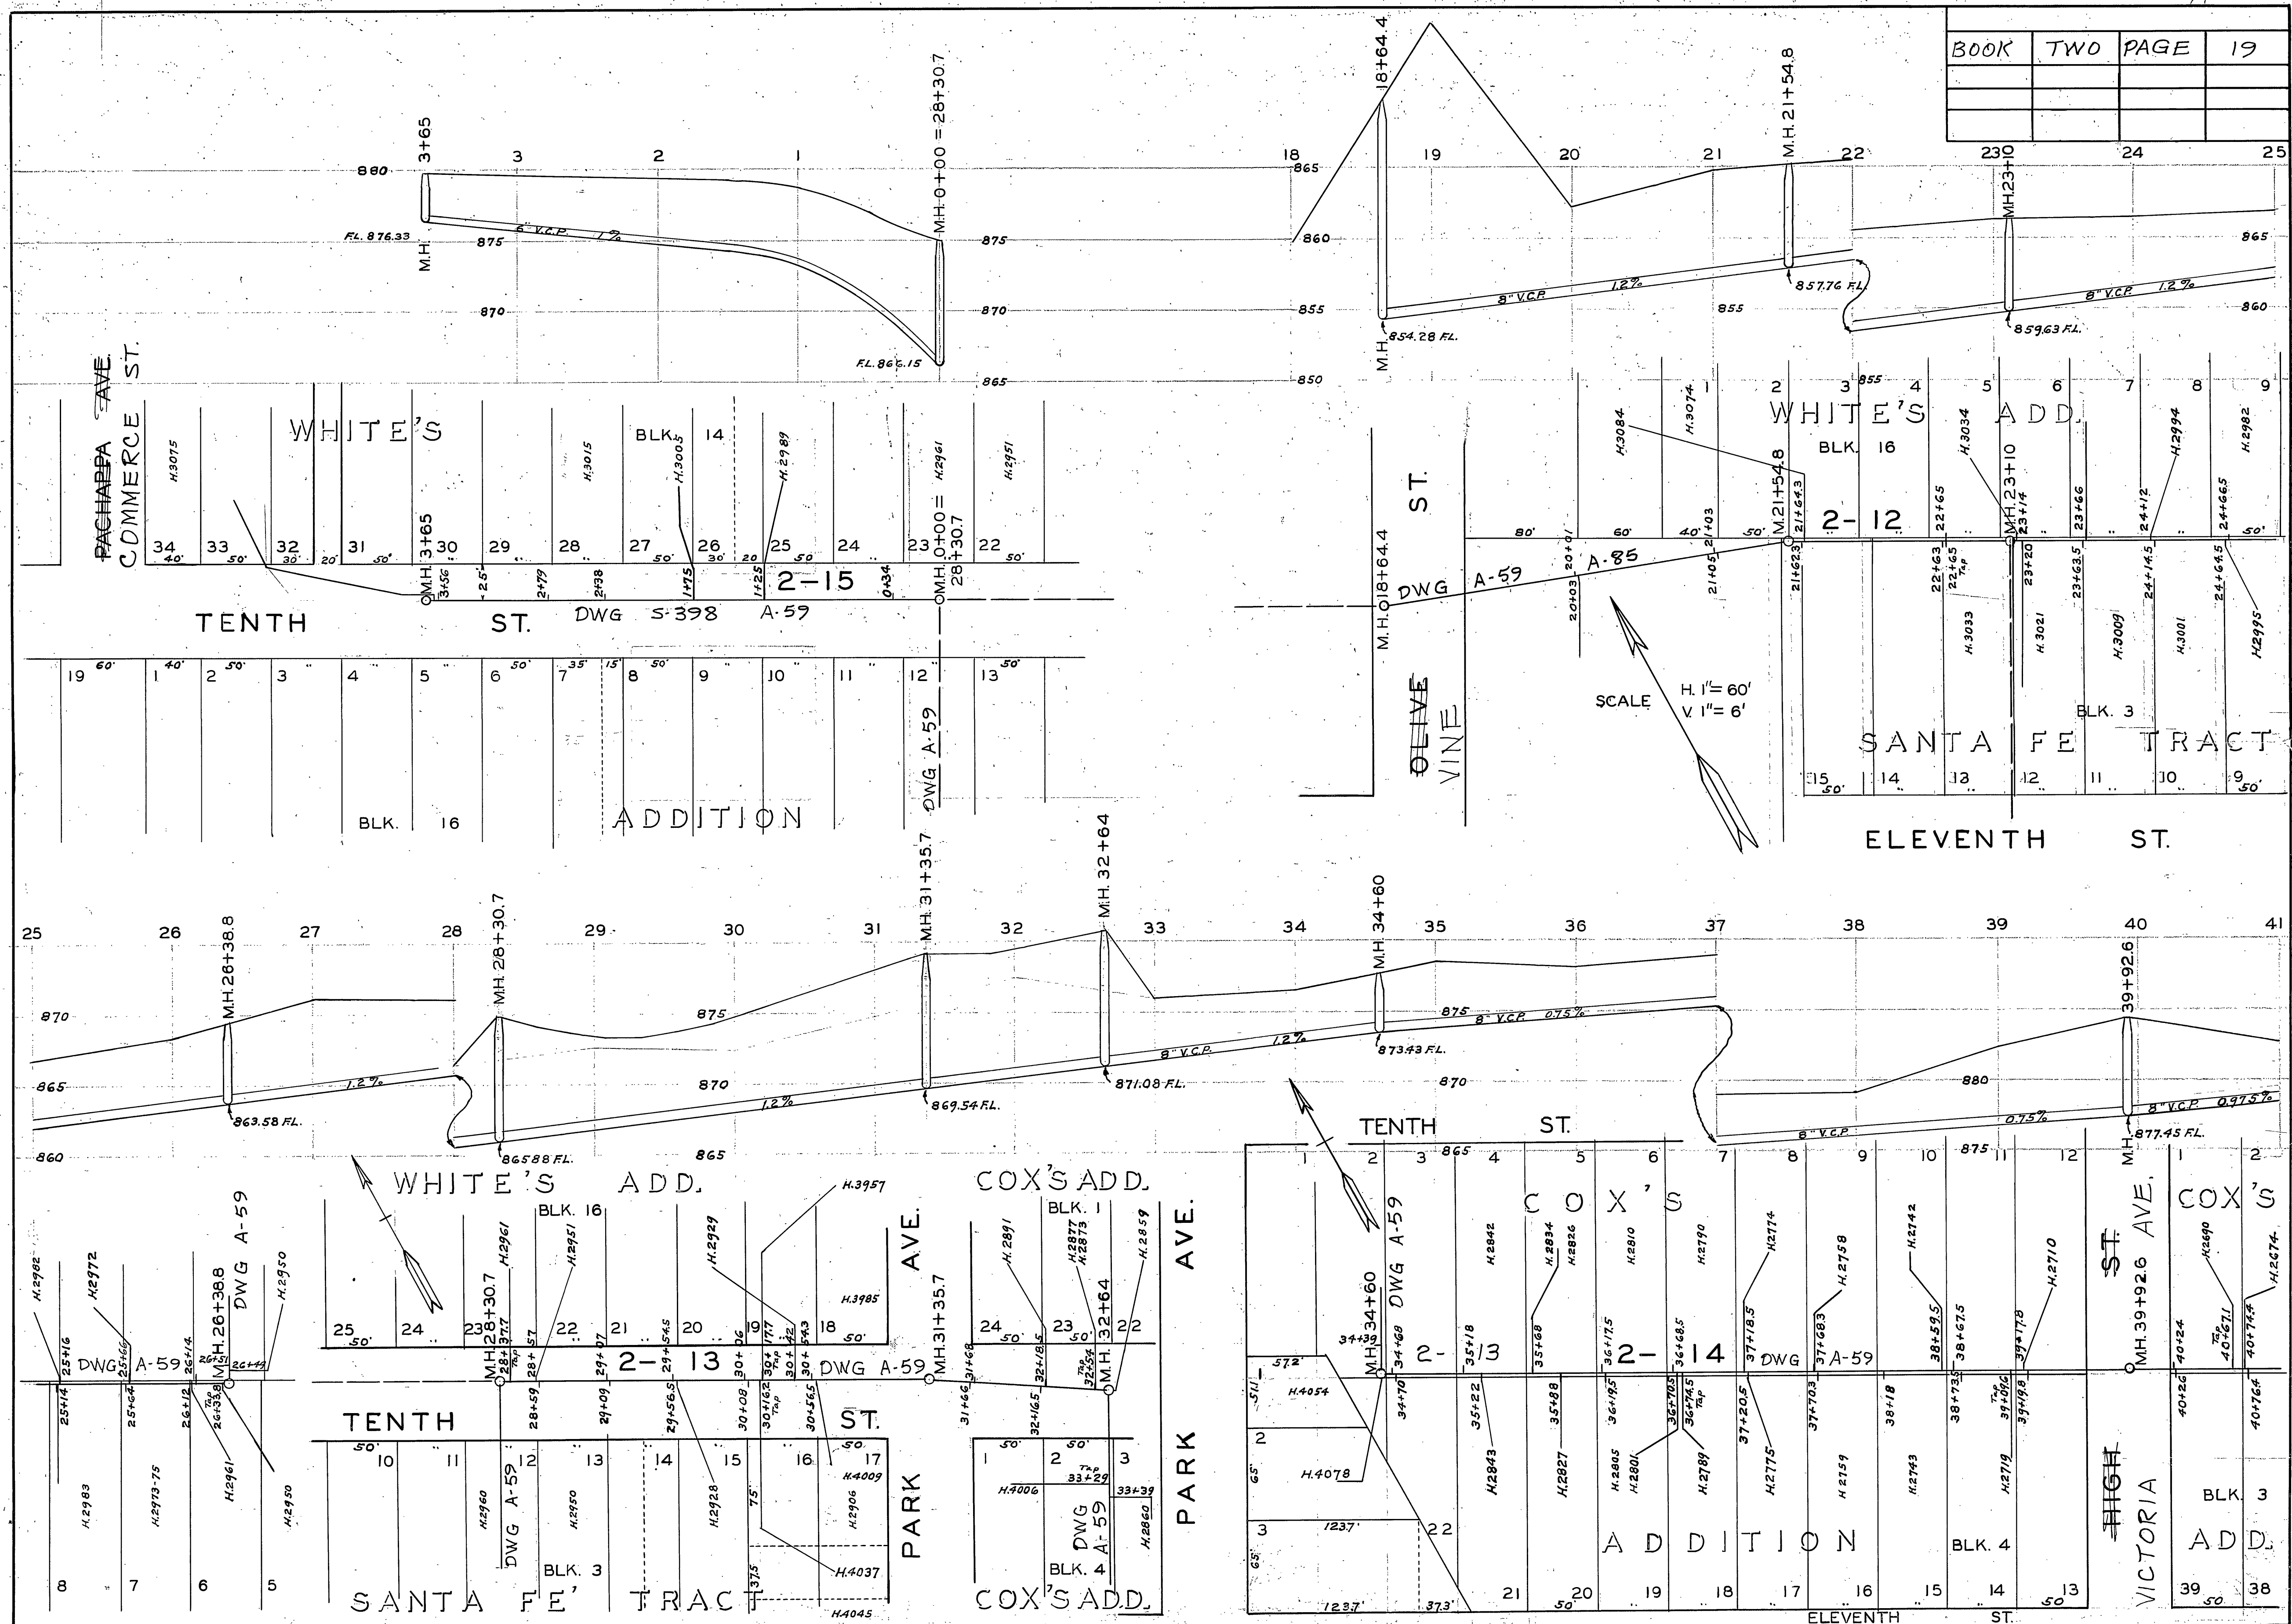

SCALE
 H 1" = 60'
 V 1" = 6'