


BOOK	TWO	PAGE	22

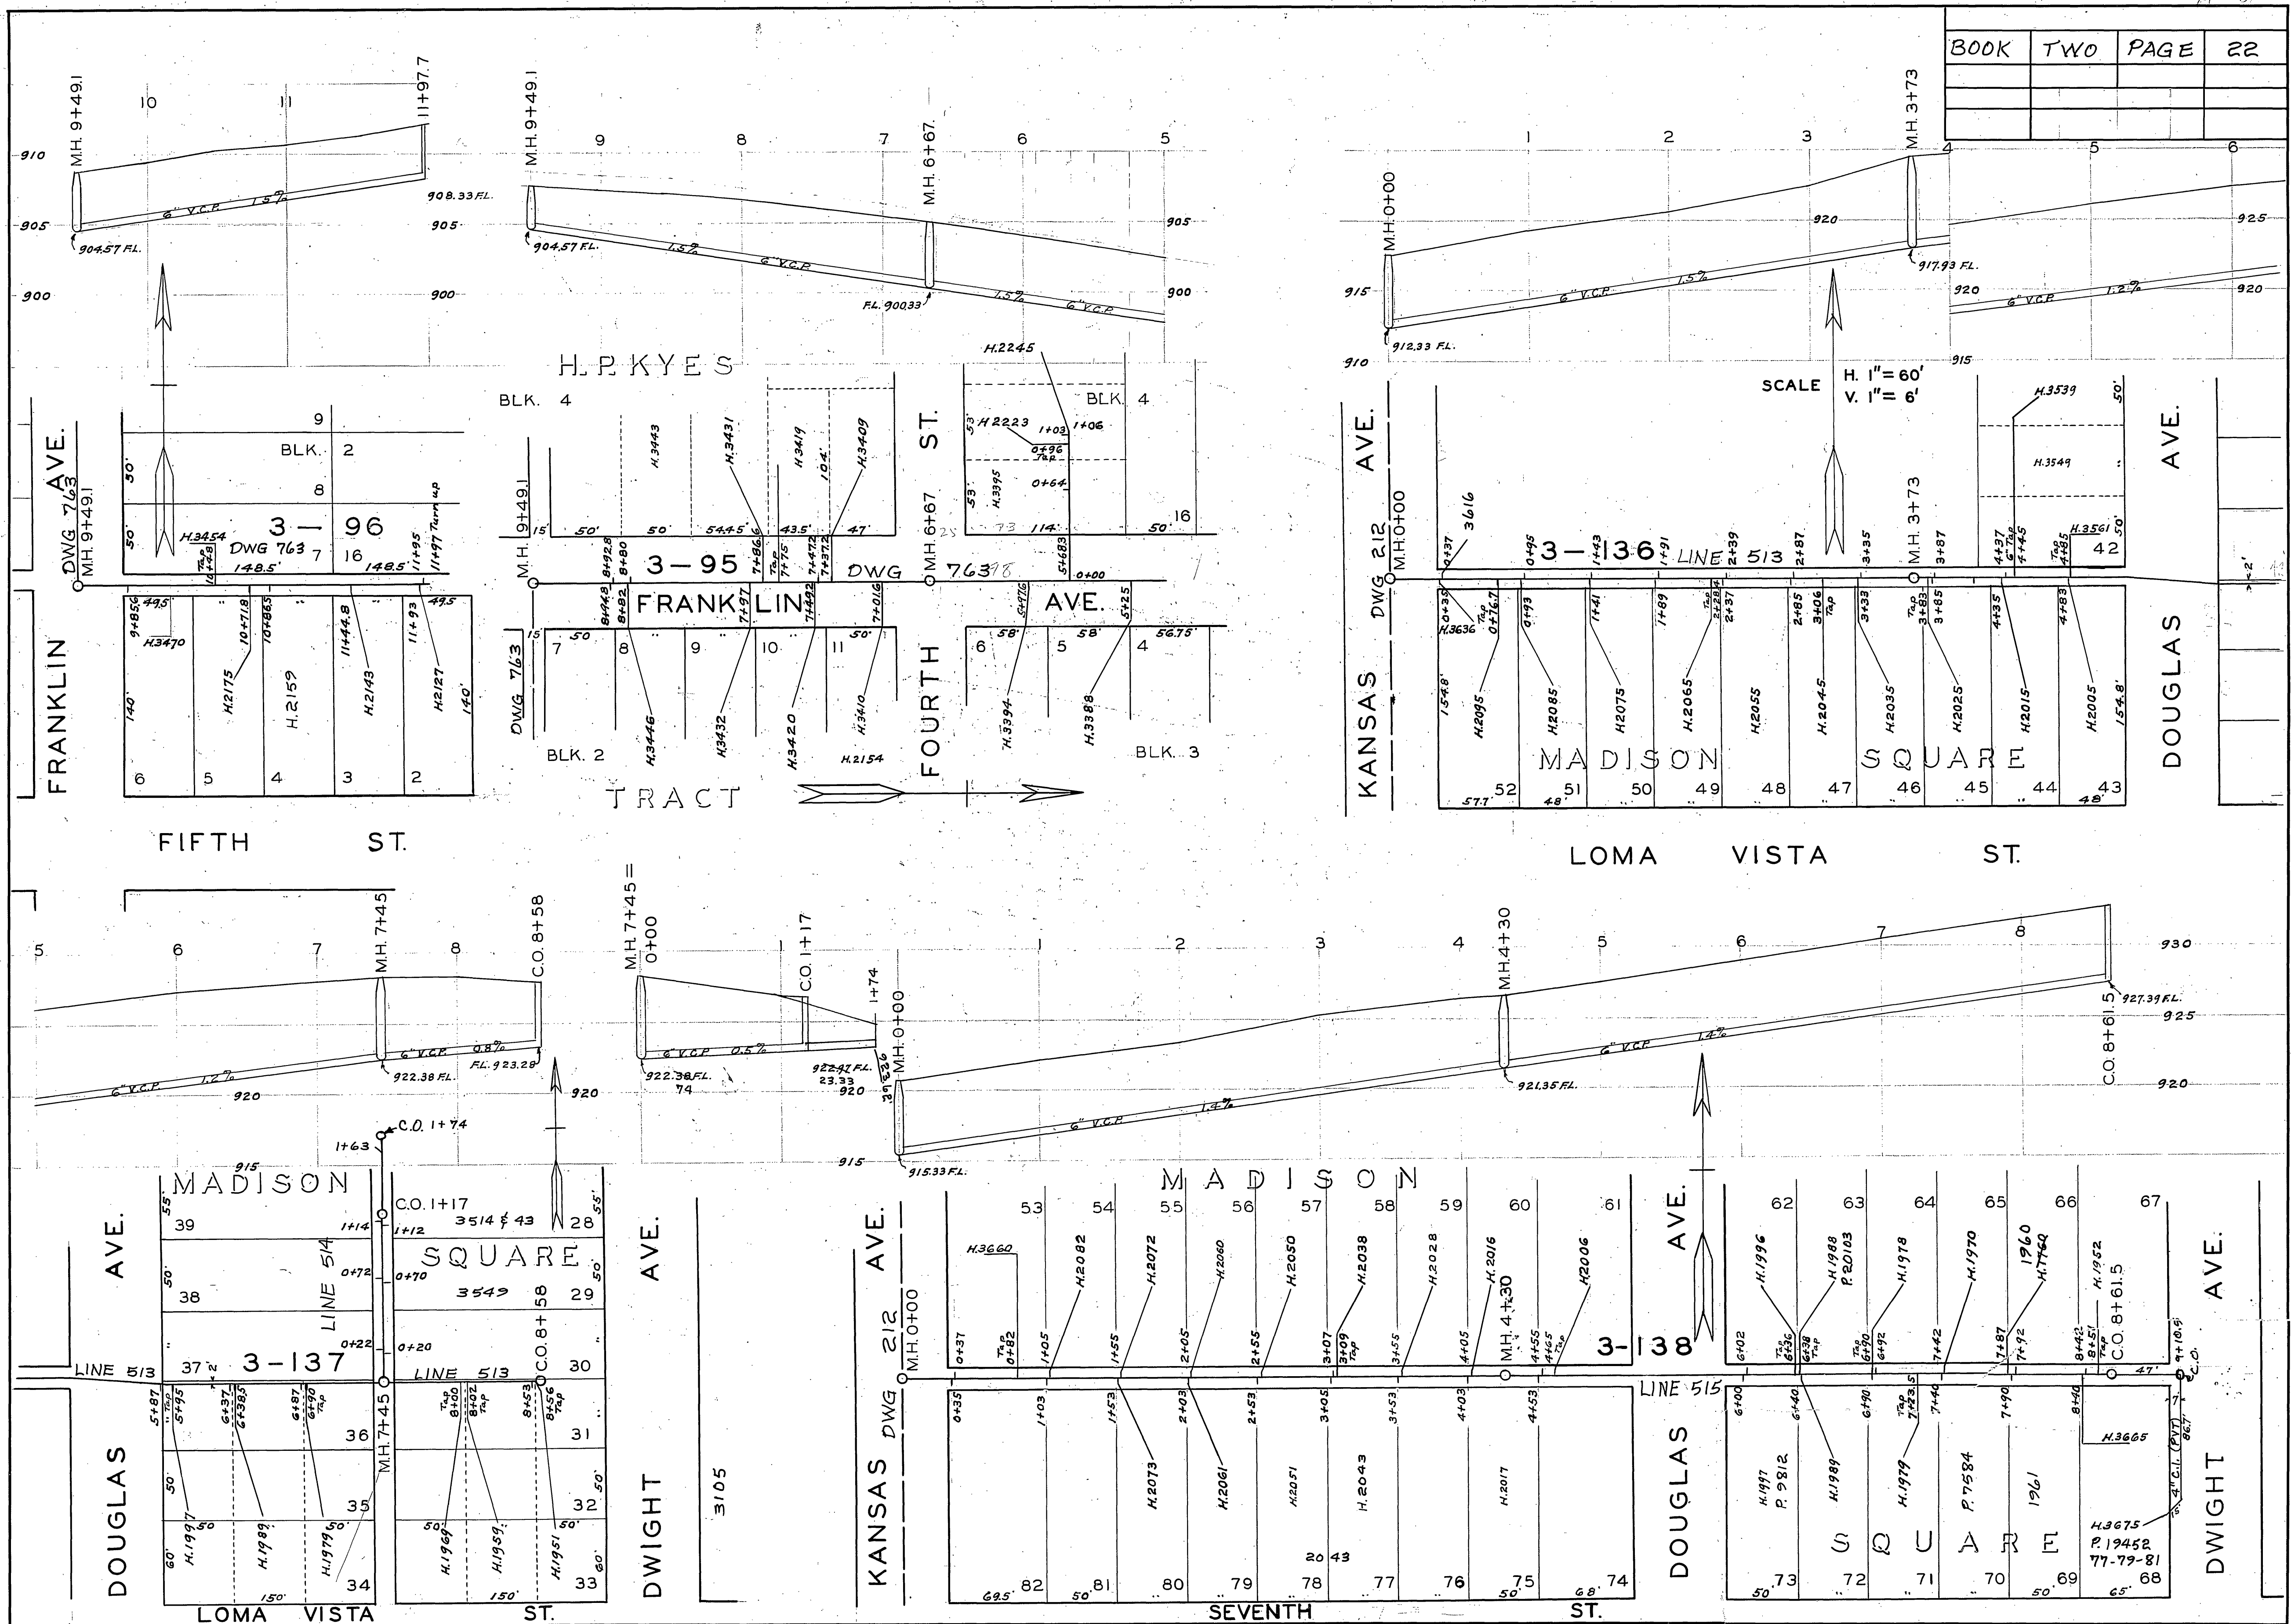

SCALE
 H. 1" = 60'
 V. 1" = 6'