


BOOK	TWO	PAGE	3

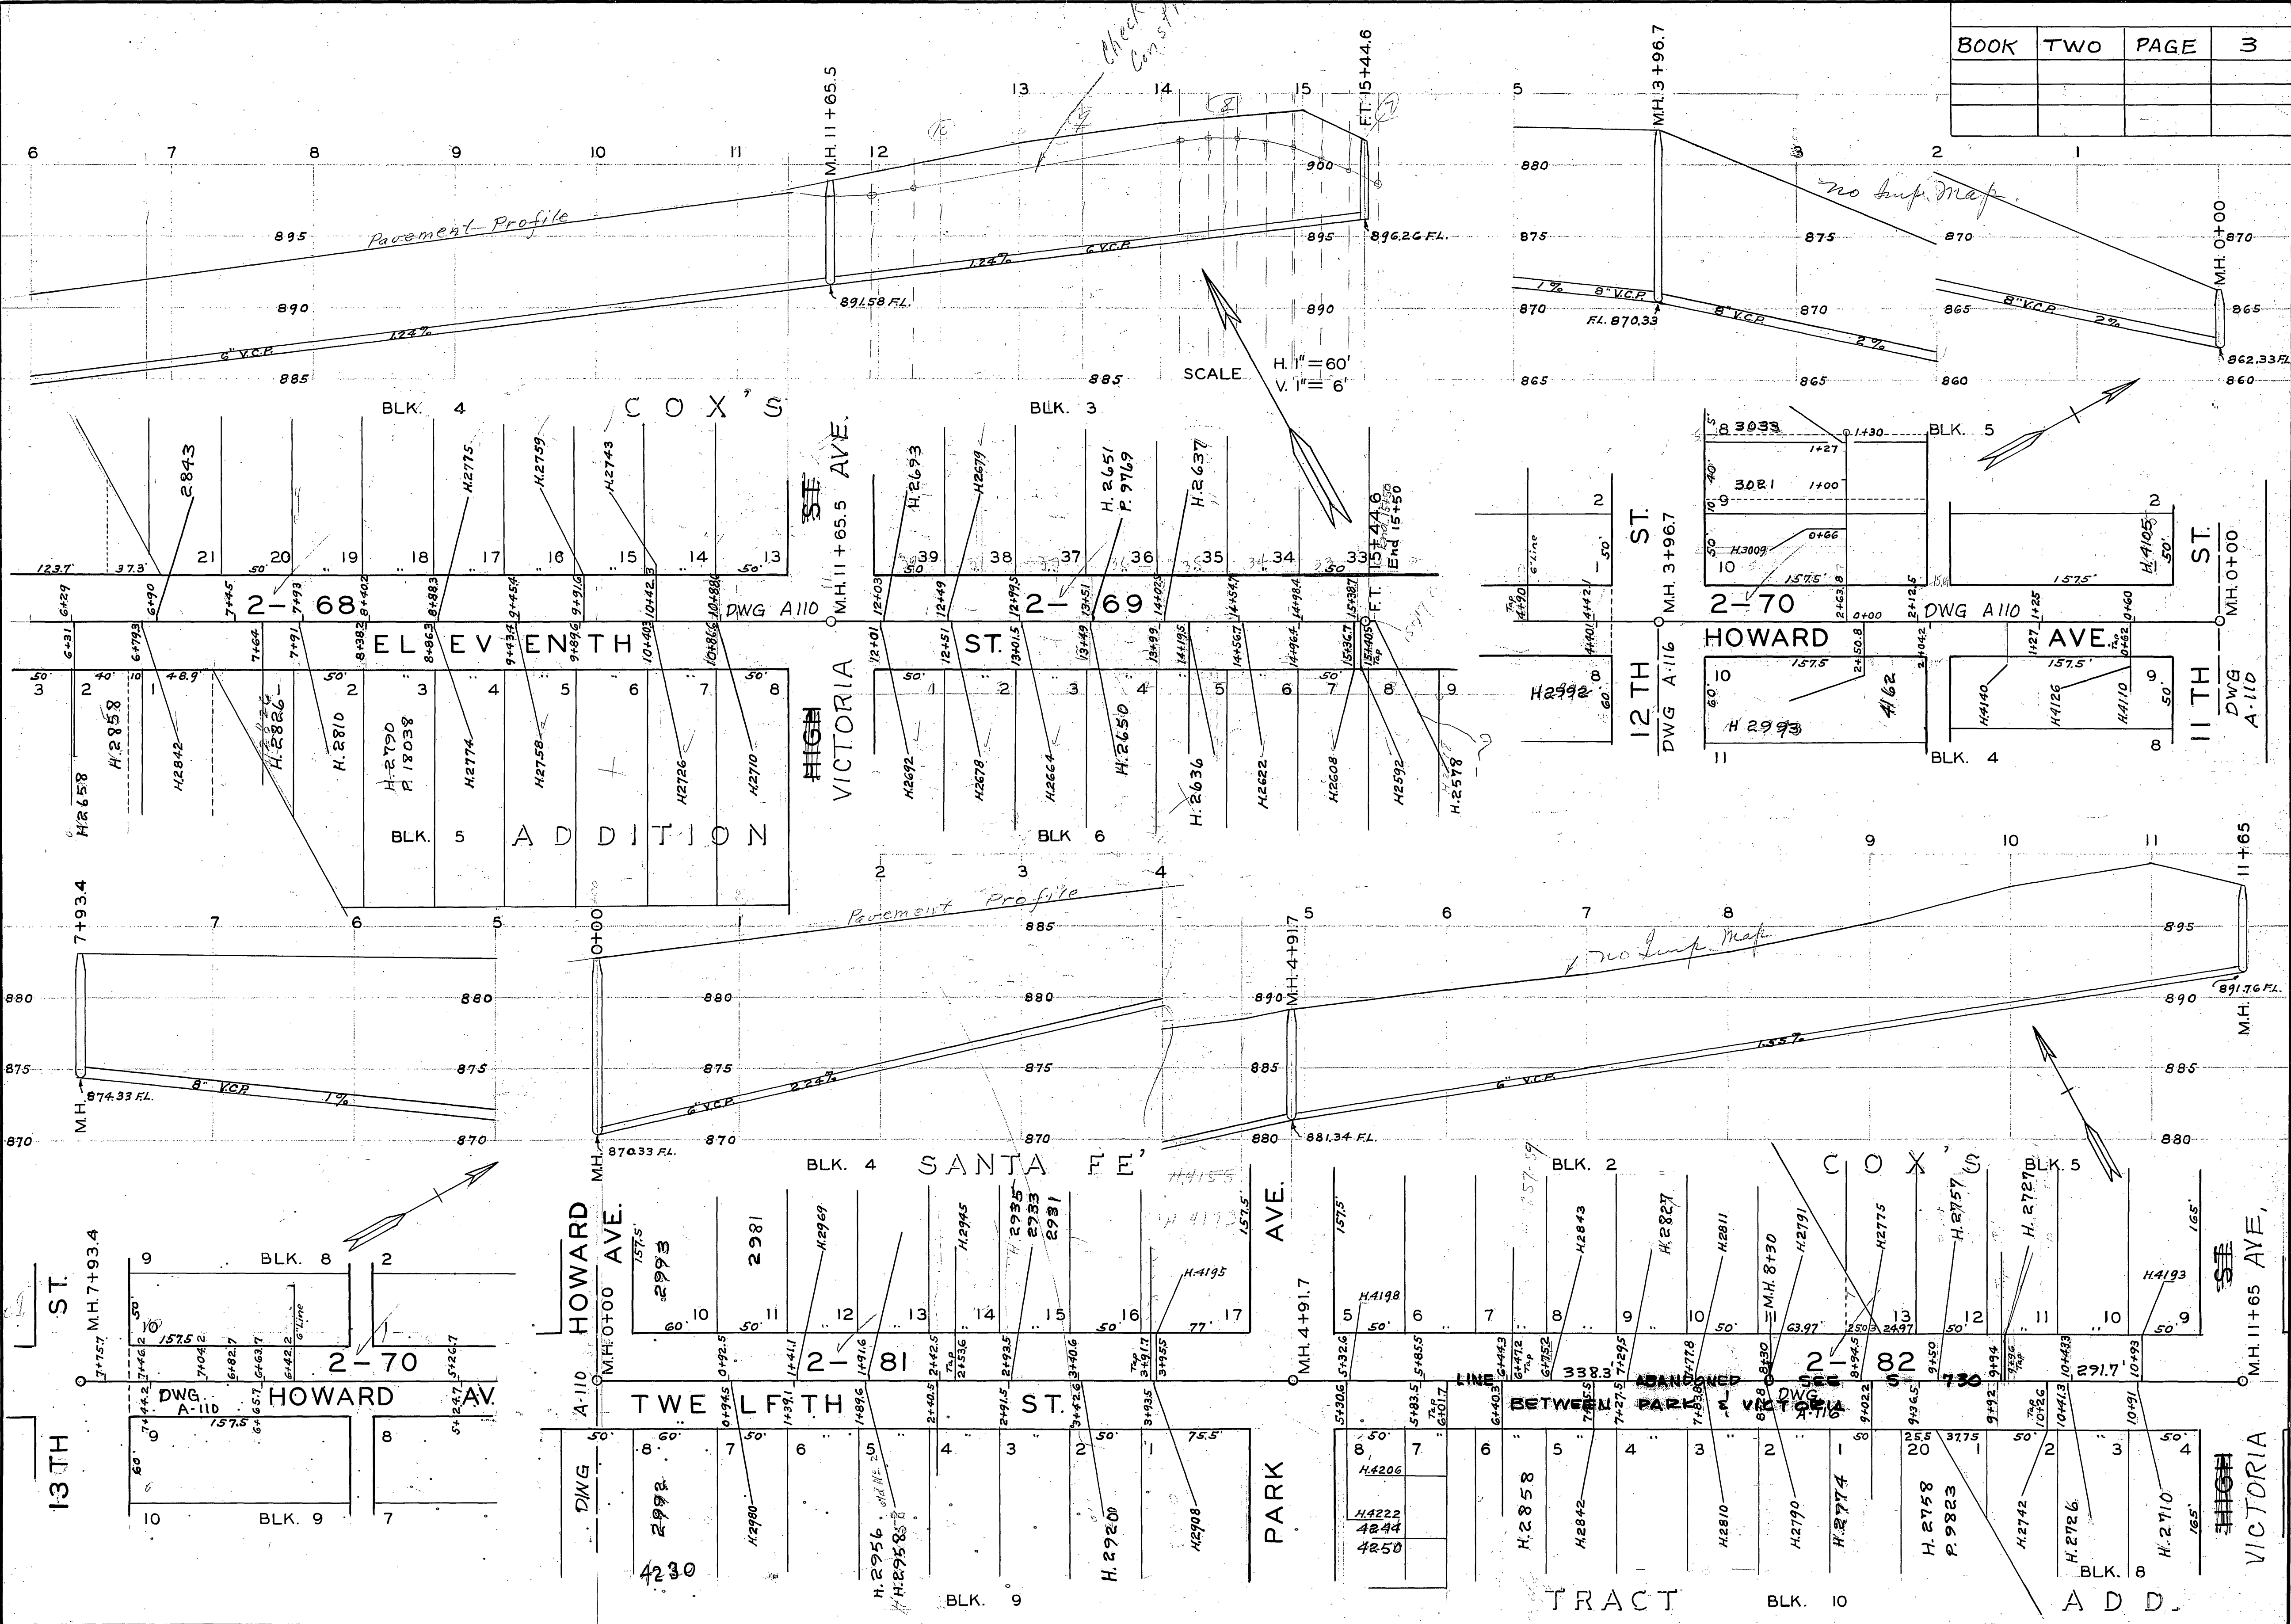

check for construction

SCALE H 1" = 60' V 1" = 6'