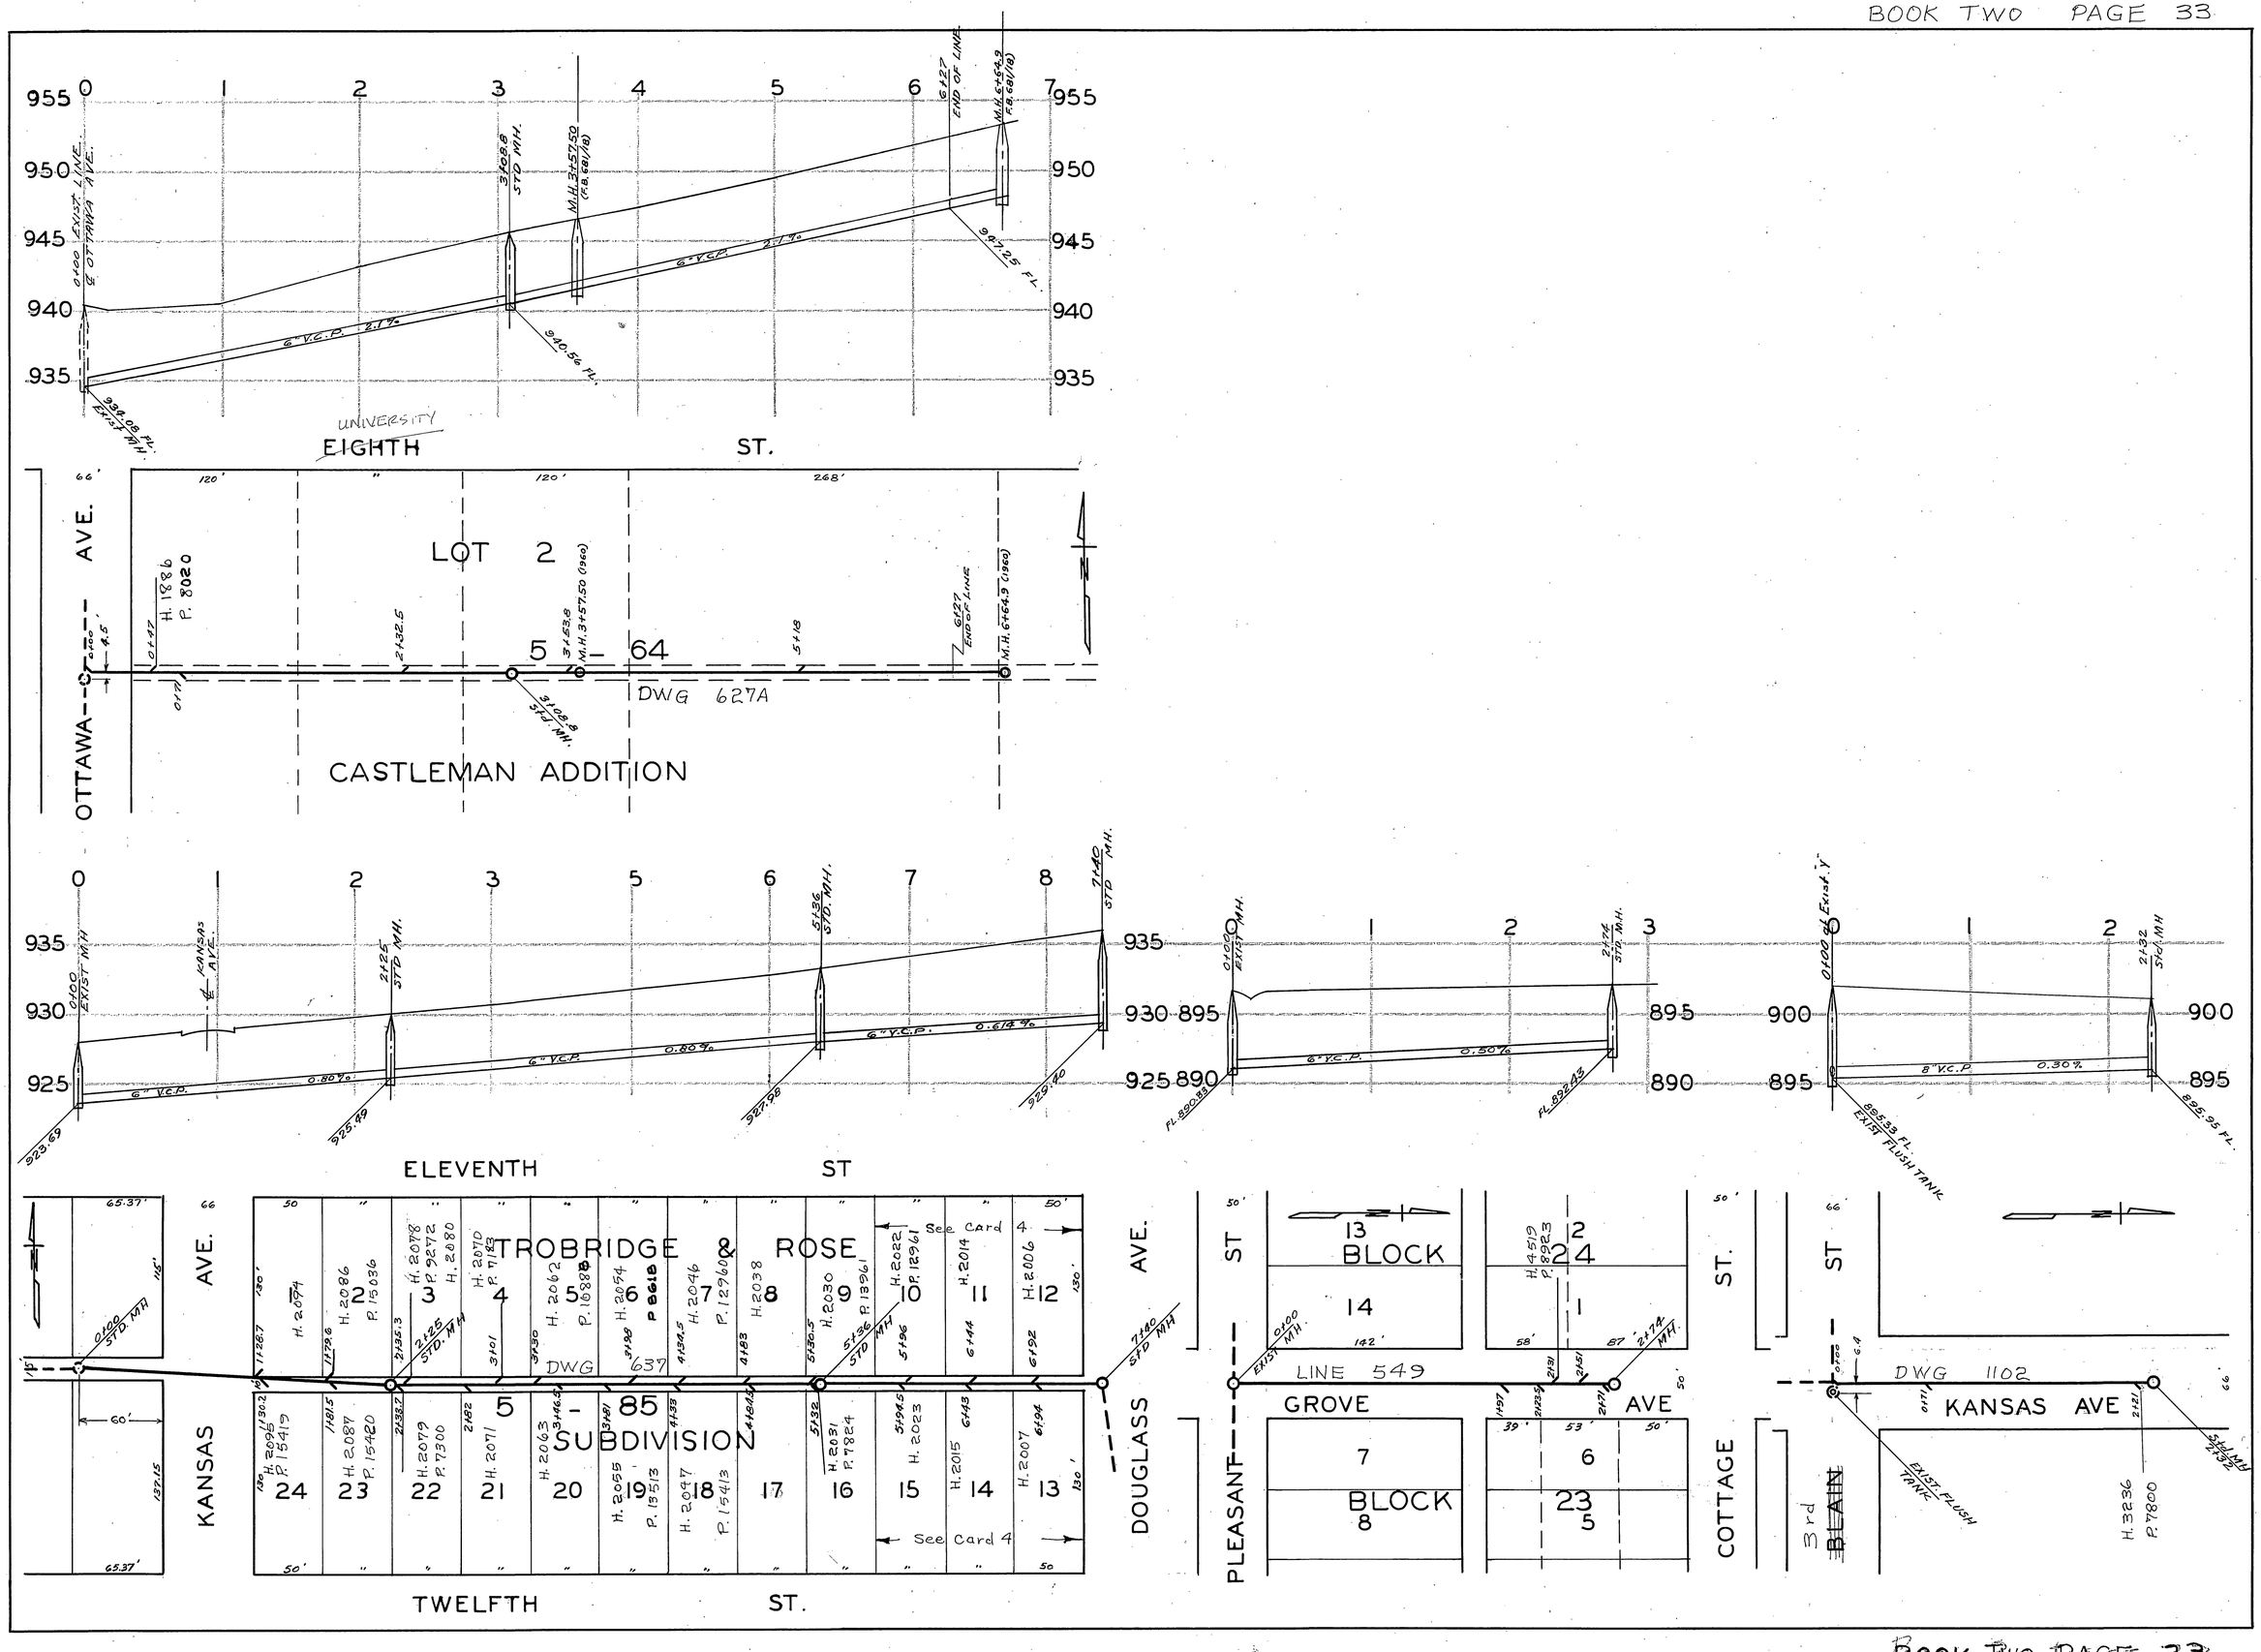
EIGHTH ST.
UNIVERSITY
OTTAWA AVE.
LOT 2
5 - 64
DWG 627A
CASTLEMAN ADDITION
ELEVENTH ST
TROBRIDGE & ROSE
SUBDIVISION
5 - 85
DWG 637
KANSAS AVE.
TWELFTH ST.
DOUGLASS AVE.
PLEASANT ST
BLOCK 14
BLOCK 8
GROVE AVE
LINE 549
COTTAGE ST.
3rd ST
KANSAS AVE
DWG 1102
EXIST. FLUSH TANK
See Card 4