
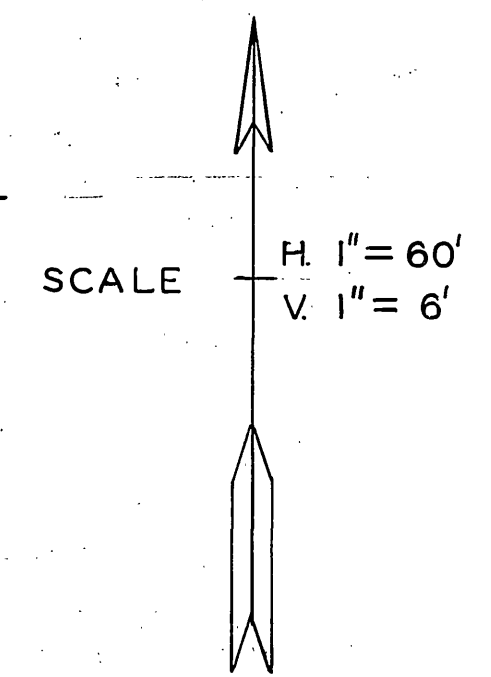


BOOK	TWO	PAGE	5

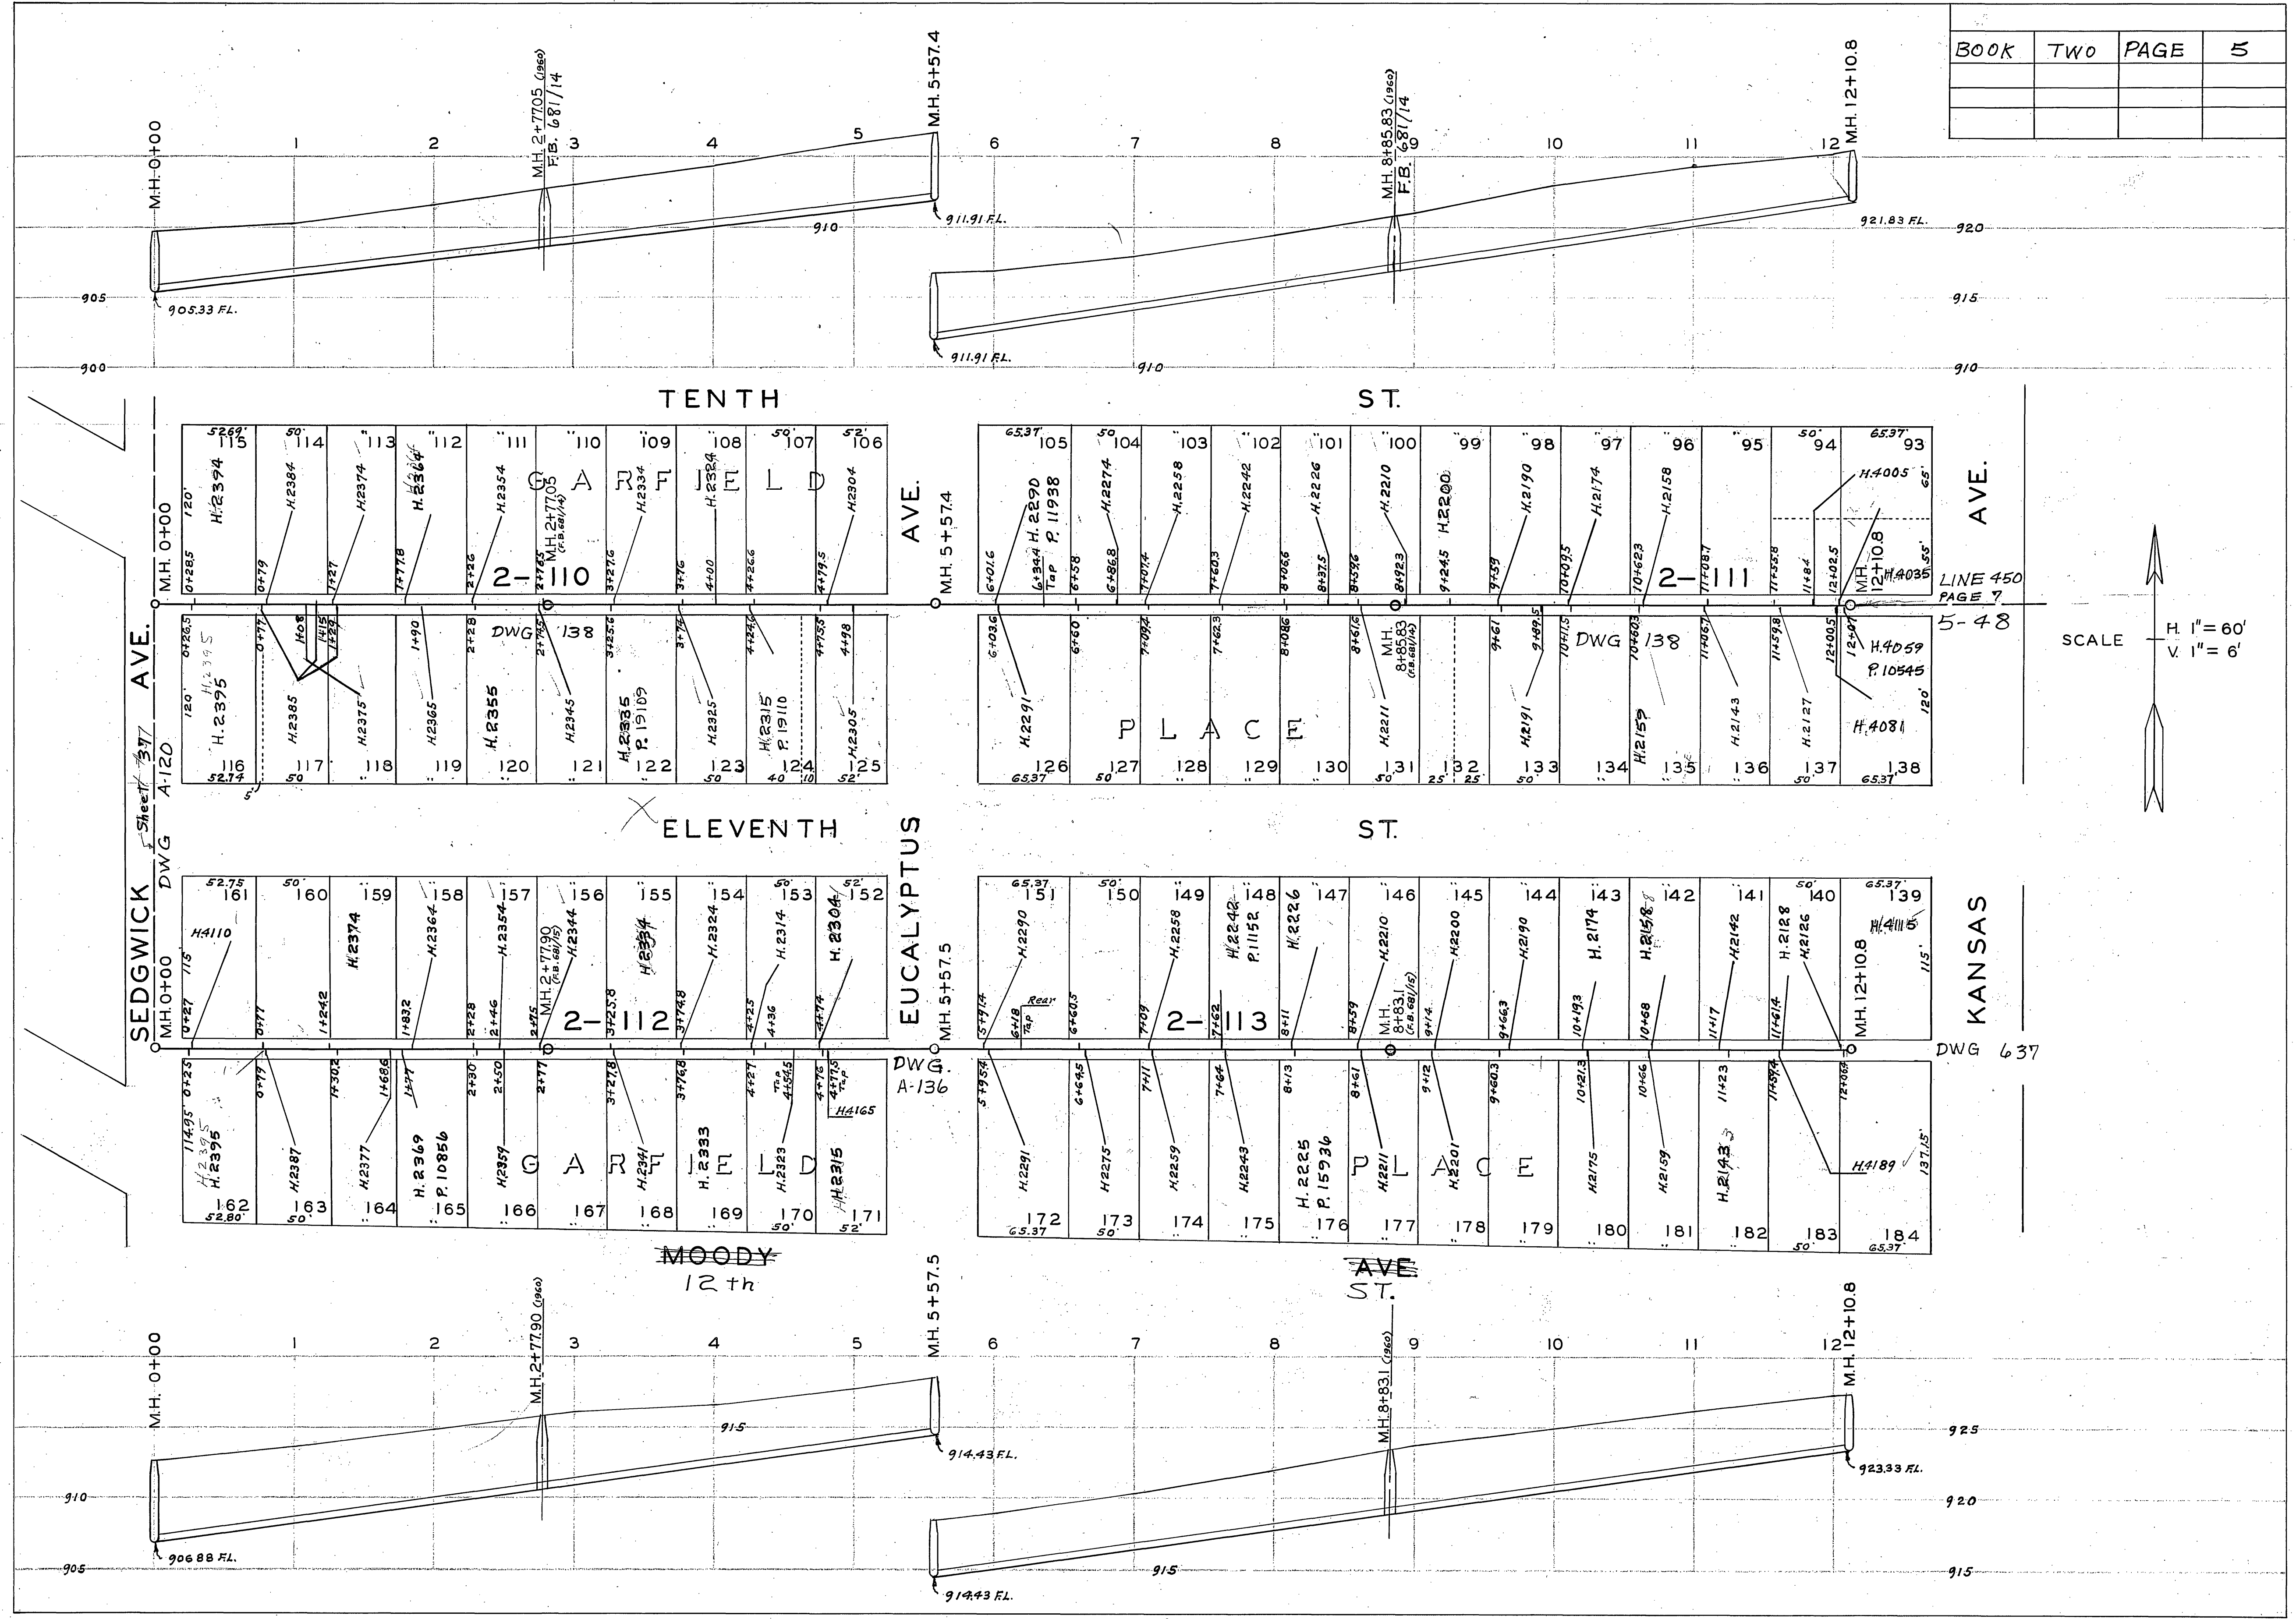

LINE 450
PAGE 7
5-48

DWG 637