


Alley Grade FB 404/66 P. 66 -  
Postcard  
A-38

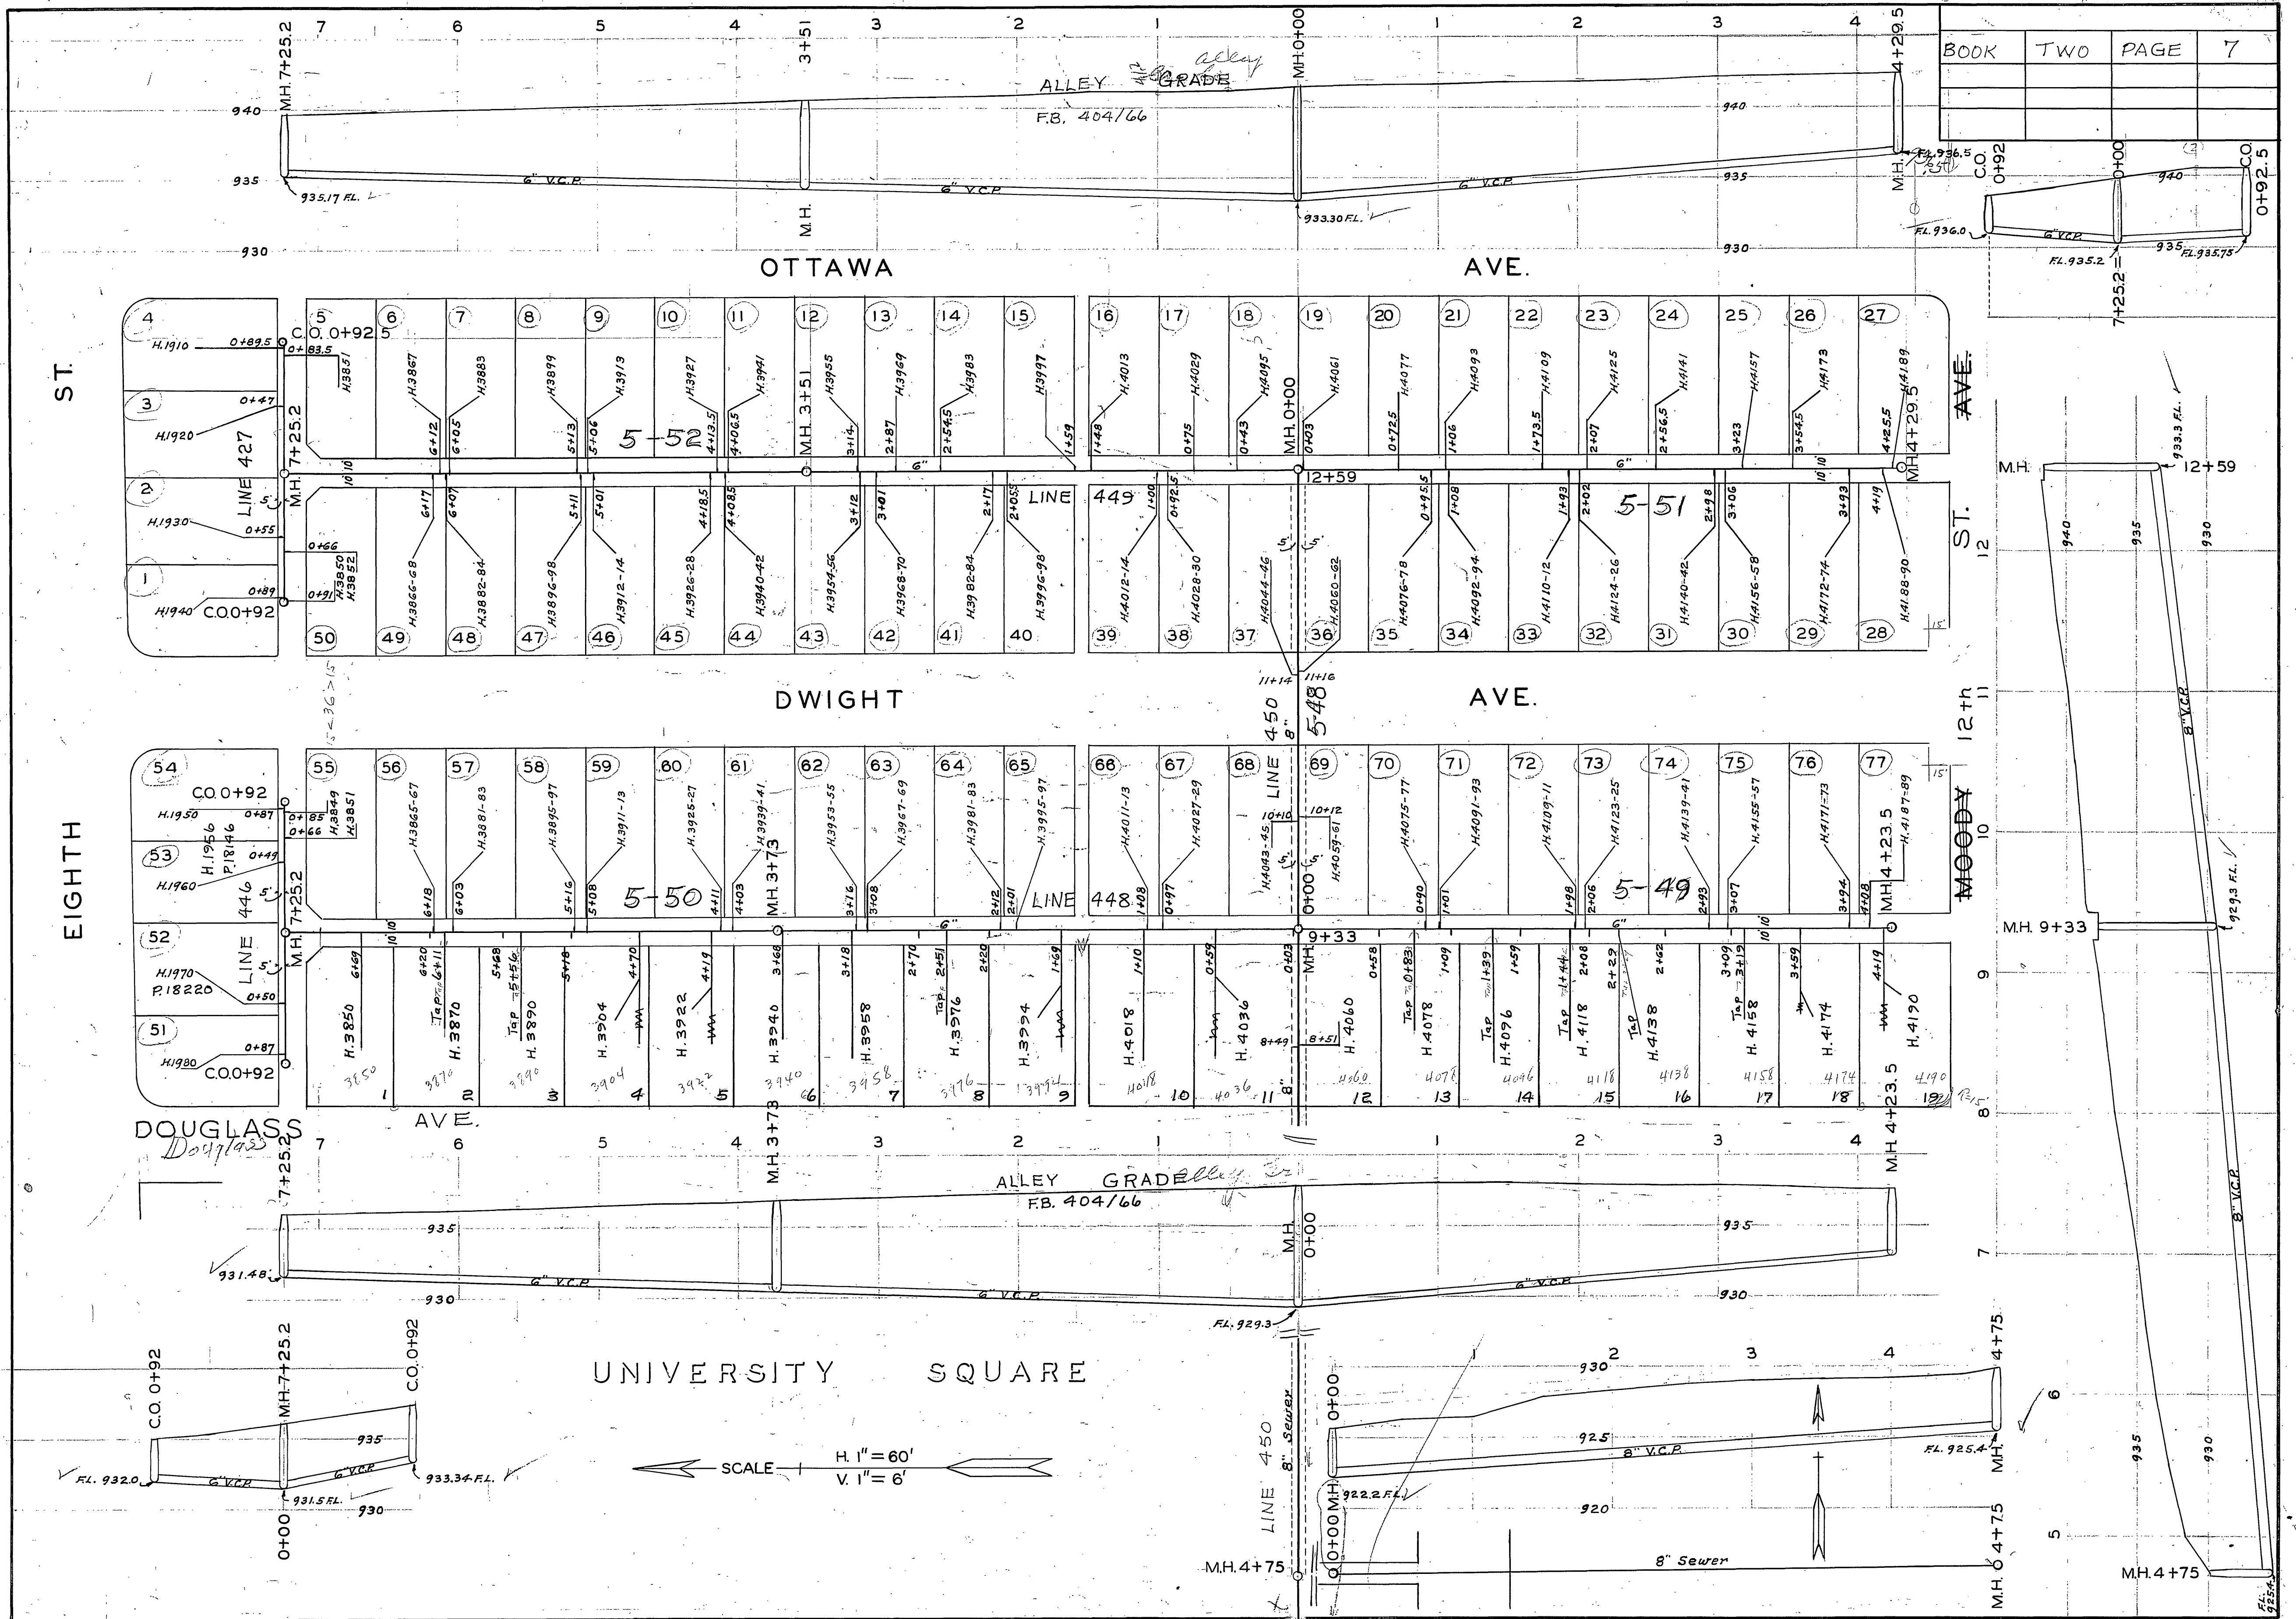

BOOK	TWO	PAGE	7

ST.

EIGHTH

ST.

MOODY

DOUGLASS

UNIVERSITY