


BOOK	TWO	PAGE	9

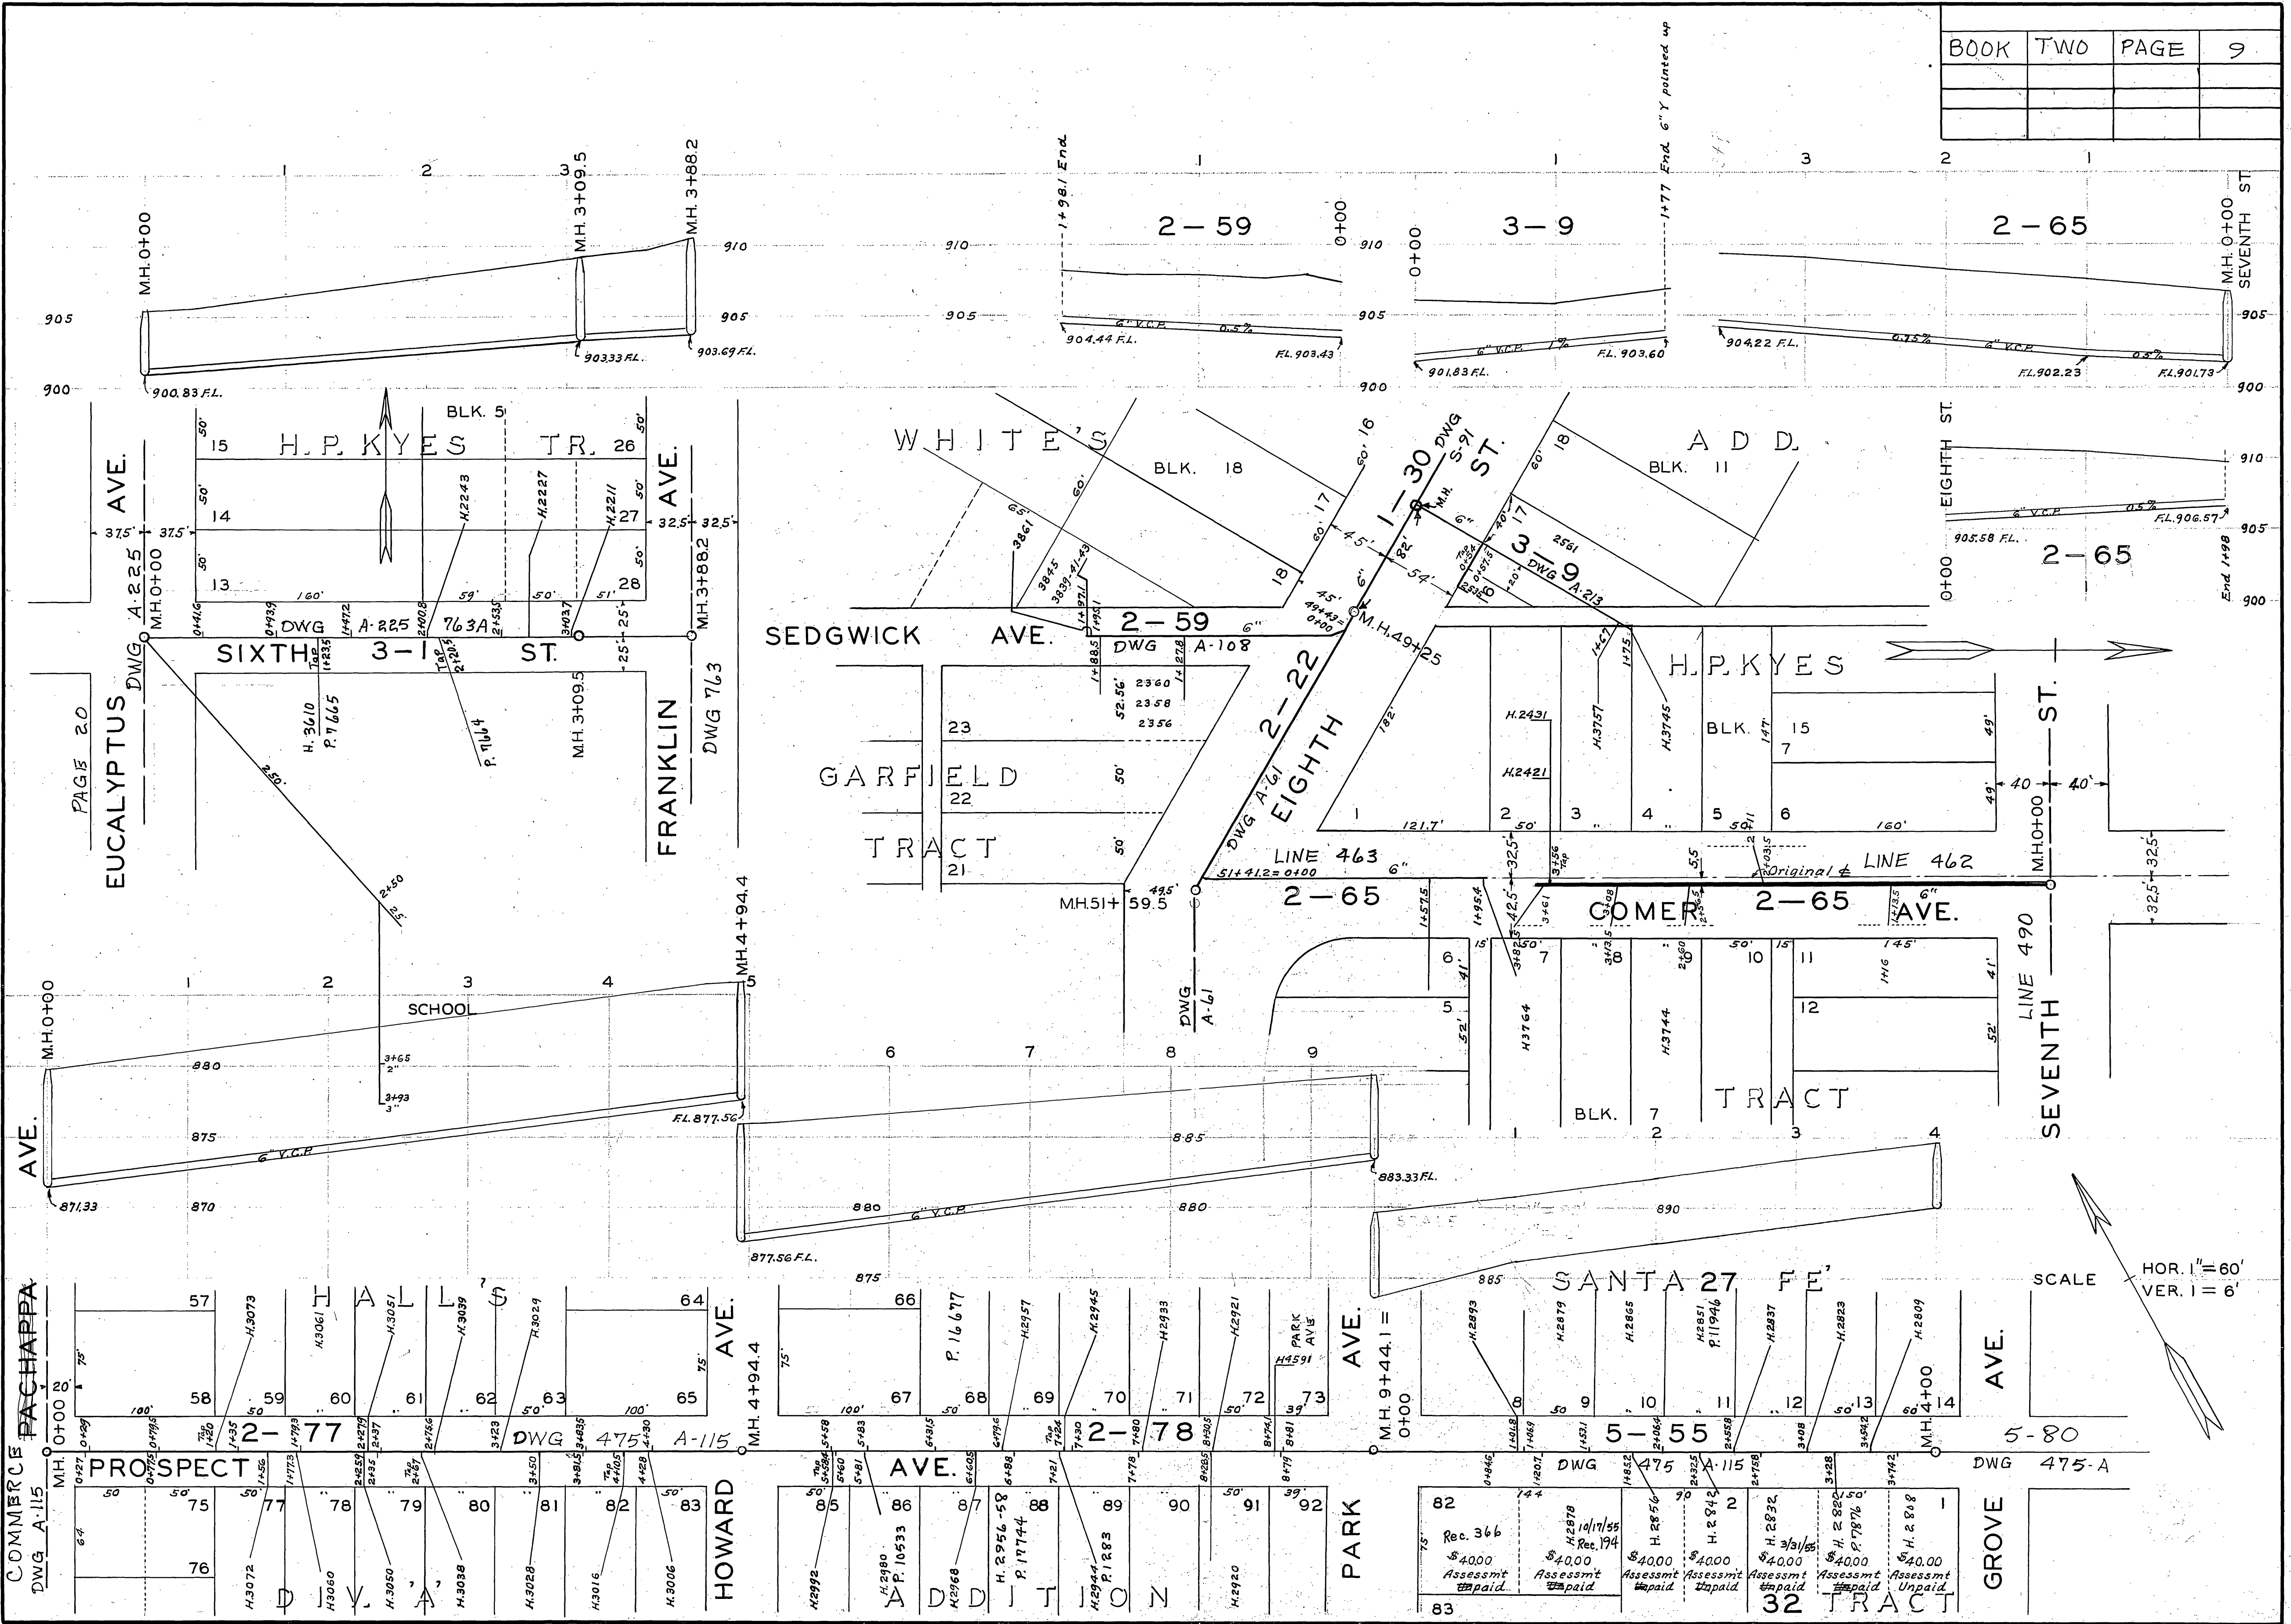

SCALE
 HOR. 1" = 60'
 VER. 1" = 6'