Posted 9-27-44

508

BOOK	THREE	PAGE	24

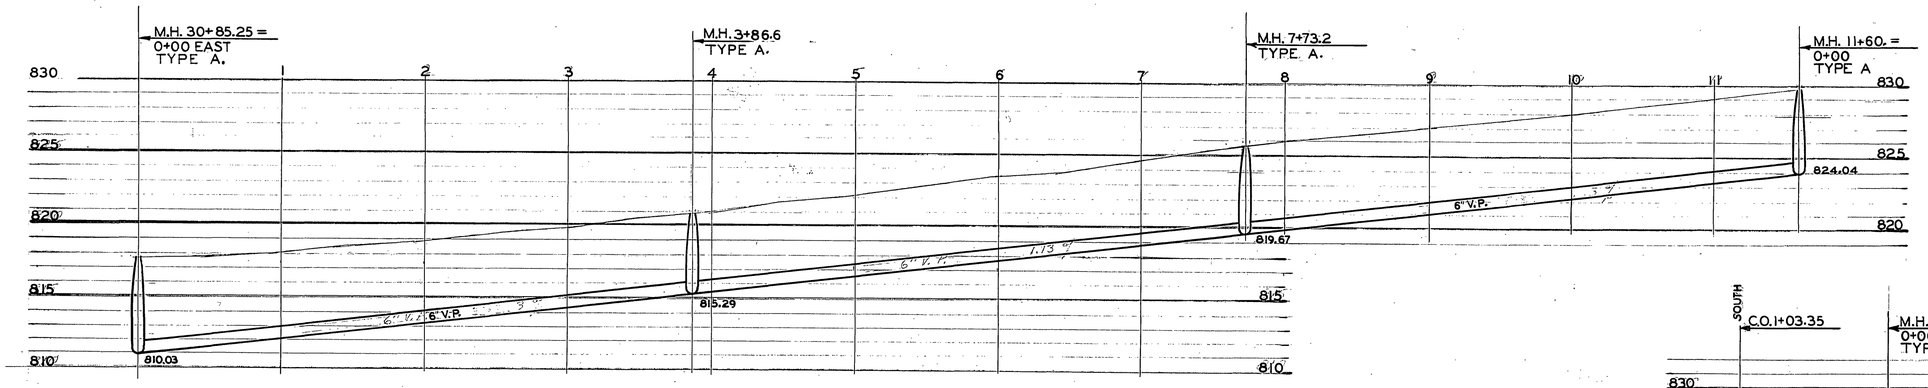

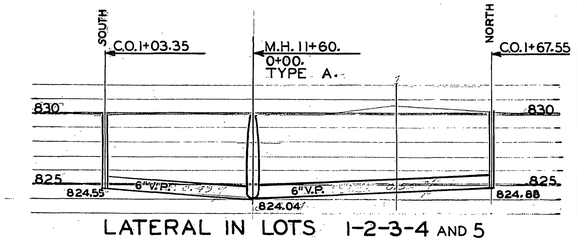
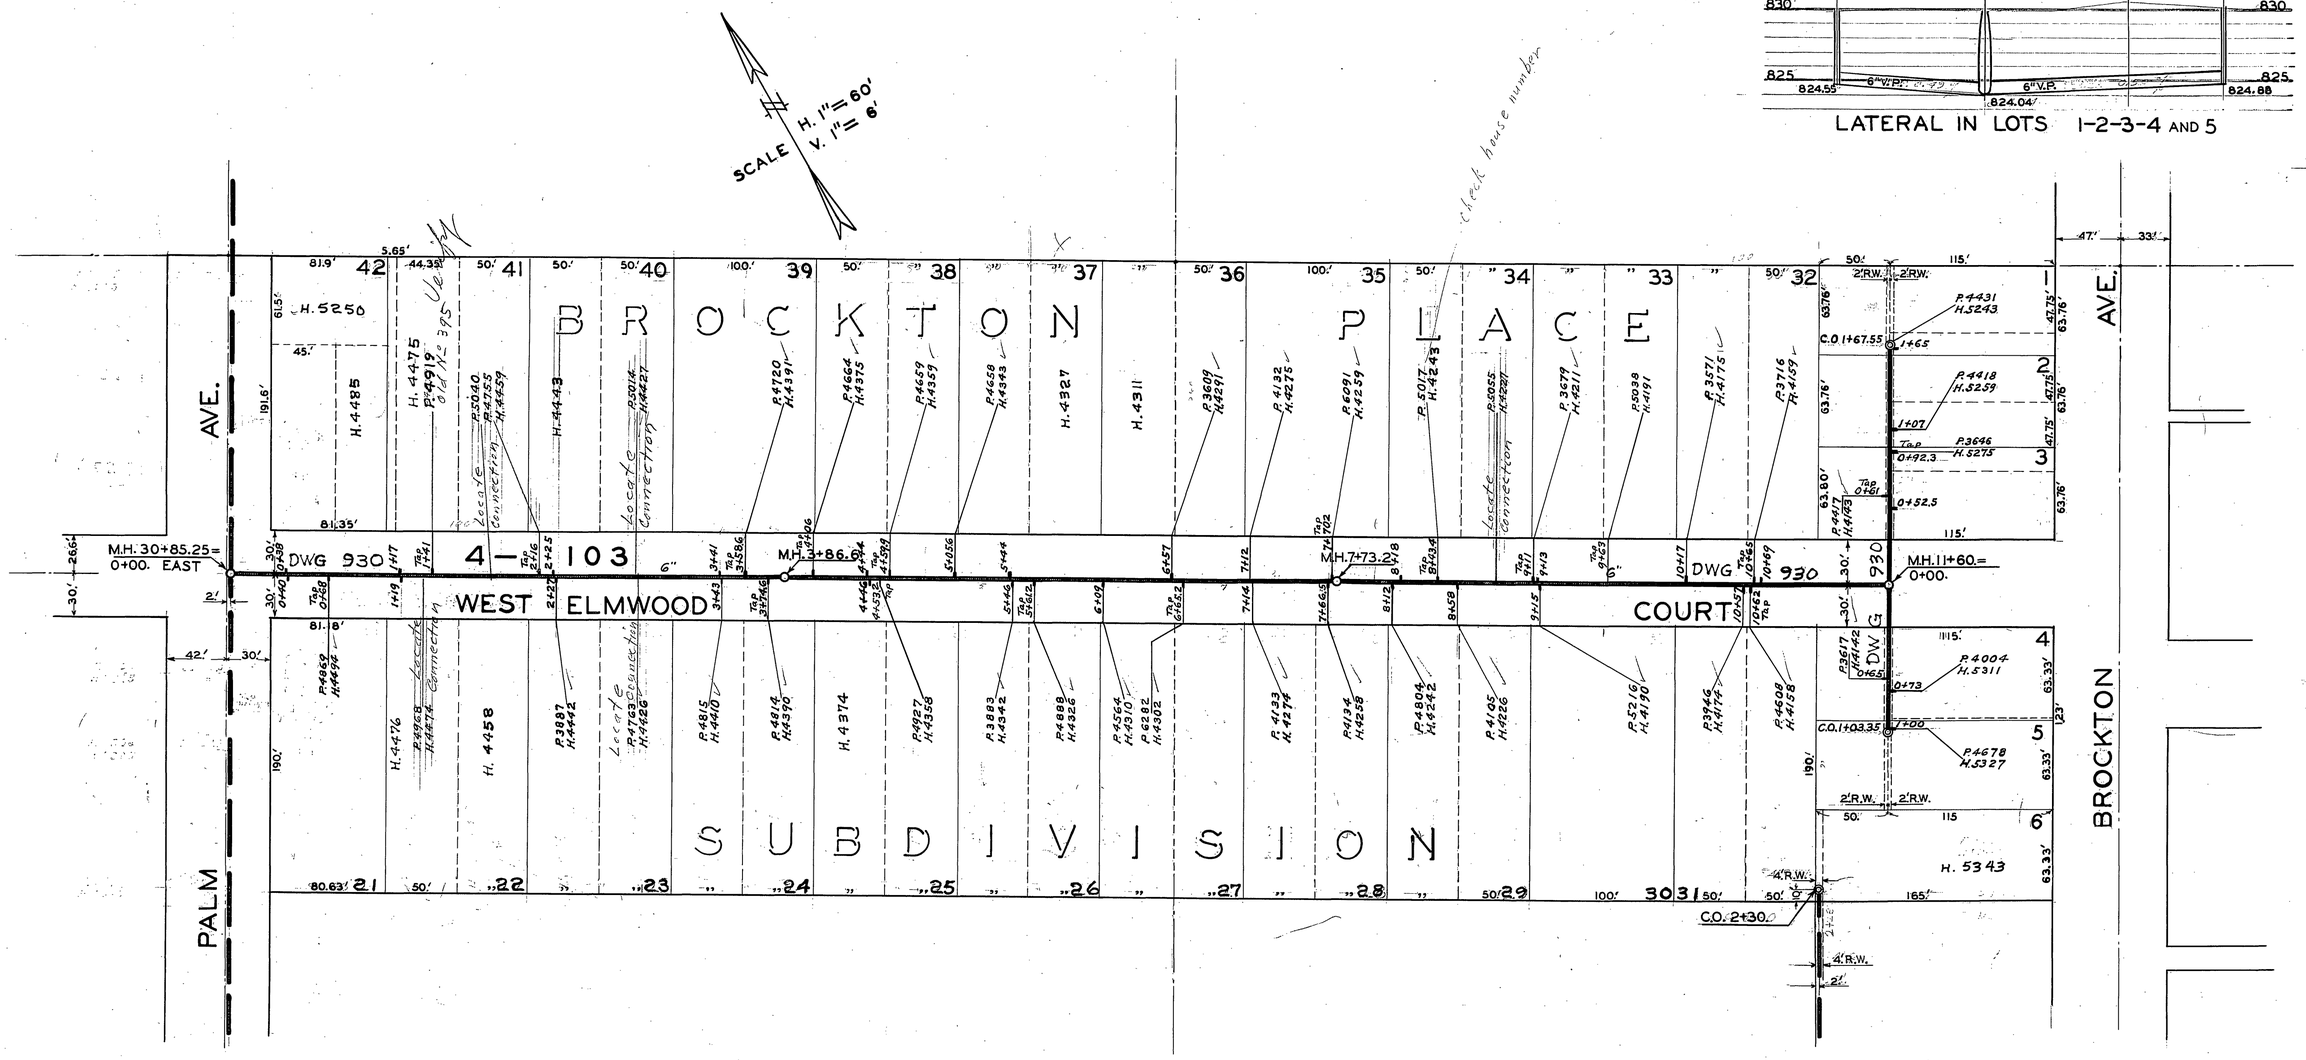
LATERAL IN LOTS 1-2-3-4 AND 5