
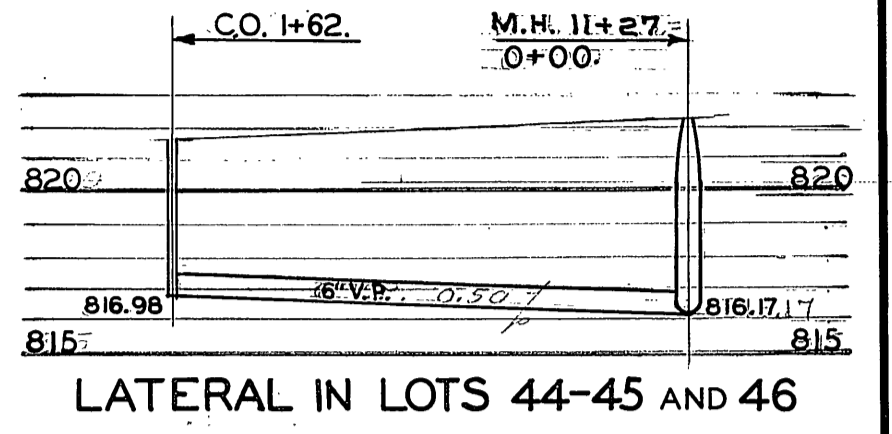


BOOK	THREE	PAGE	25

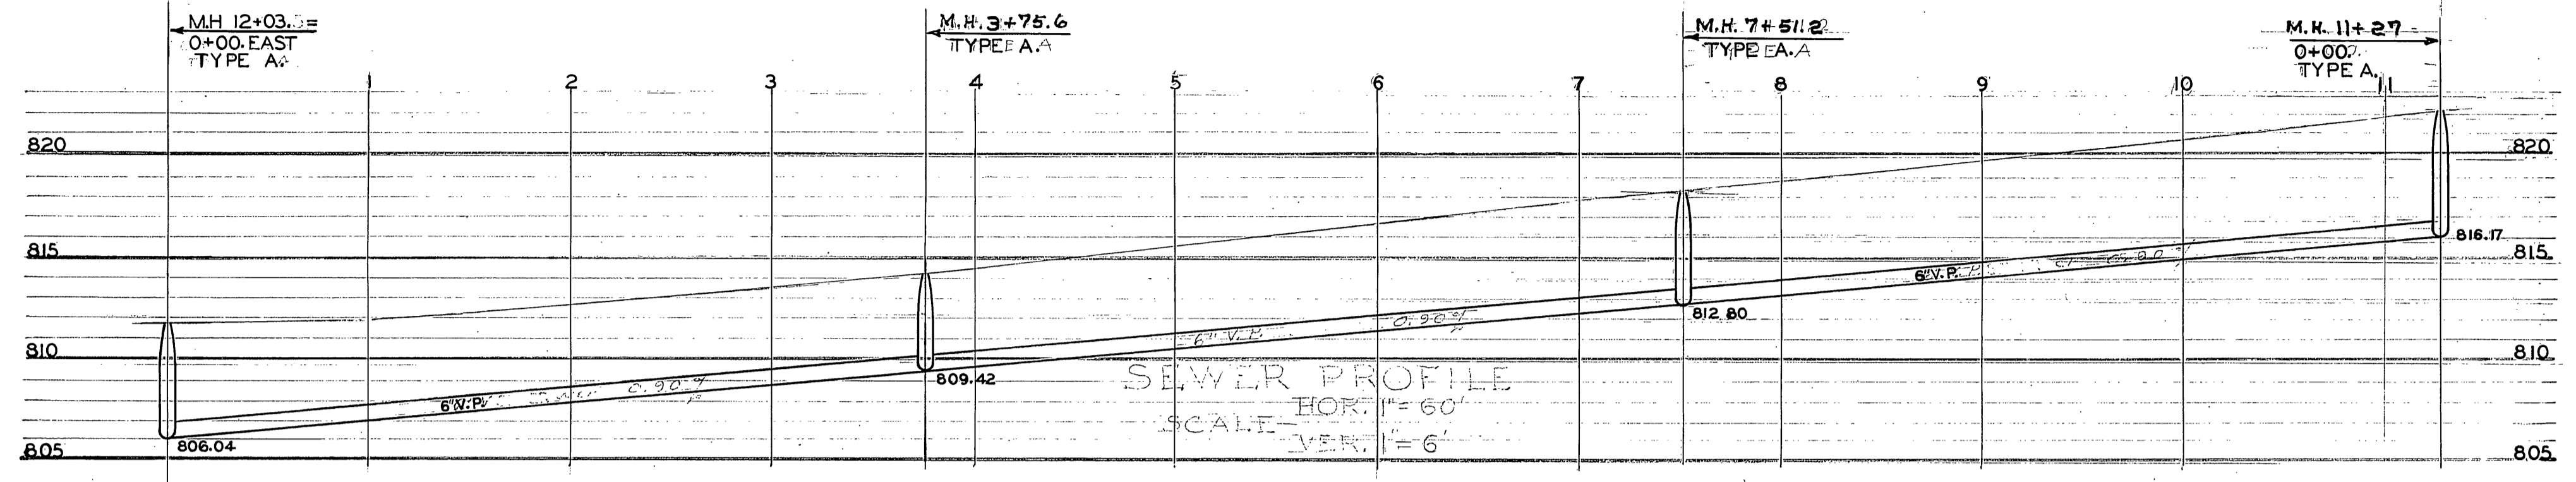


SCALE H. 1" = 60'  
V. 1" = 6'

check location of each

check location

check location

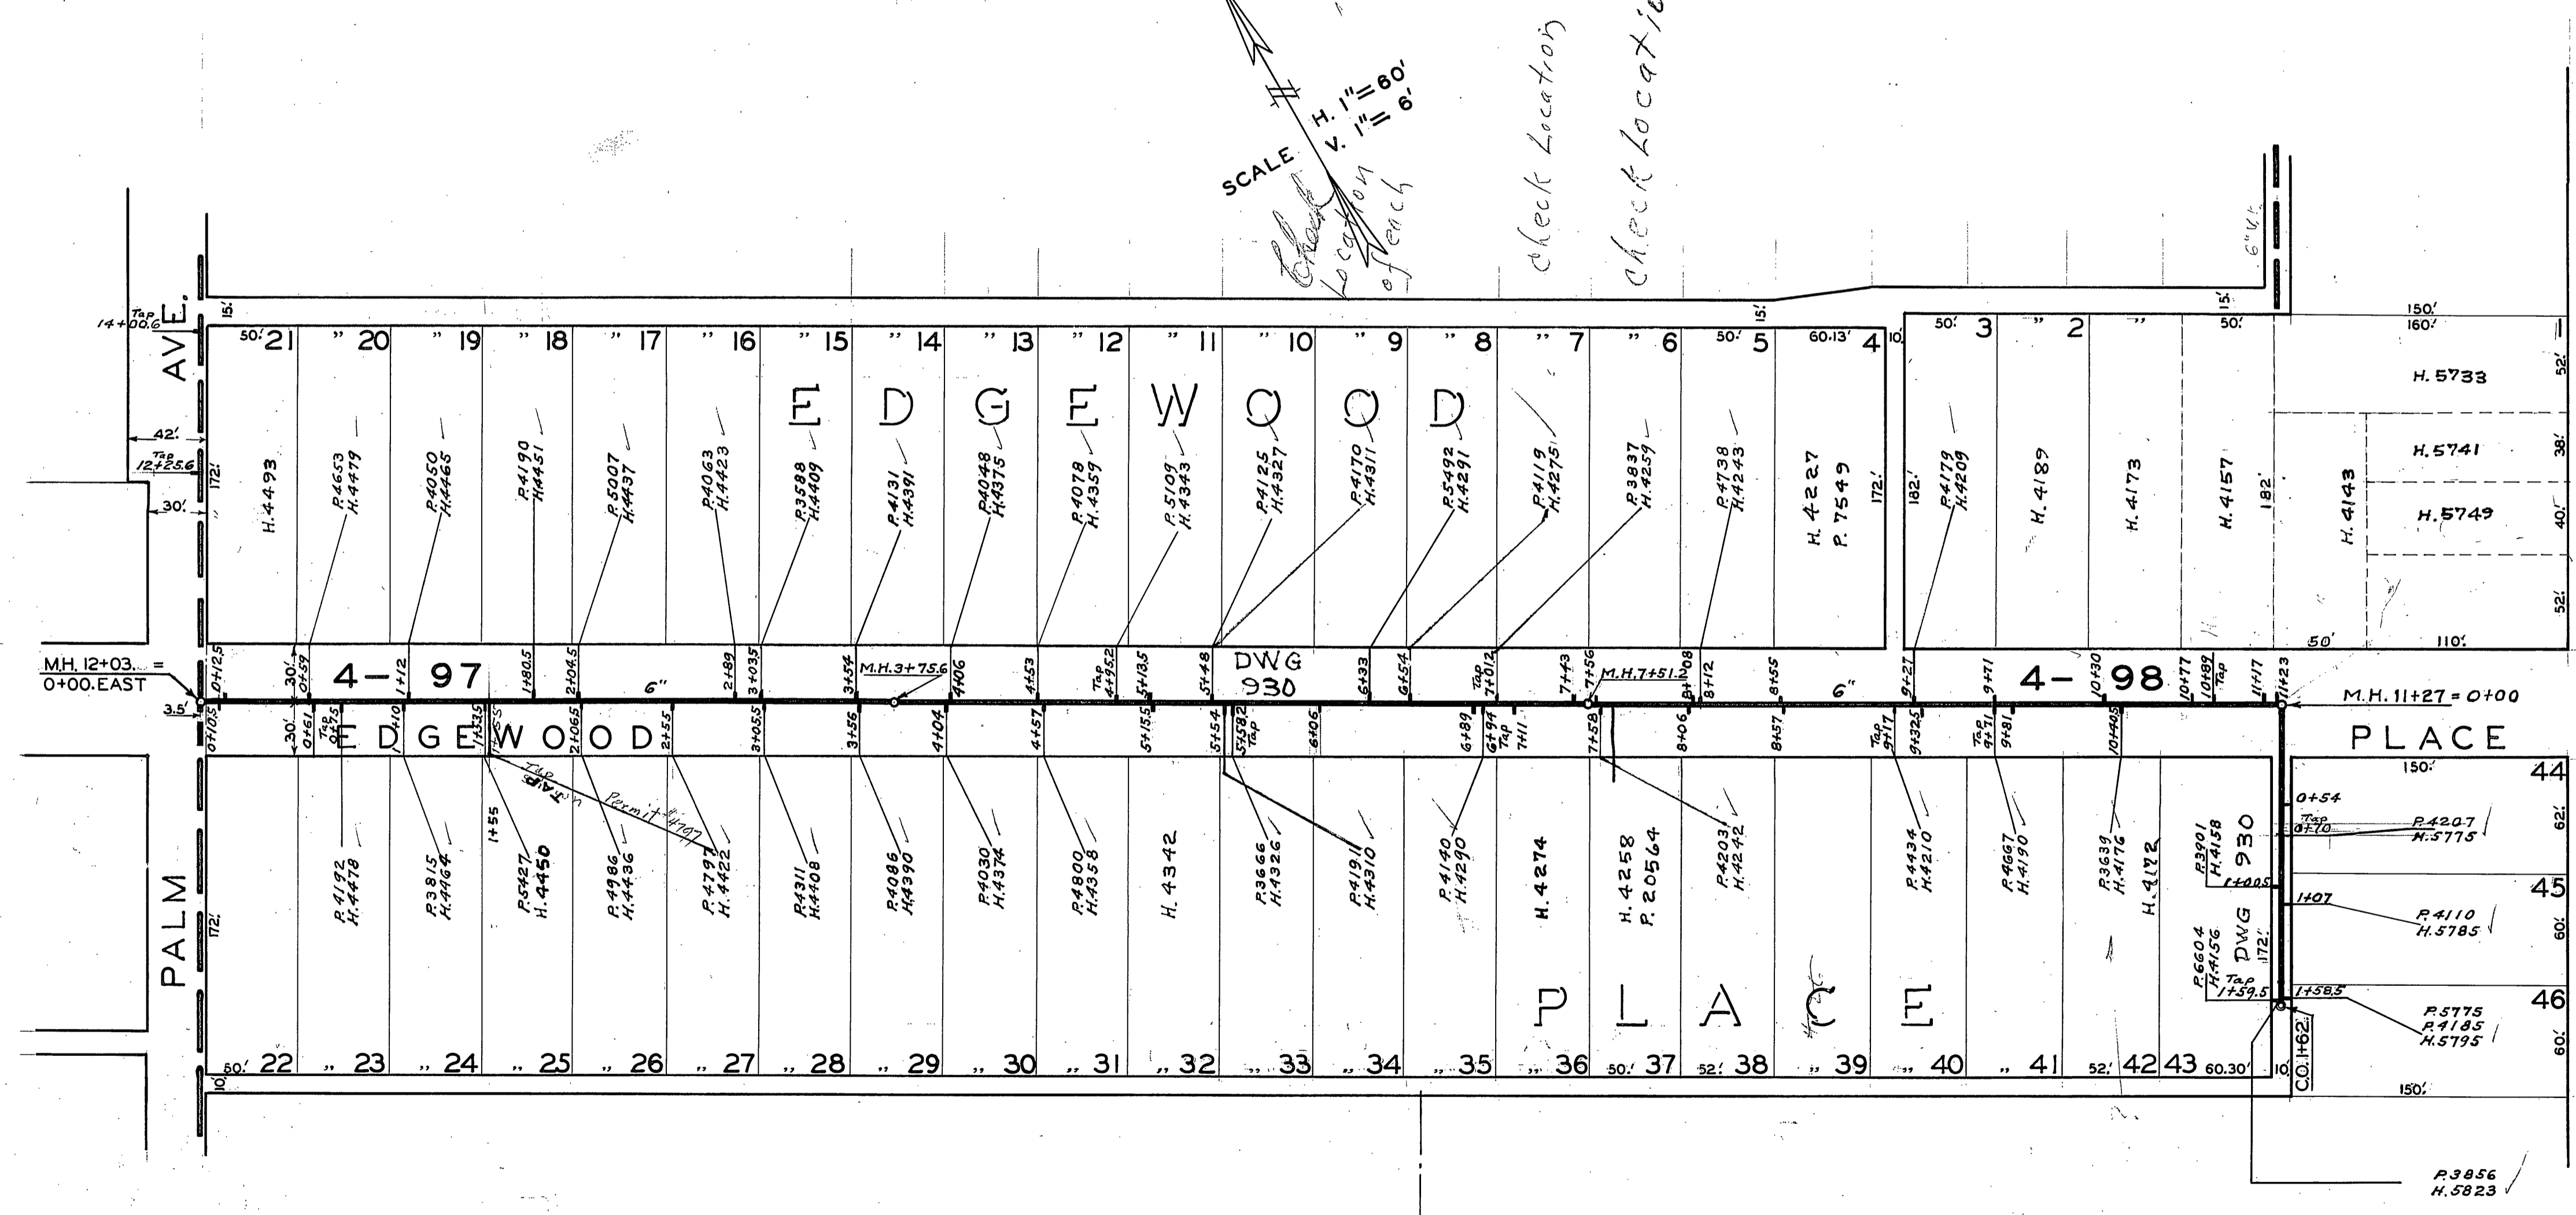

241

240