



BOOK	THREE	PAGE	29

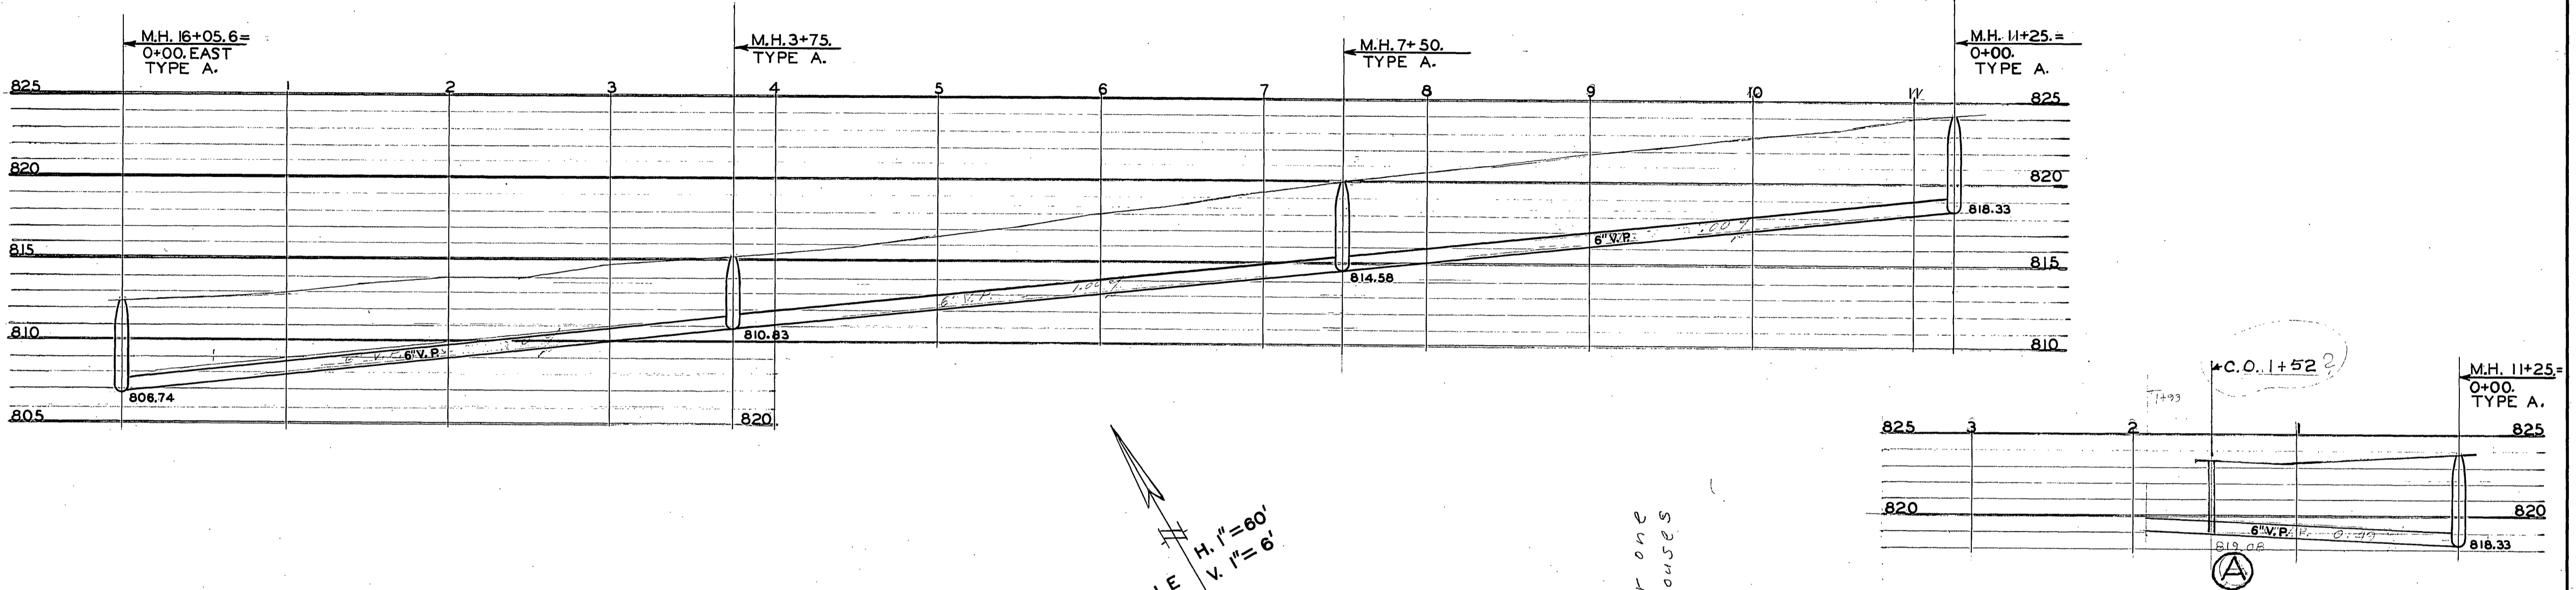

SCALE  
V. 1" = 6'

check for one  
or two houses

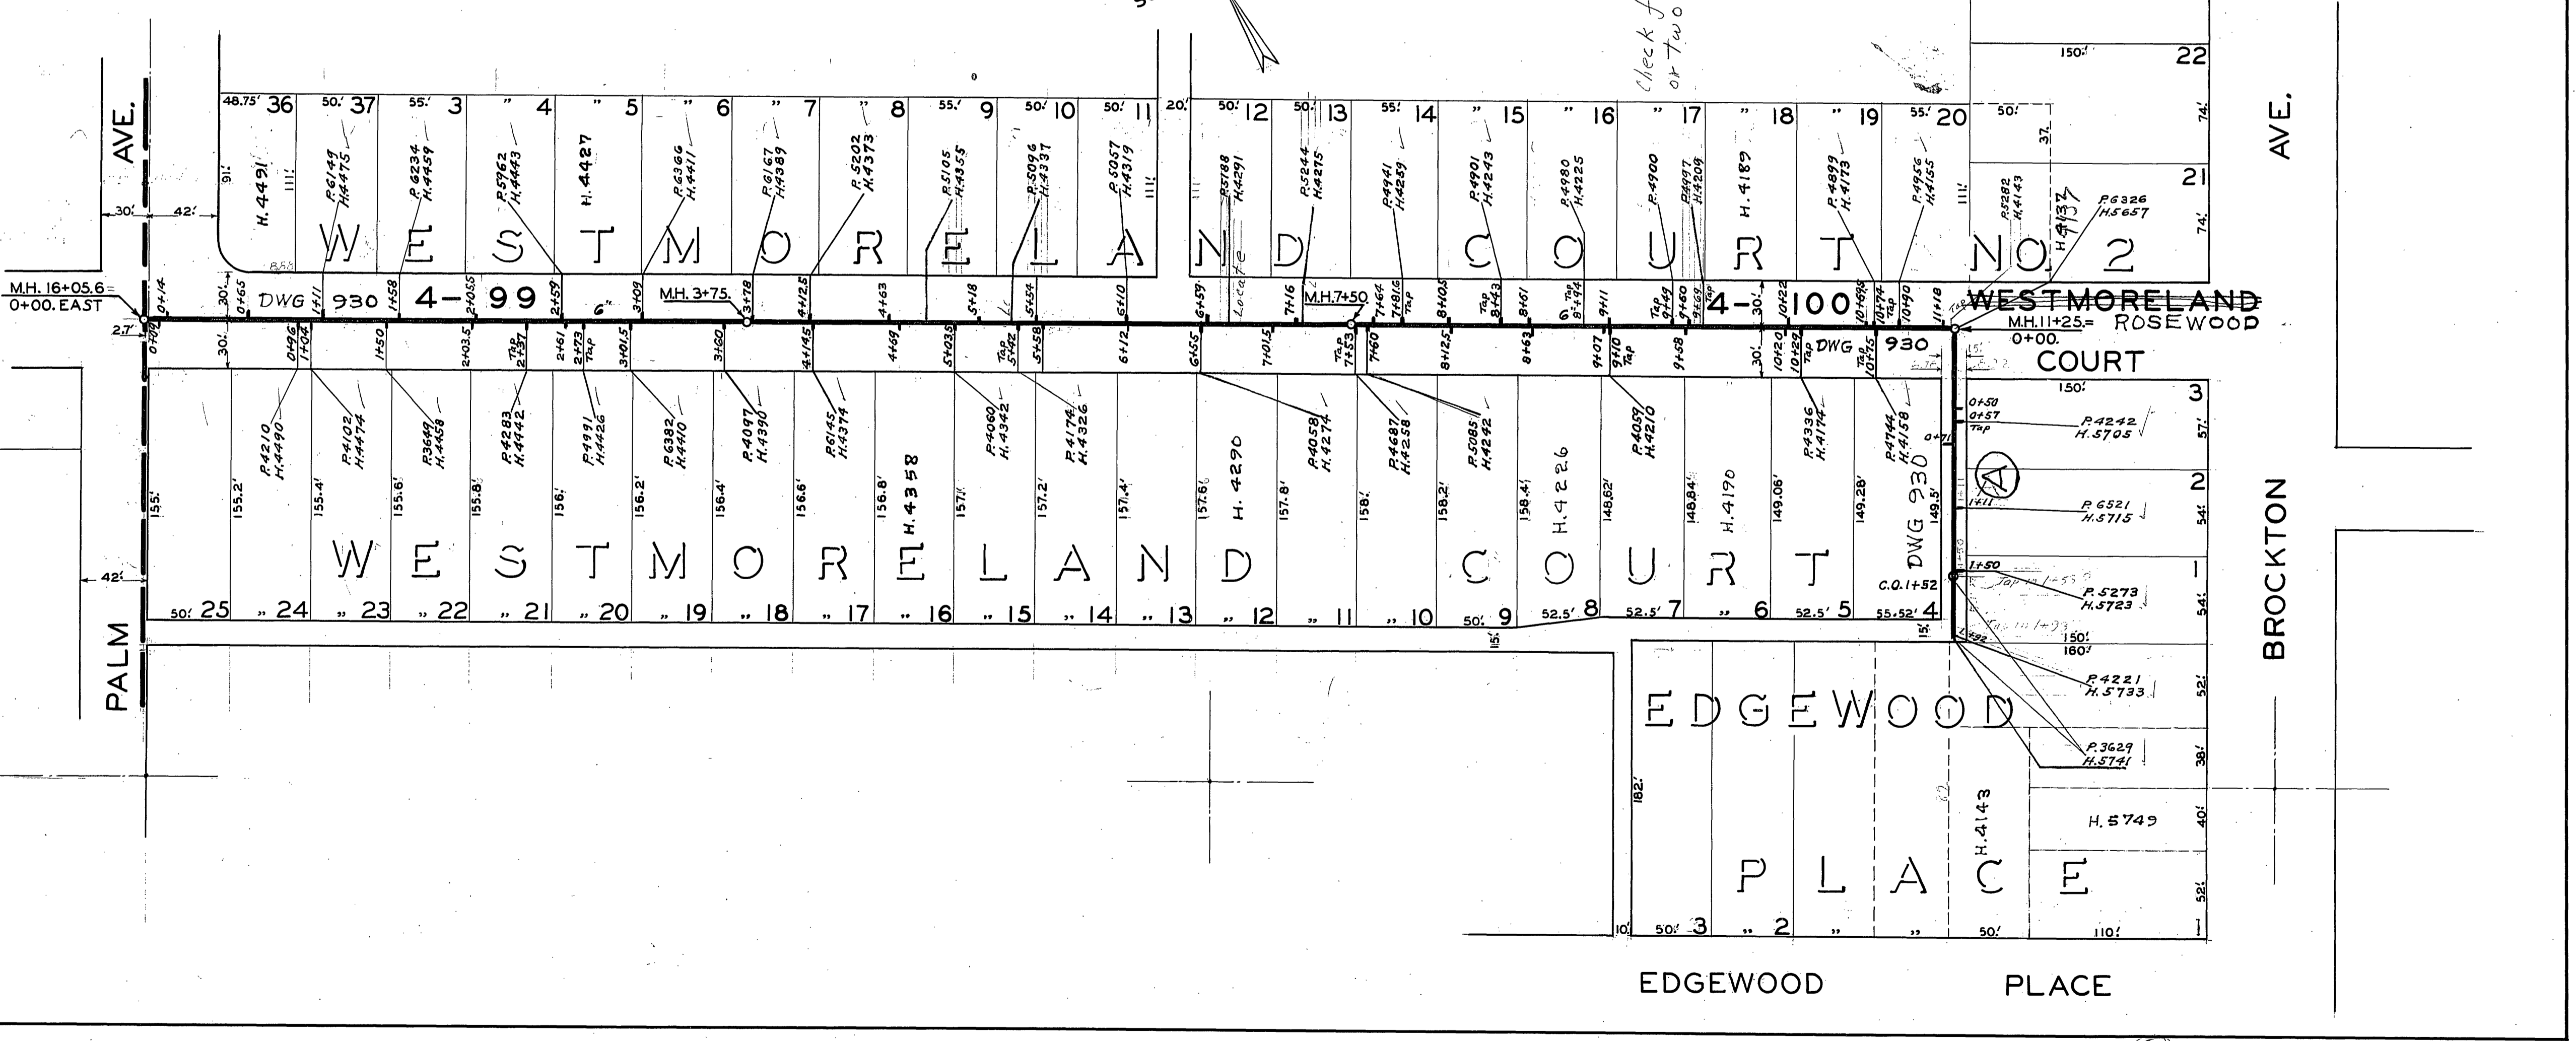

29