
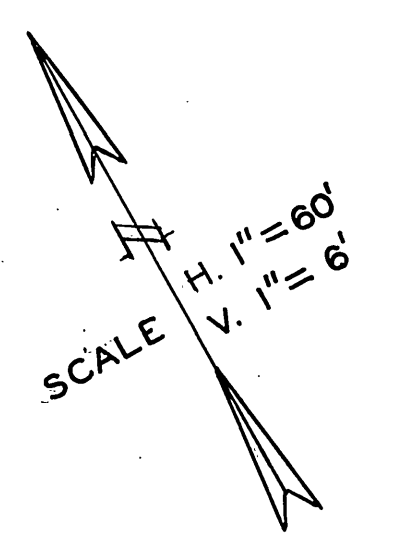
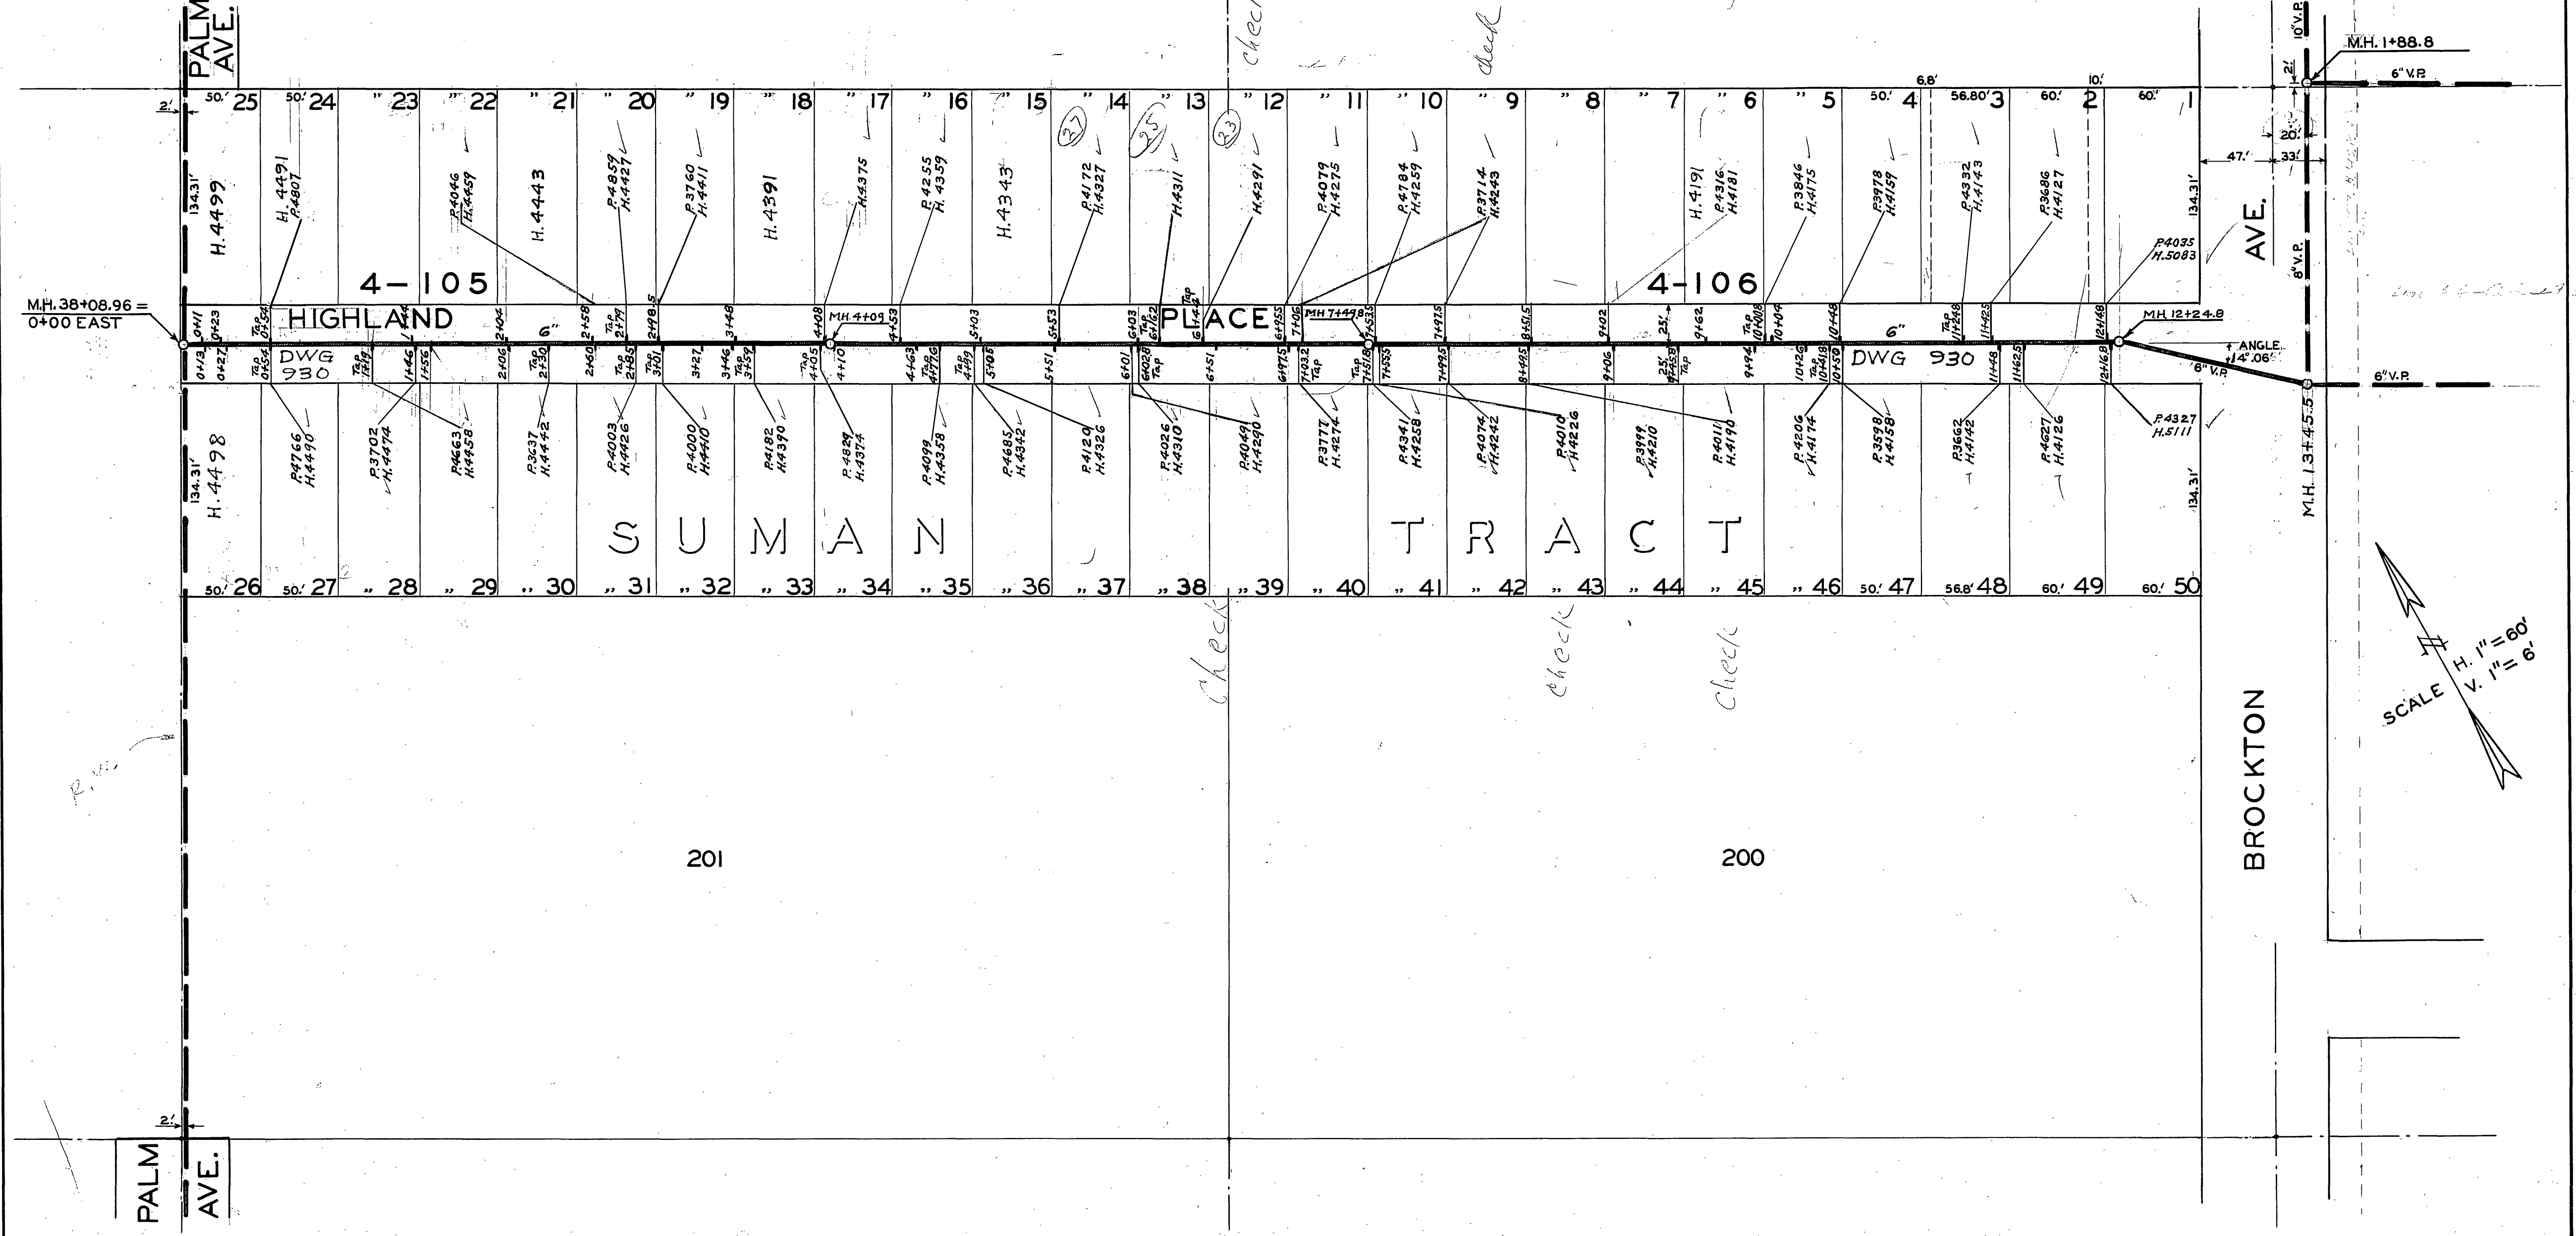
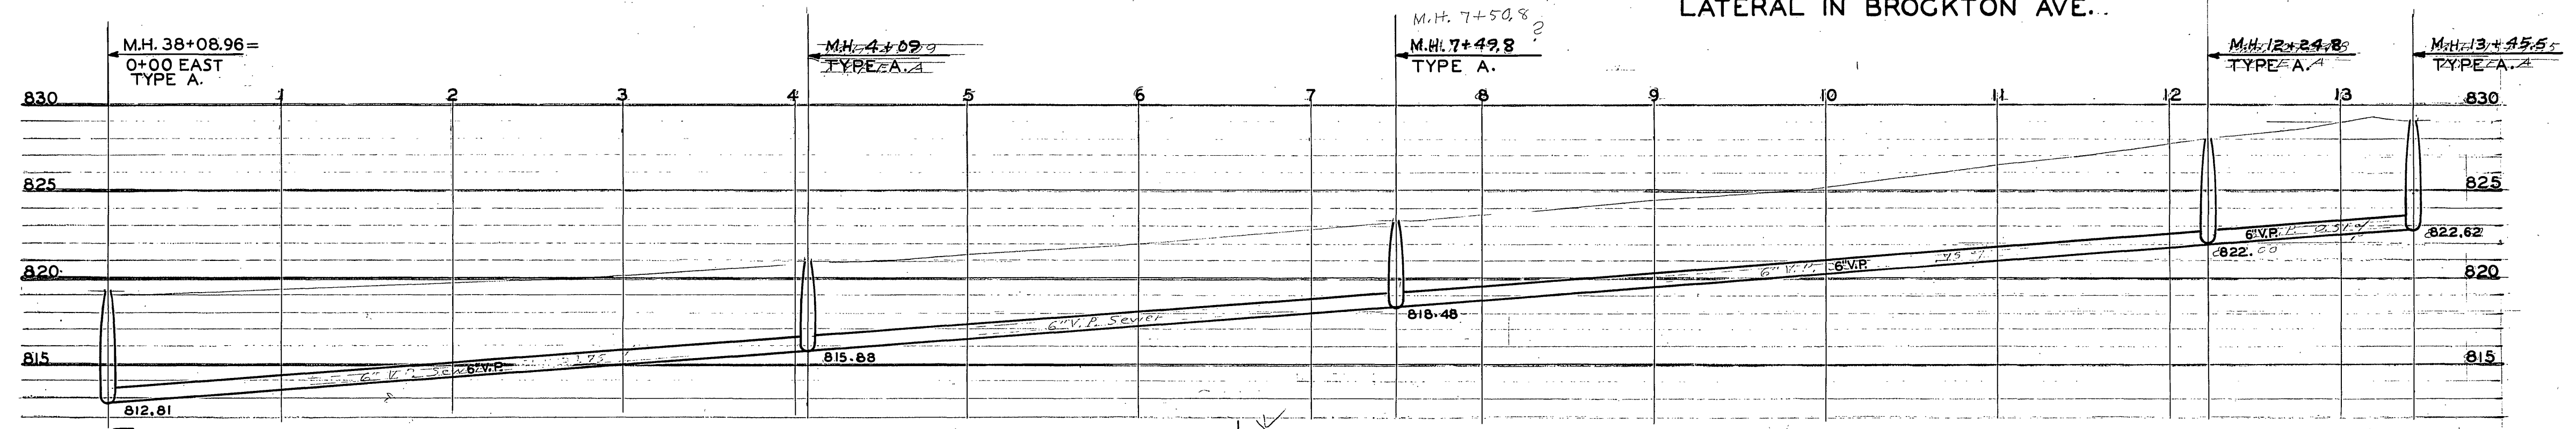


BOOK	THREE	PAGE	30

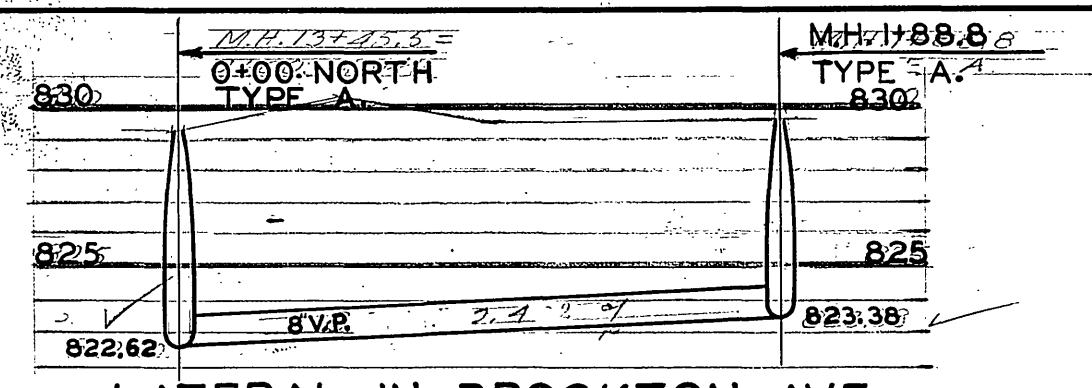

Len. 57 to 58 B. 133

P. 37-33

30