
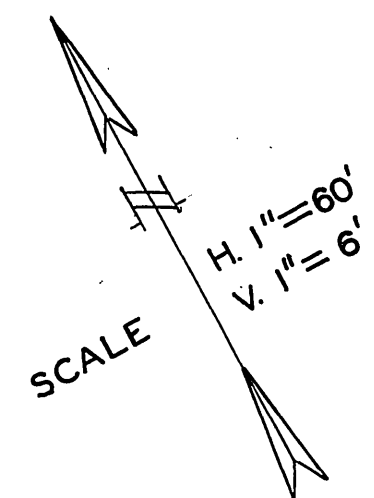


BOOK	THREE	PAGE	31

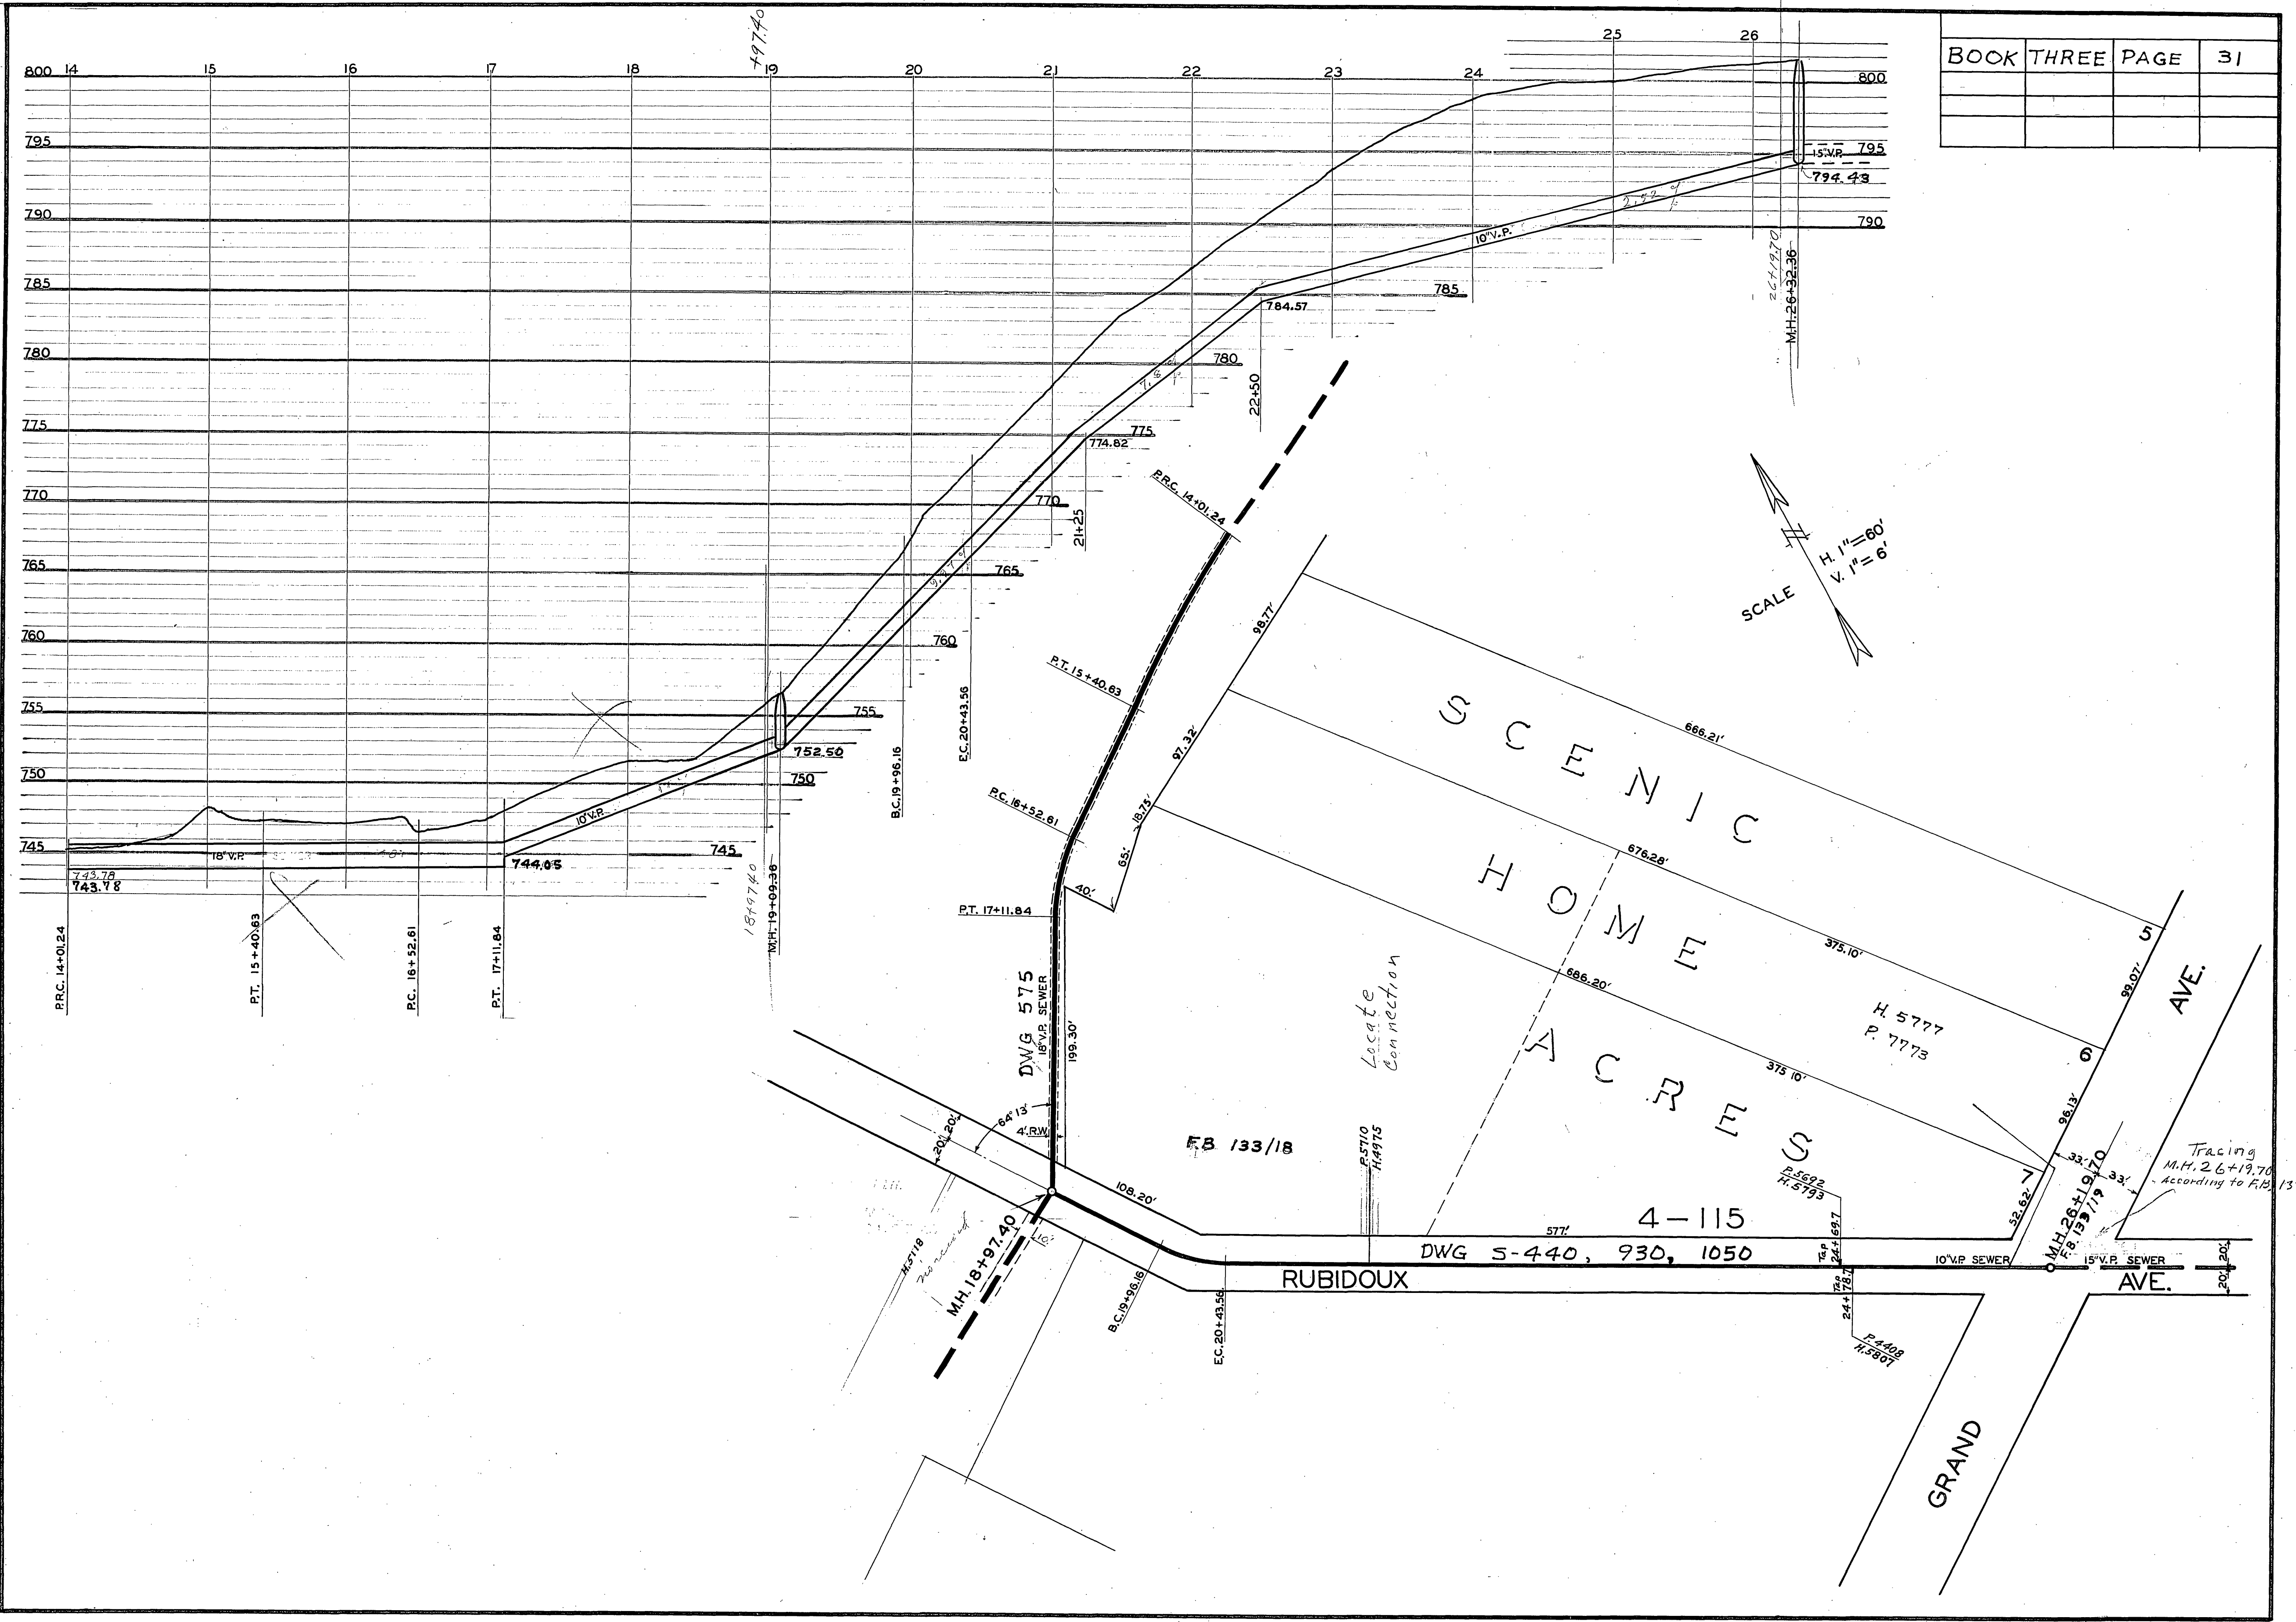

SCENIC  
HOMES  
ACRES

RUBIDOUX

GRAND

AVE.

AVE.