BOOK	THREE	PAGE	32

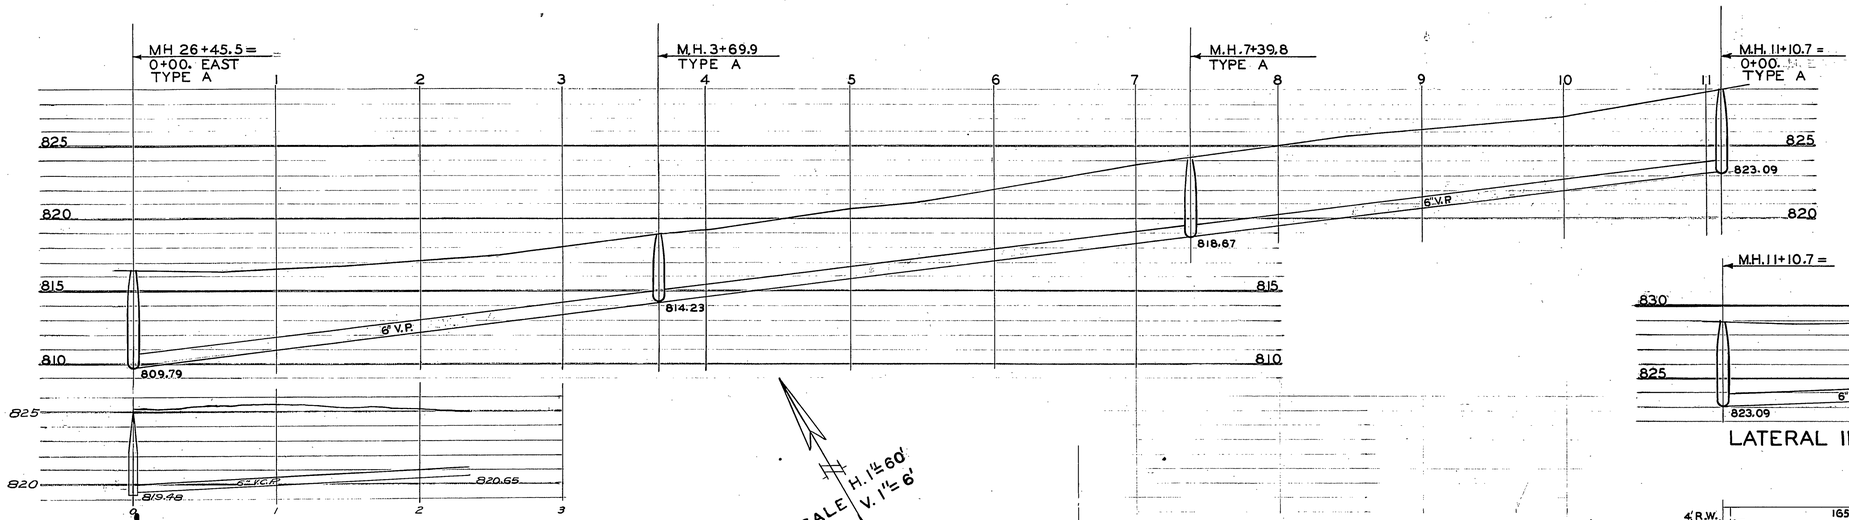



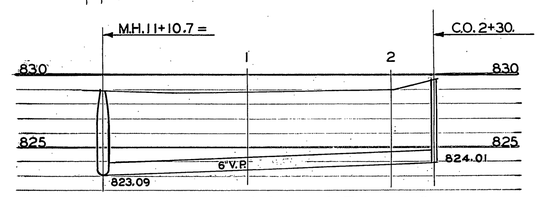
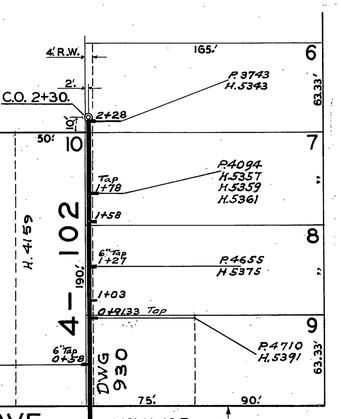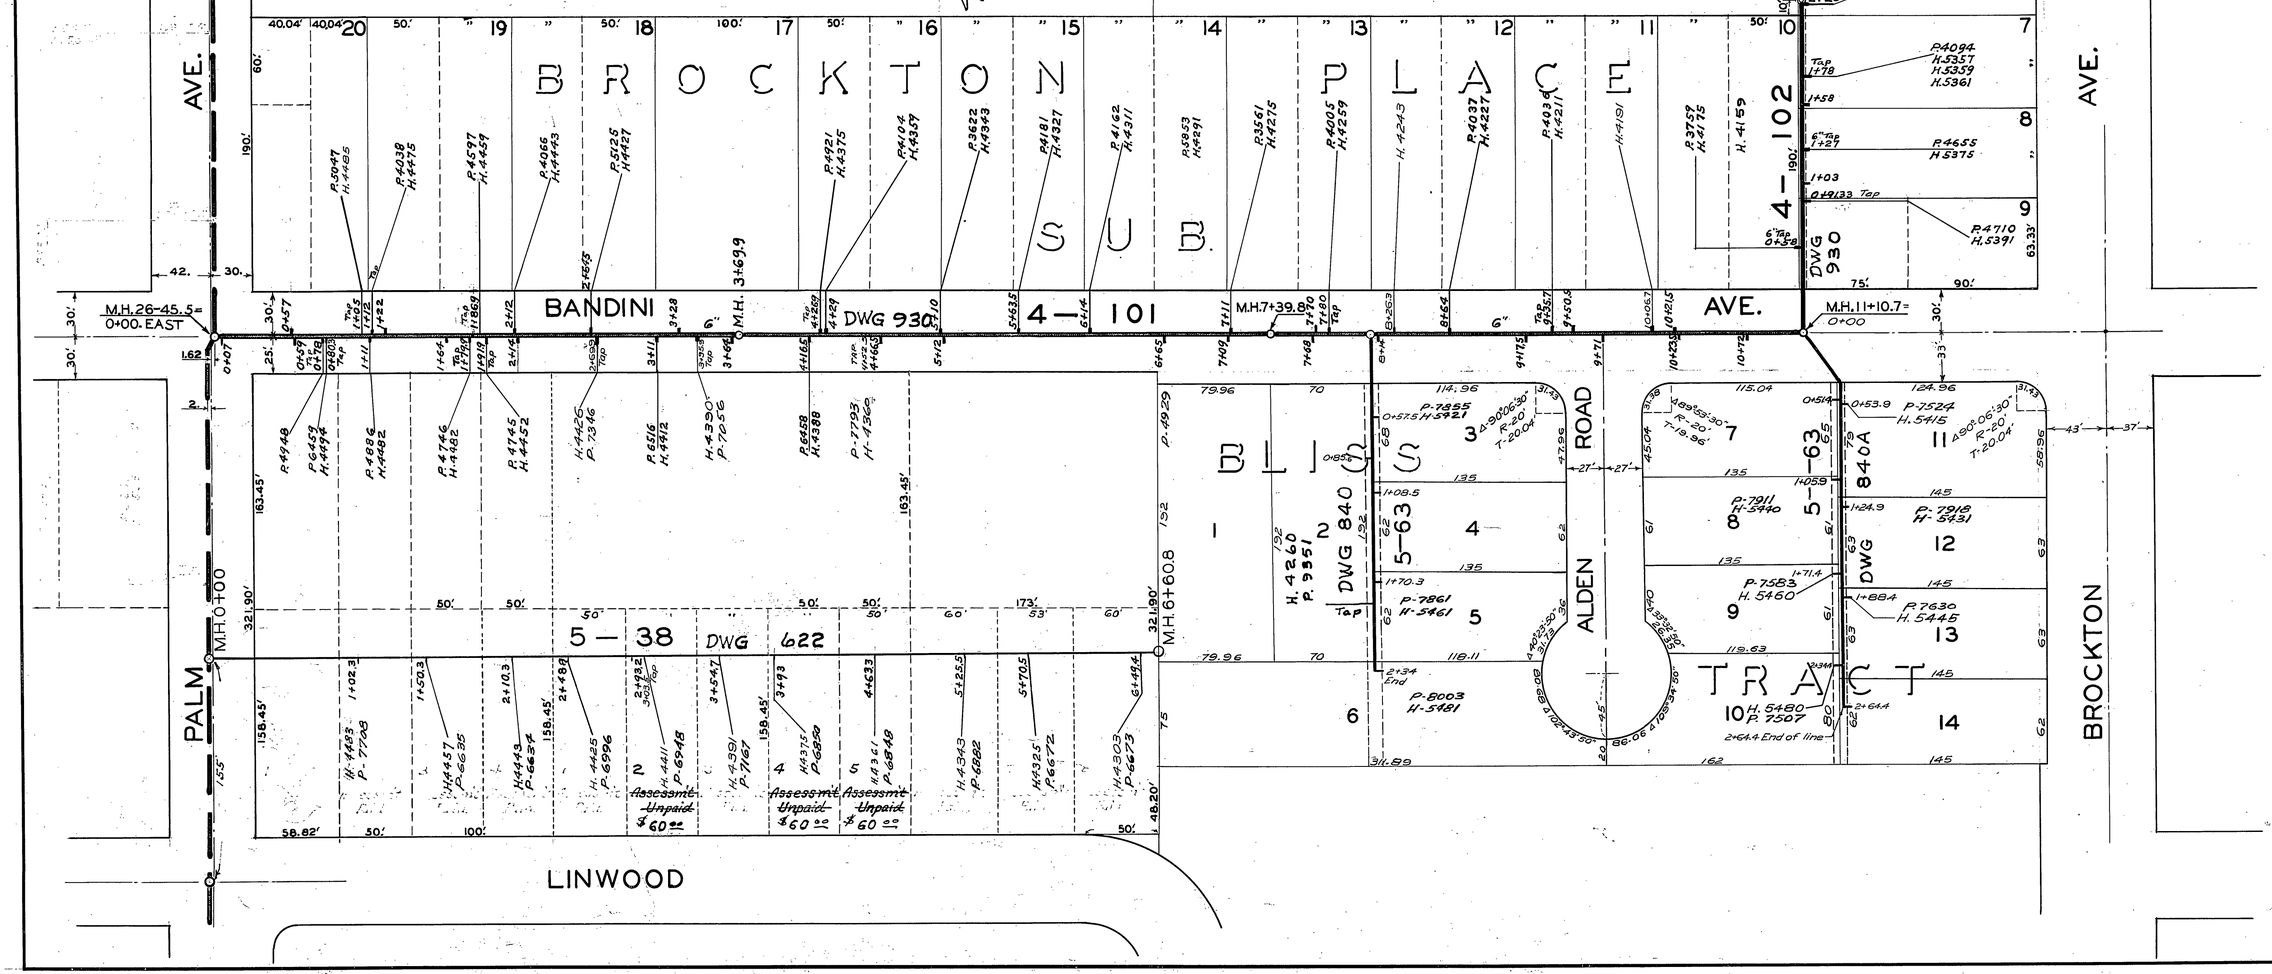
LATERAL IN LOTS 6-7-8 AND 9