
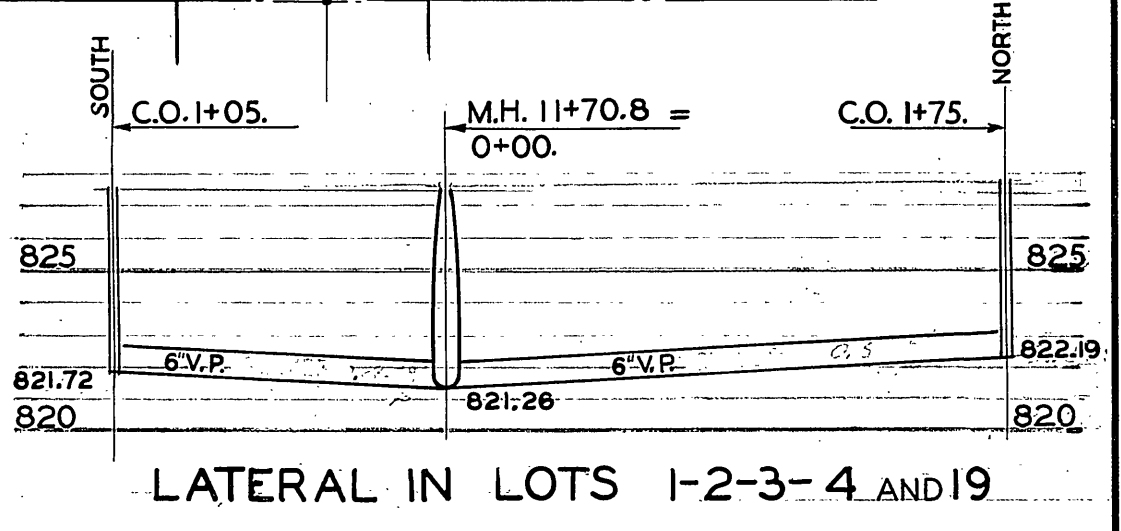
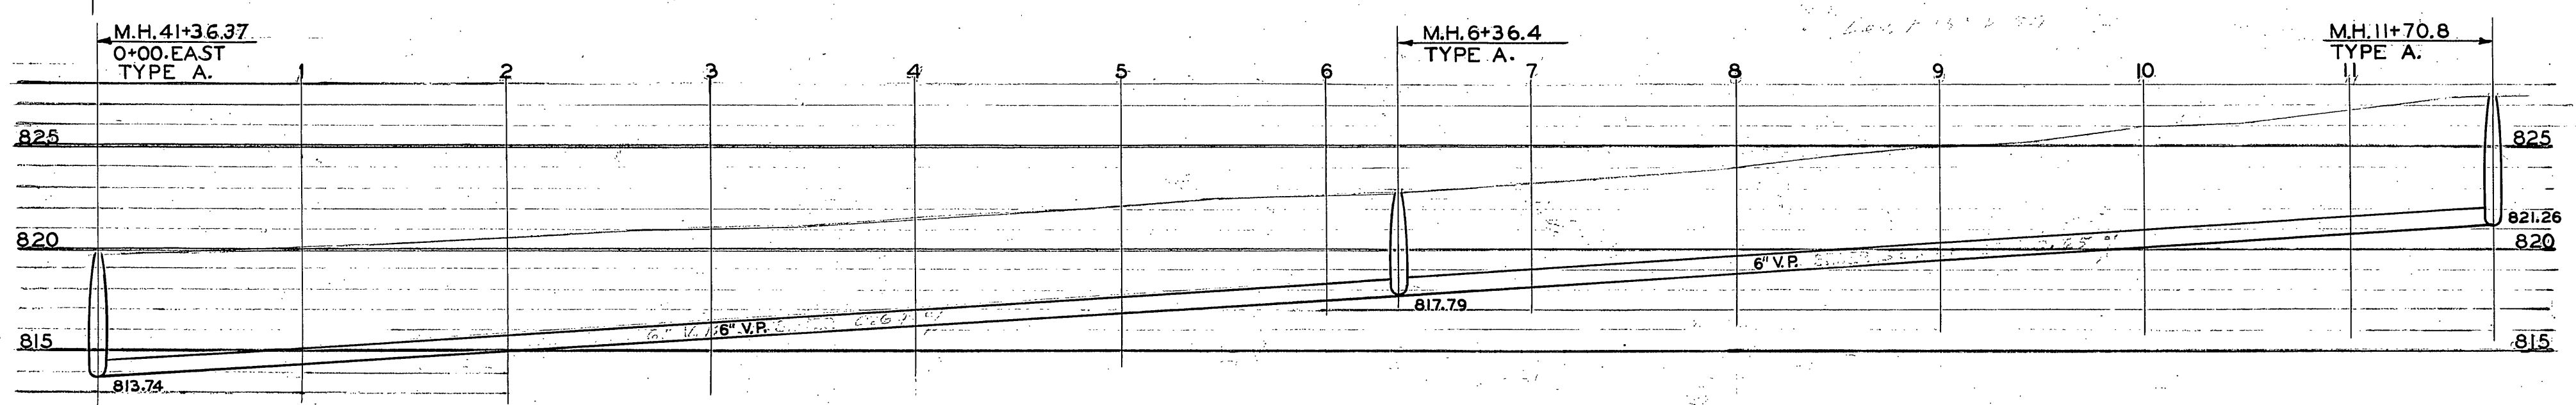
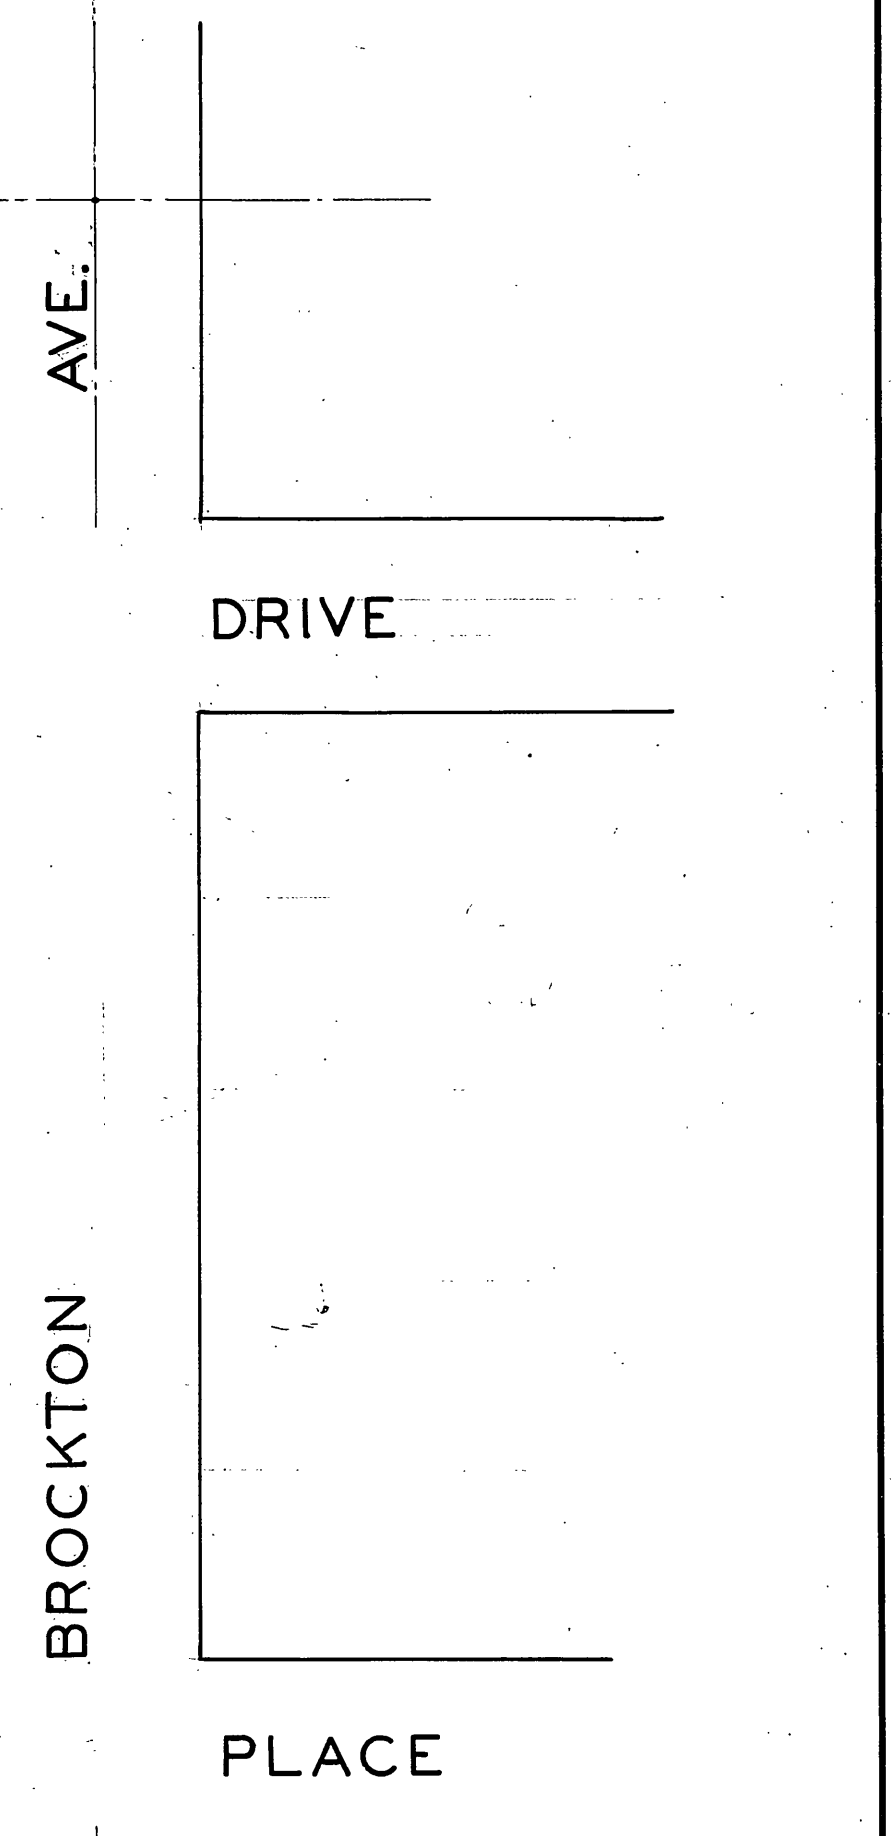
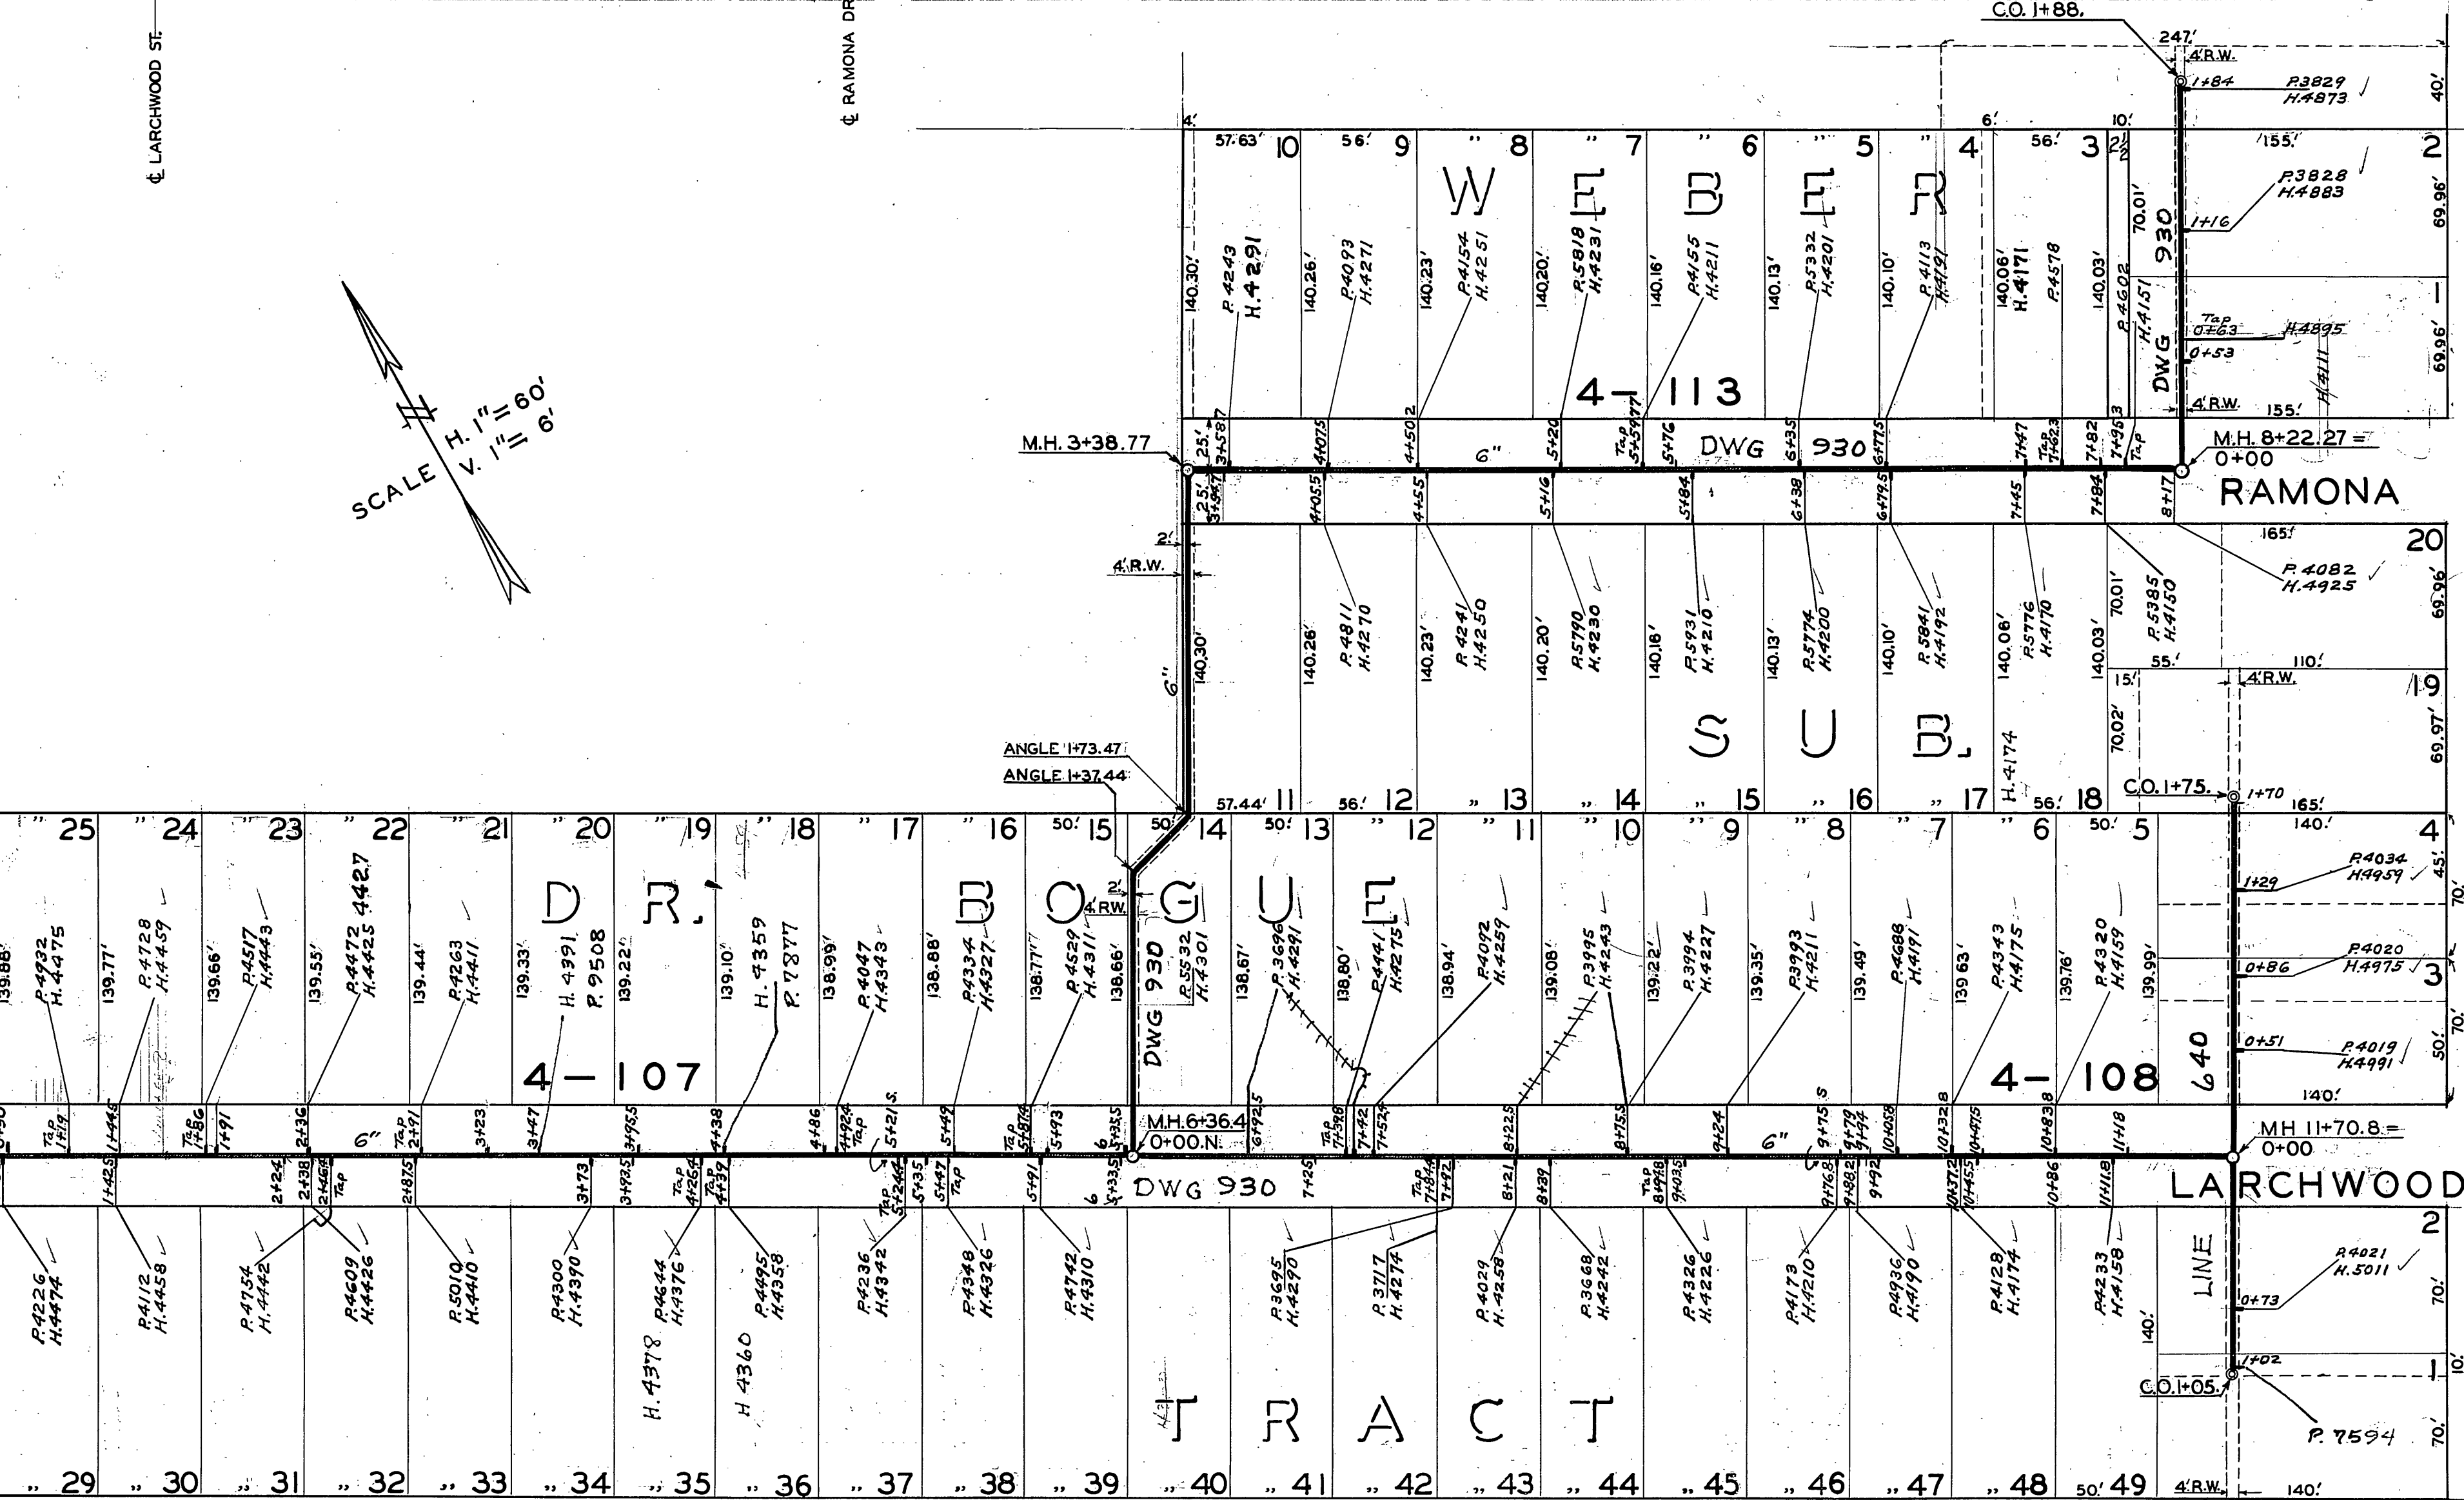


BOOK	THREE	PAGE	33

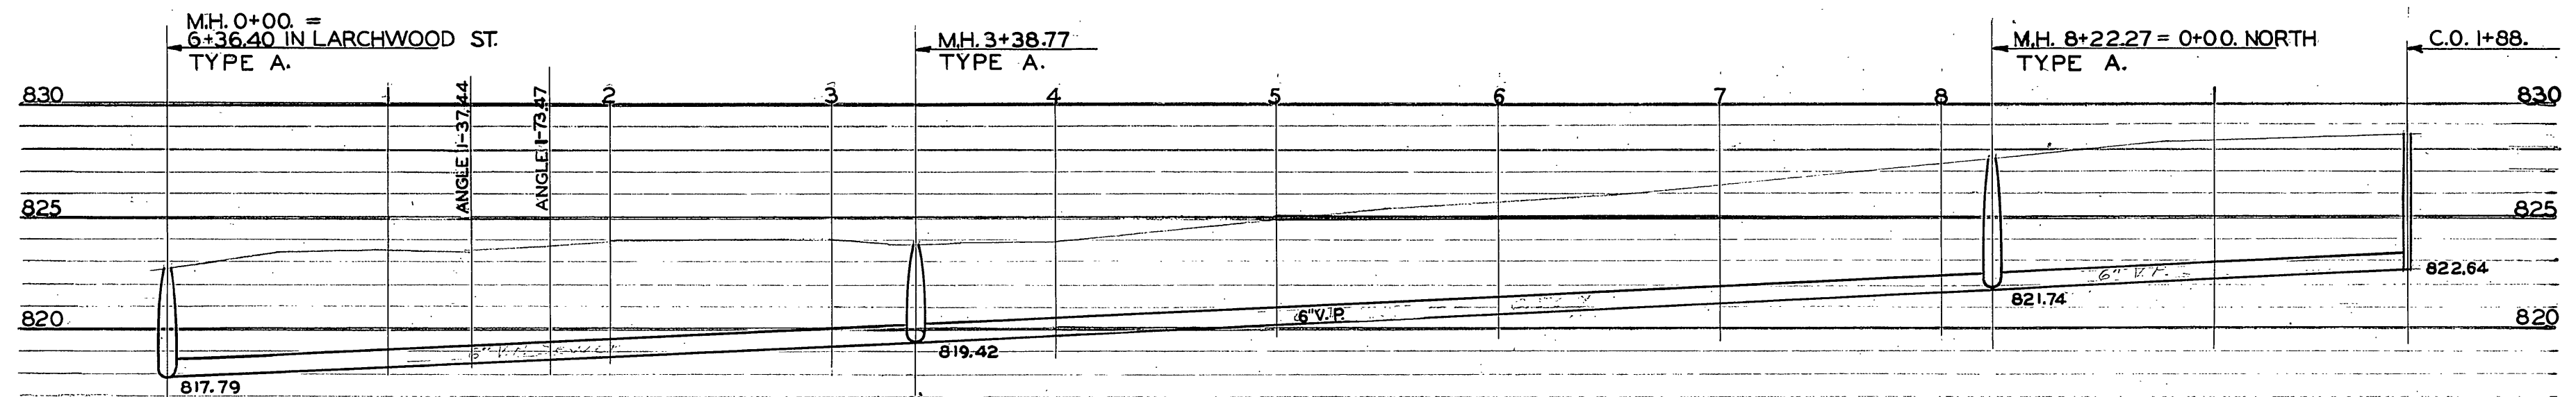

SCALE H. 1" = 60'  
V. 1" = 6'

L.M. DD-EE P. 484  
L.M. DD-EE P. 484  
L.M. DD-EE P. 484