

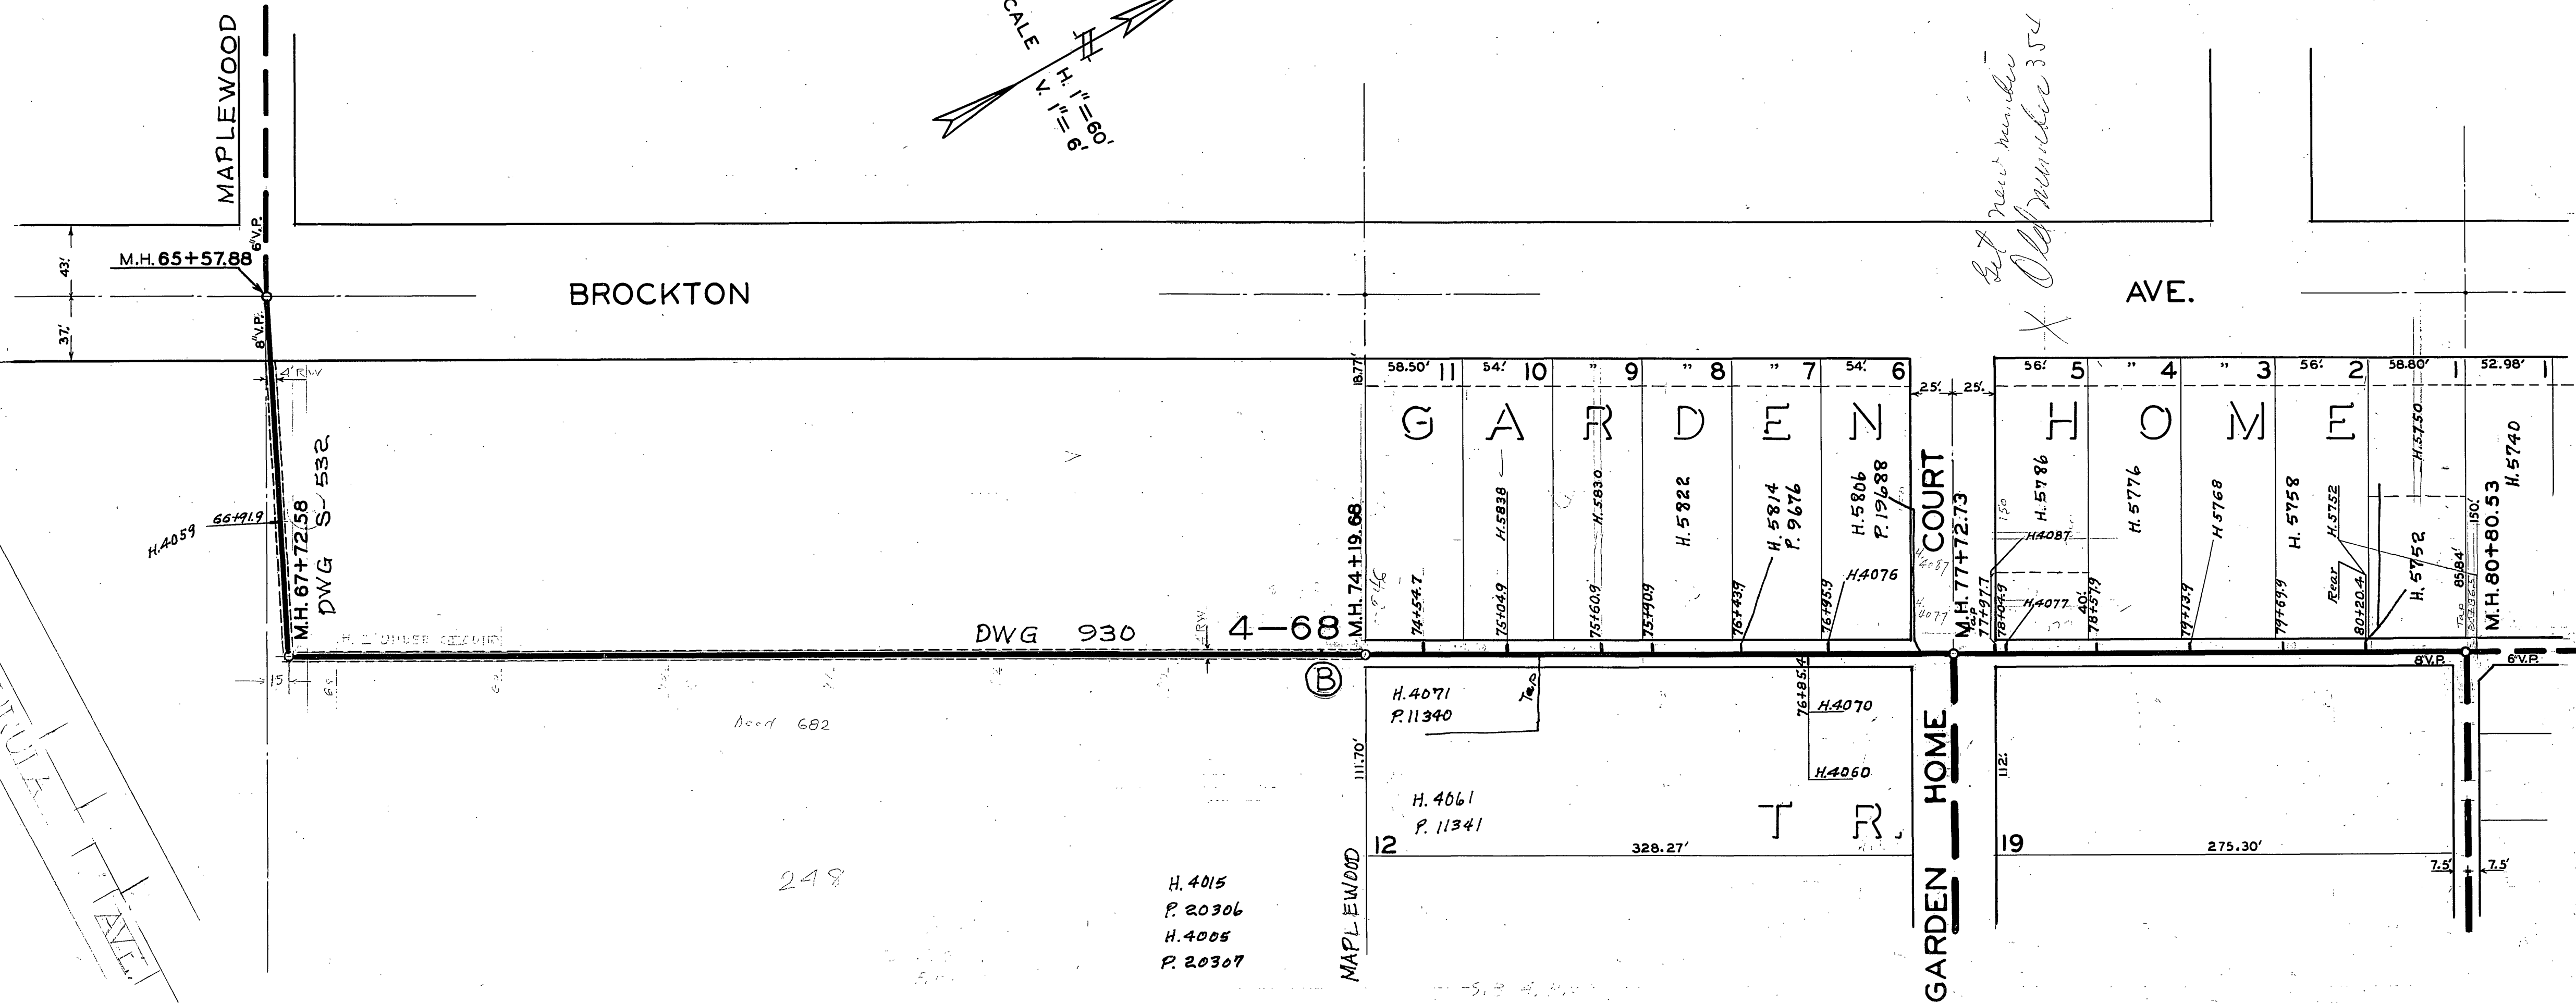
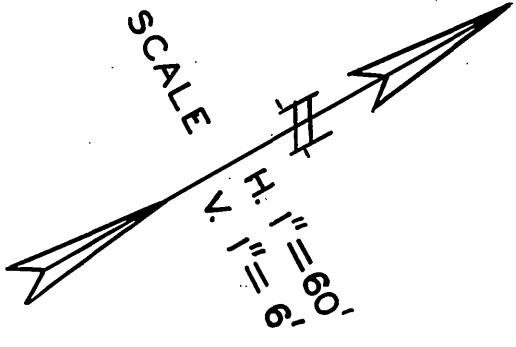
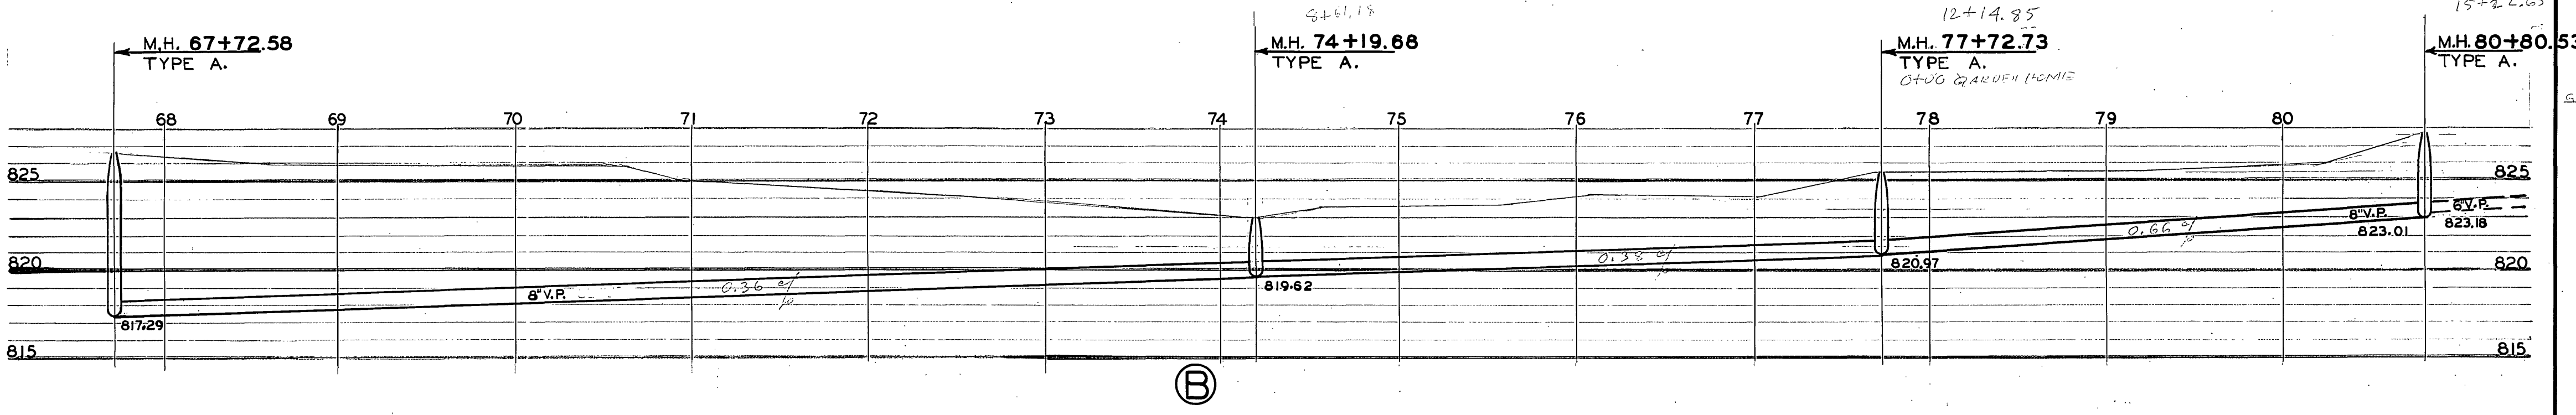


BOOK	THREE	PAGE	35

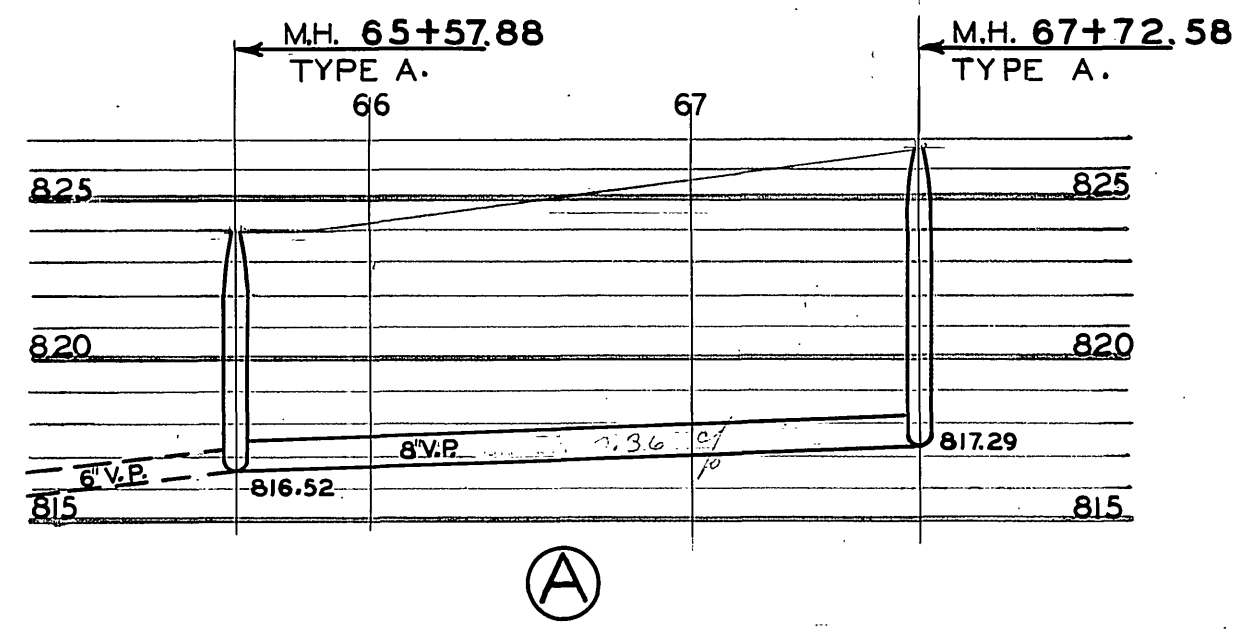

*set new number  
Old number 354*

*133, P. 38*

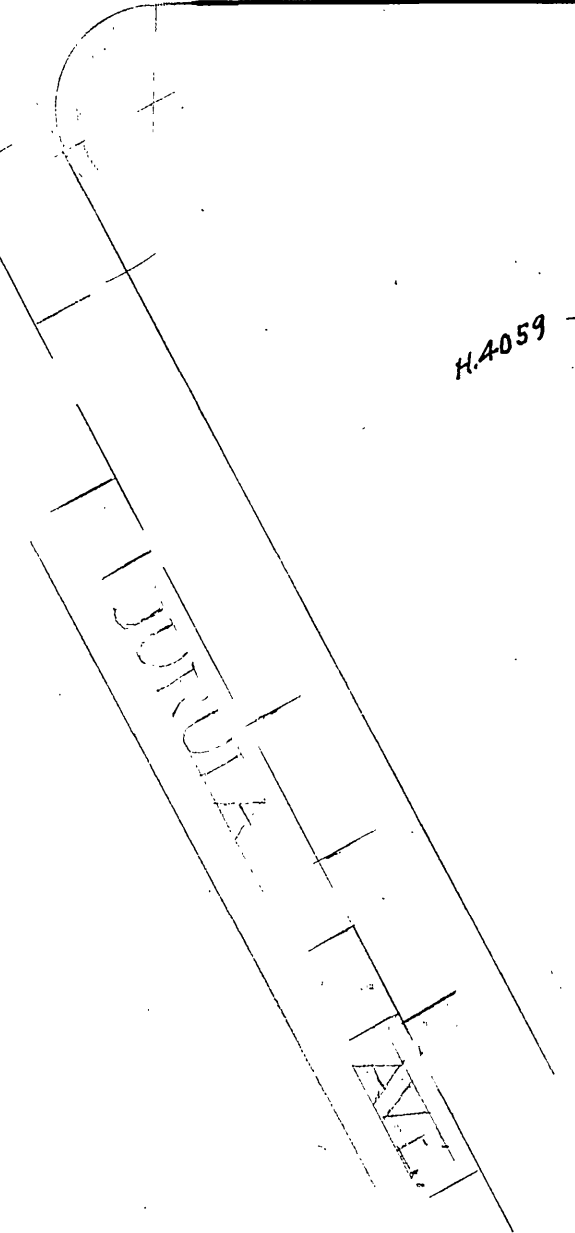

H. 4015  
P. 20306  
H. 4005  
P. 20307

ELEV. 133, P. 38.