

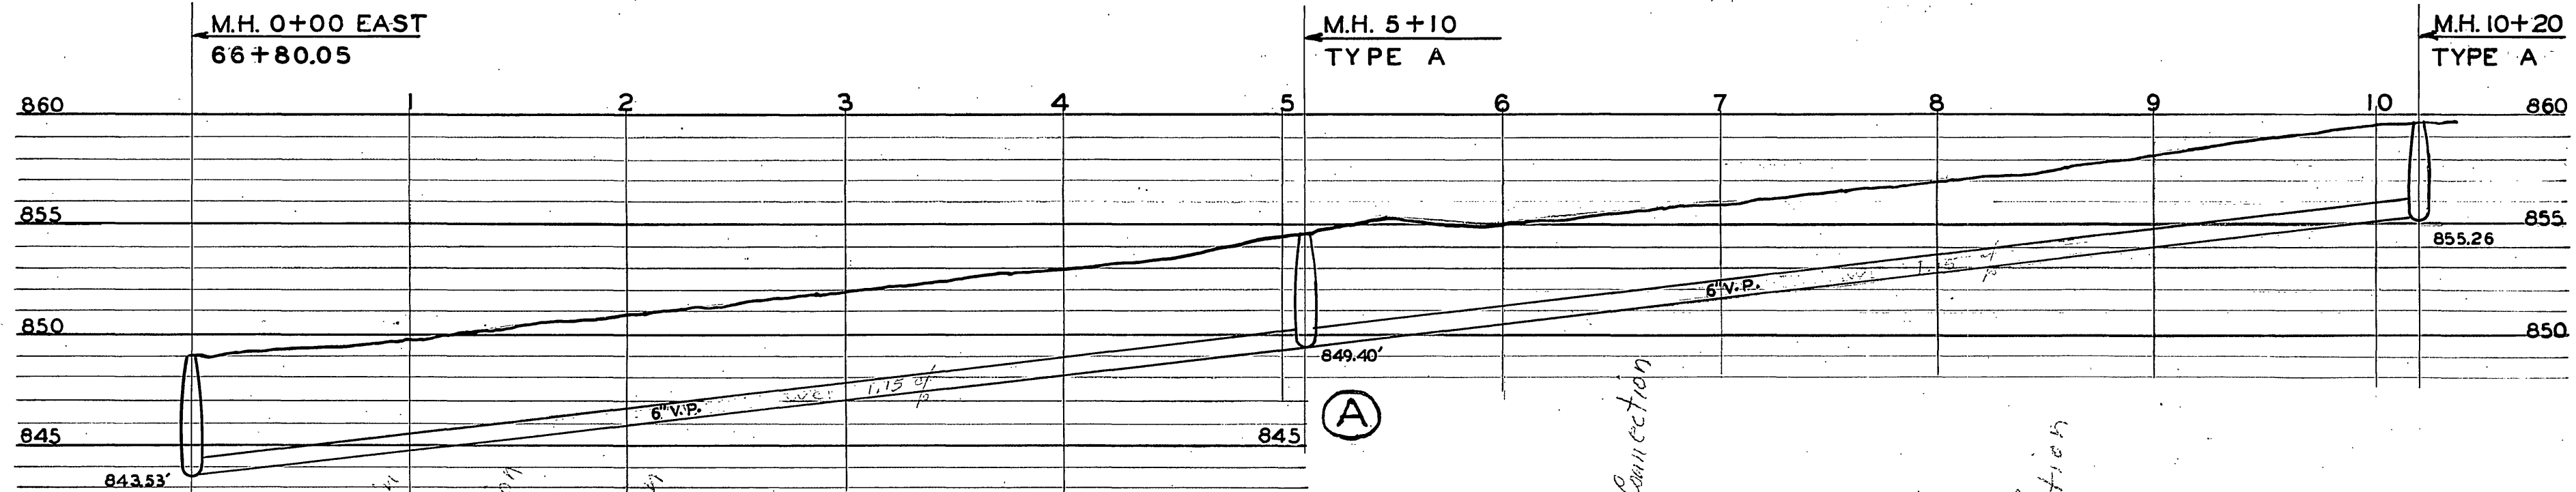
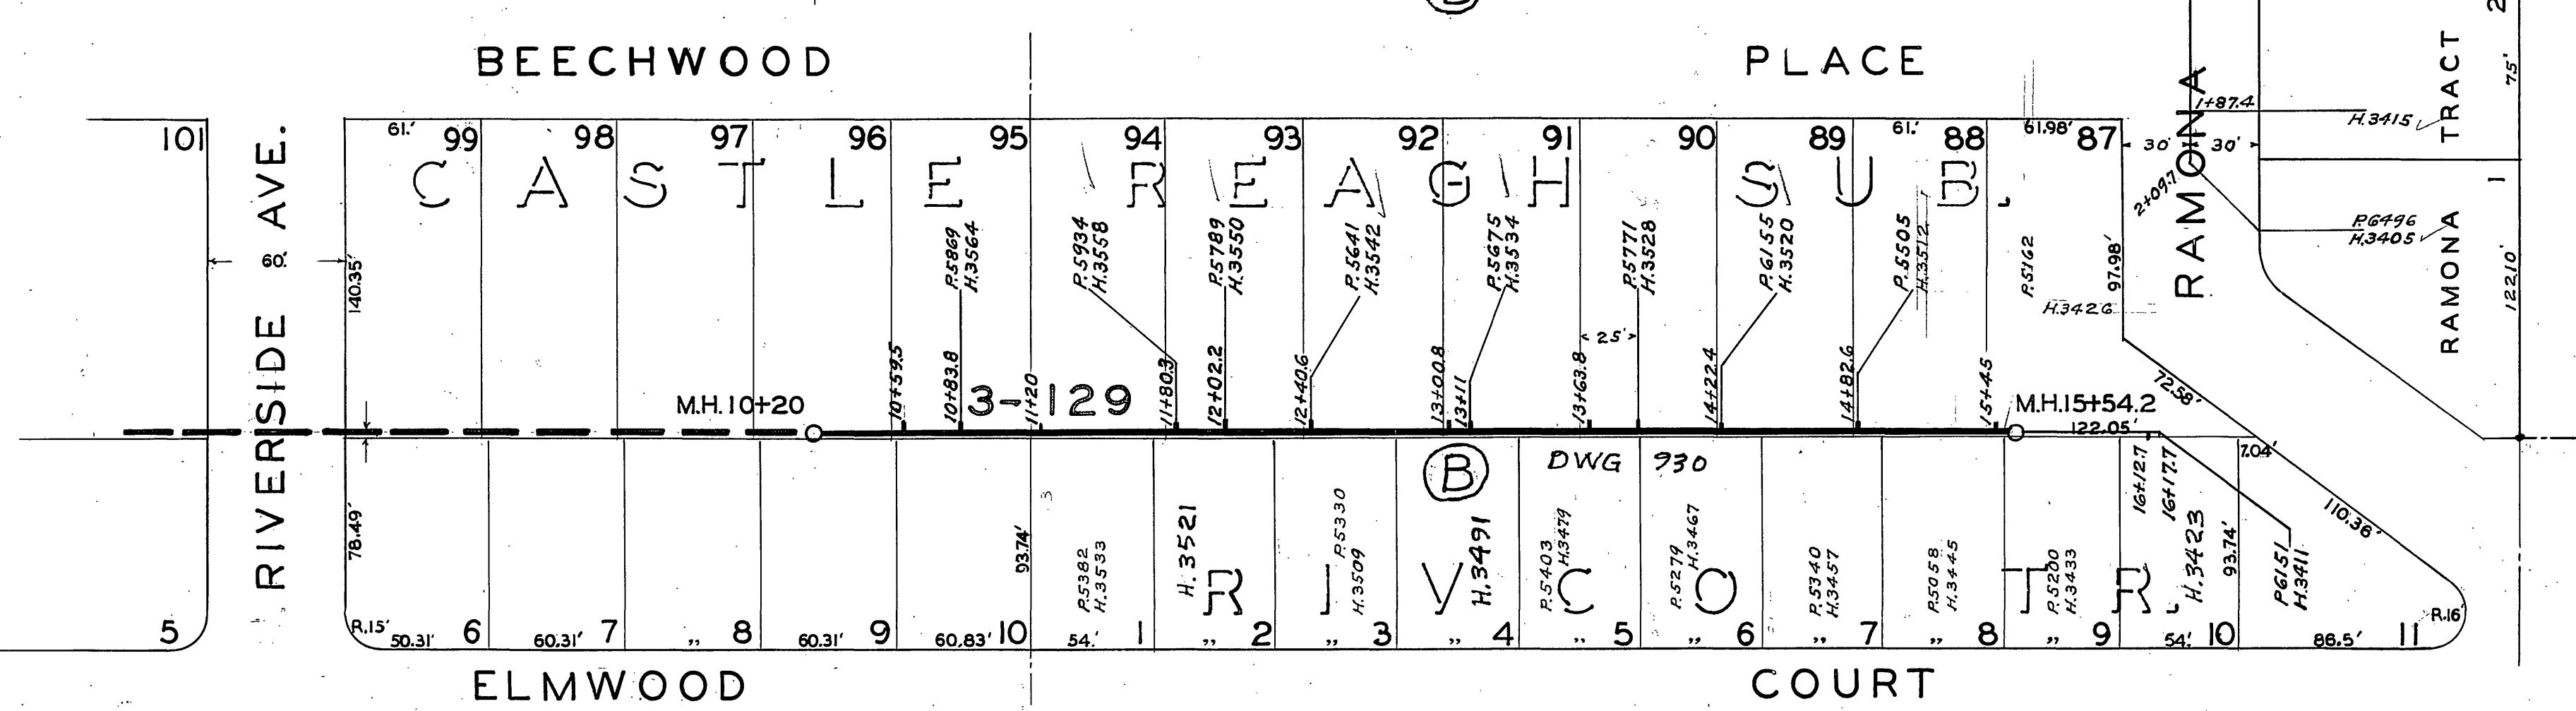
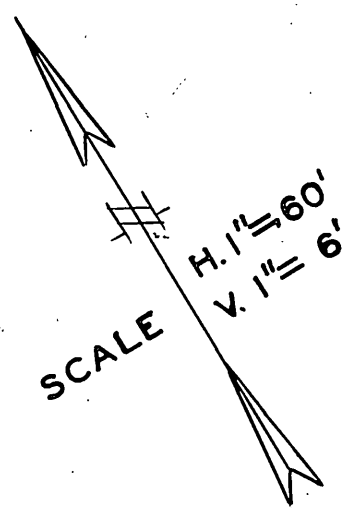


BOOK	THREE	PAGE	47

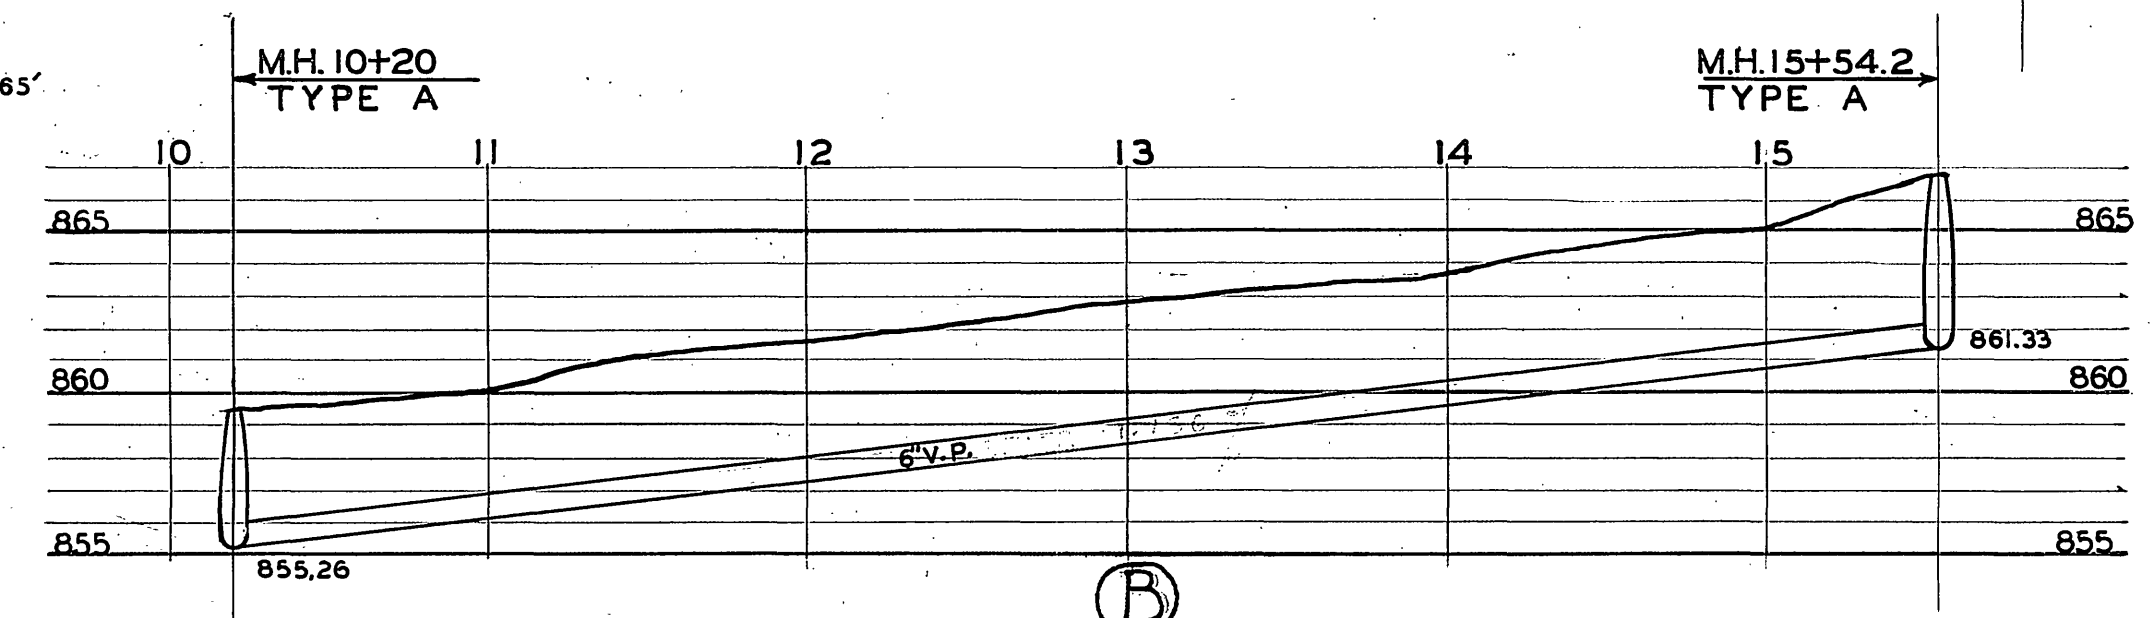

MAGNOLIA AVE.

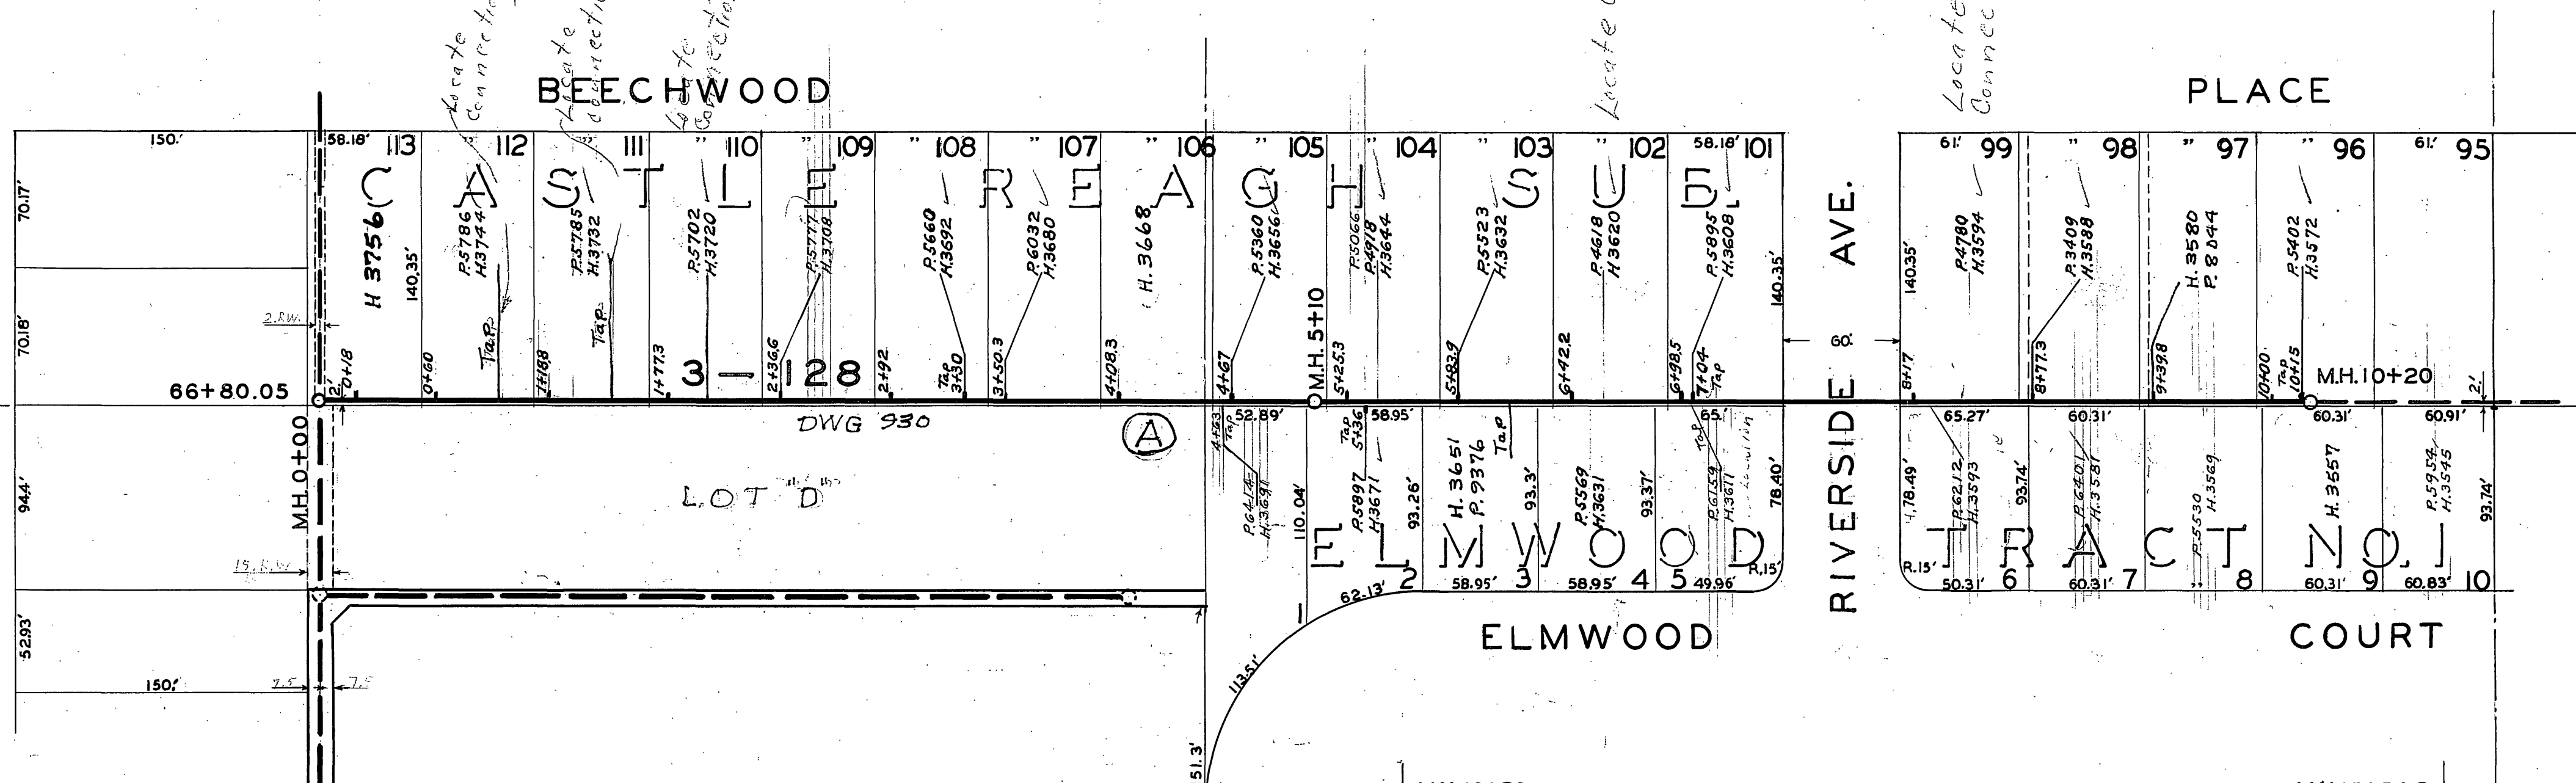

47