
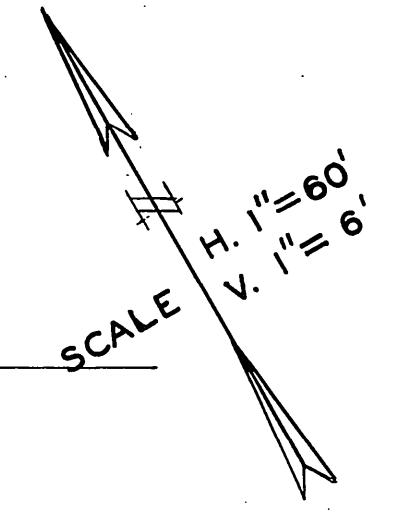
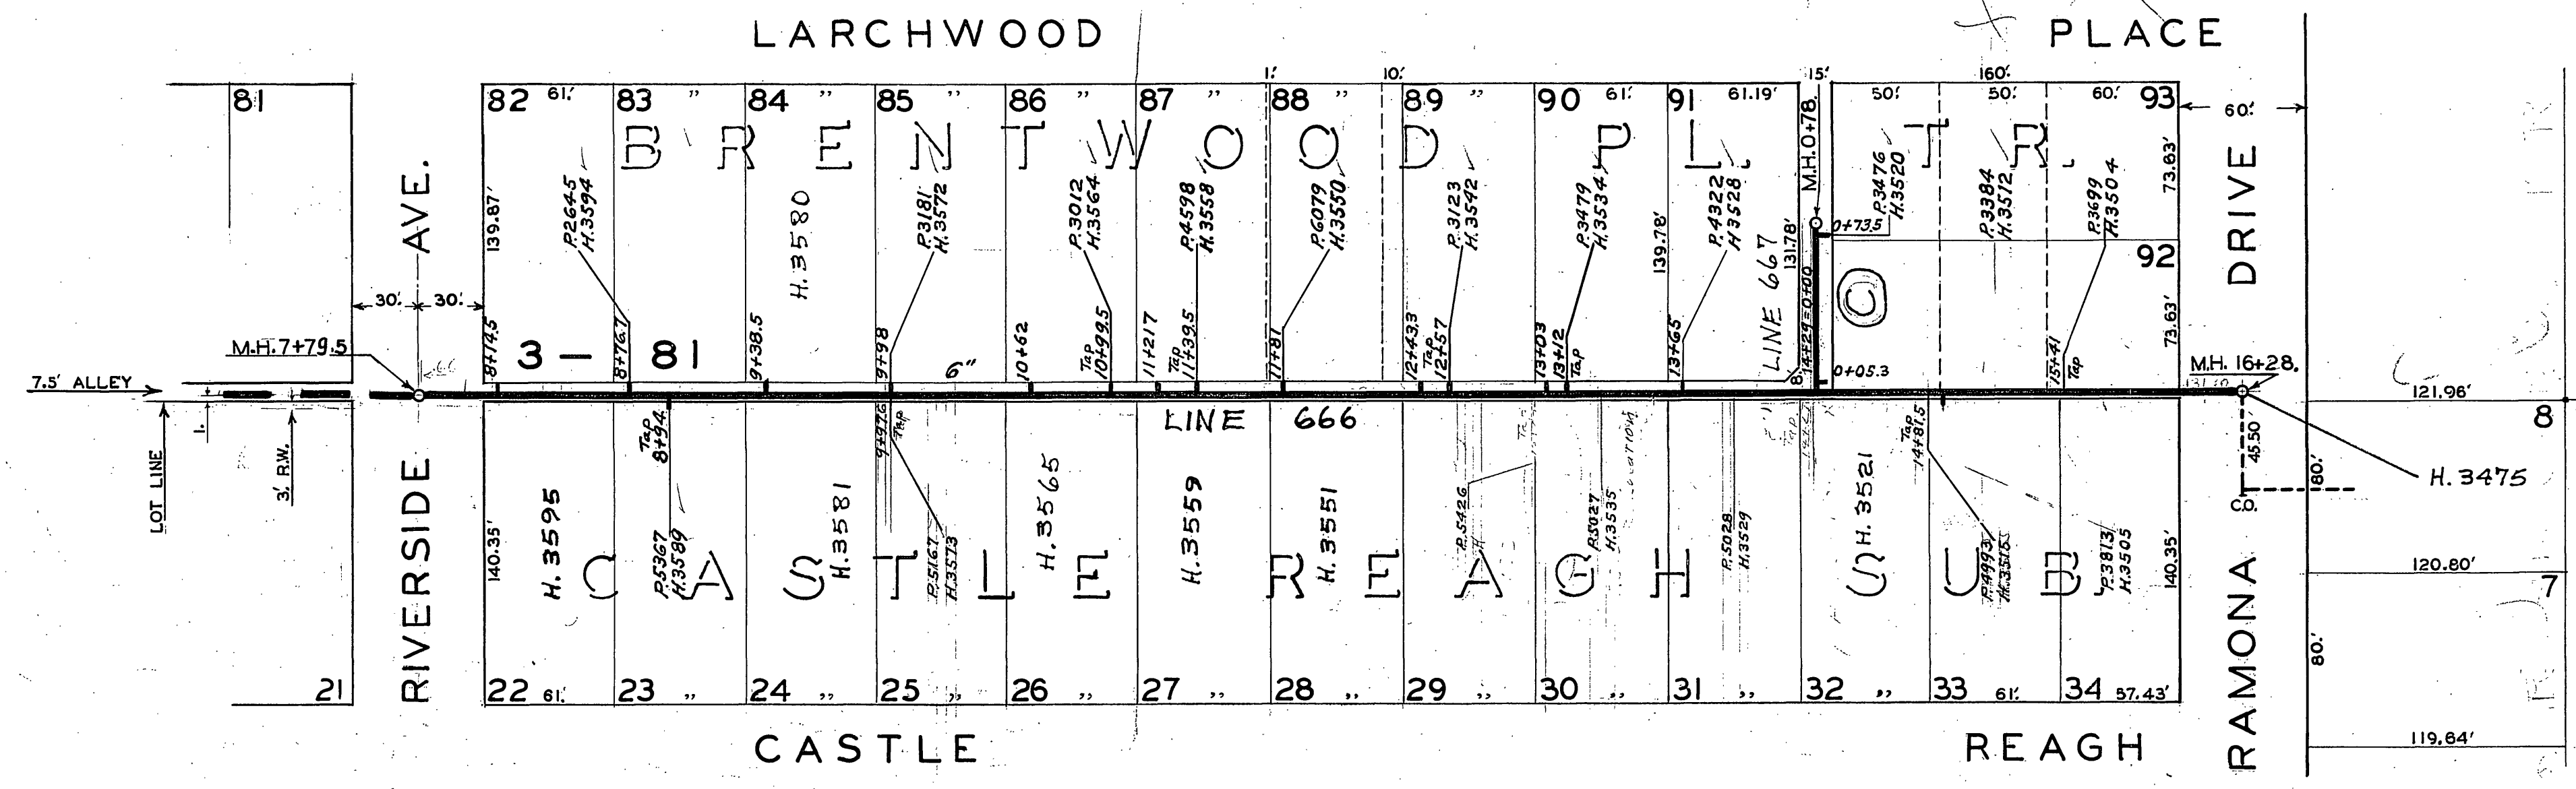
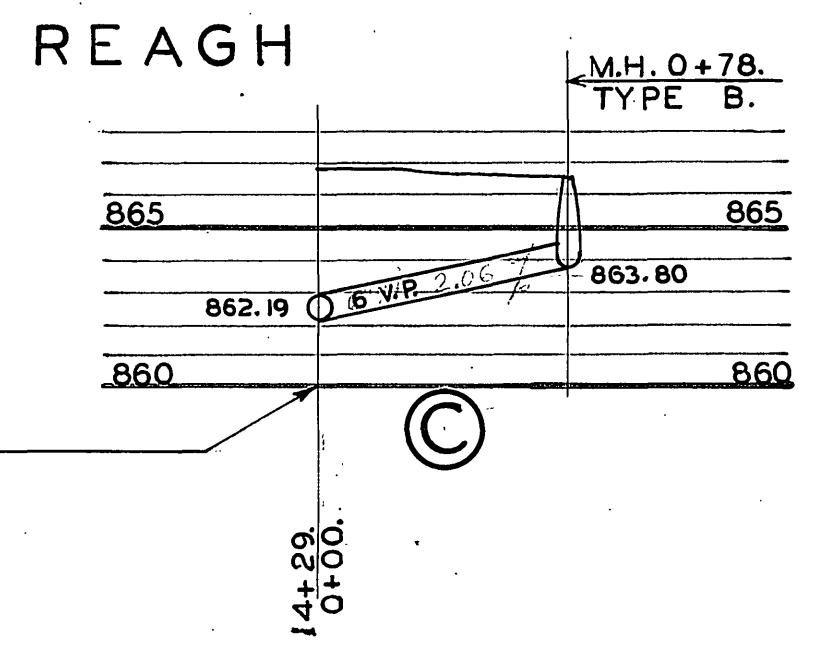
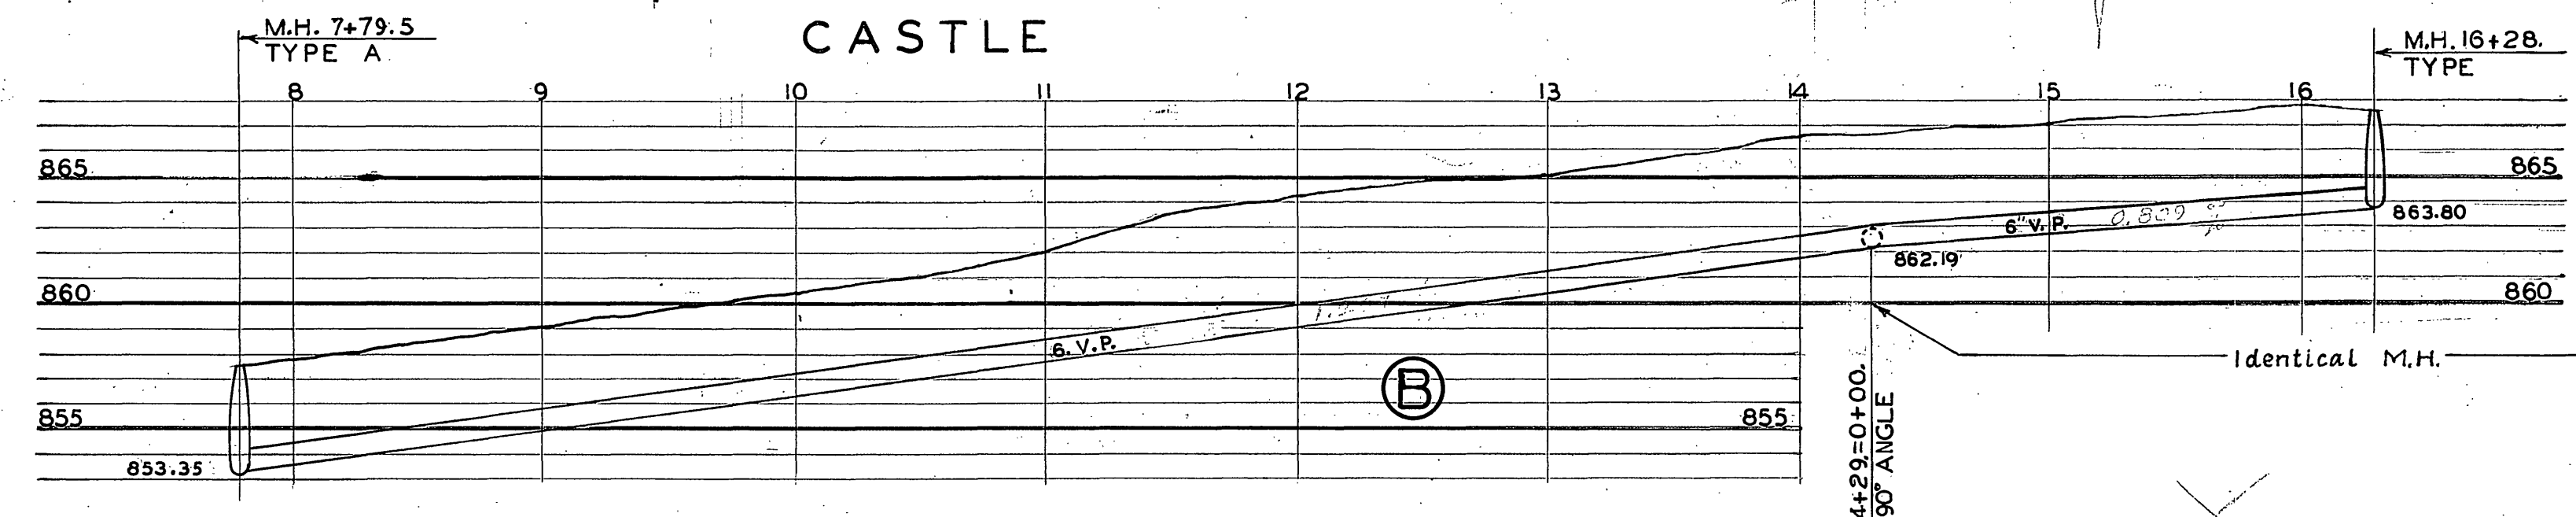
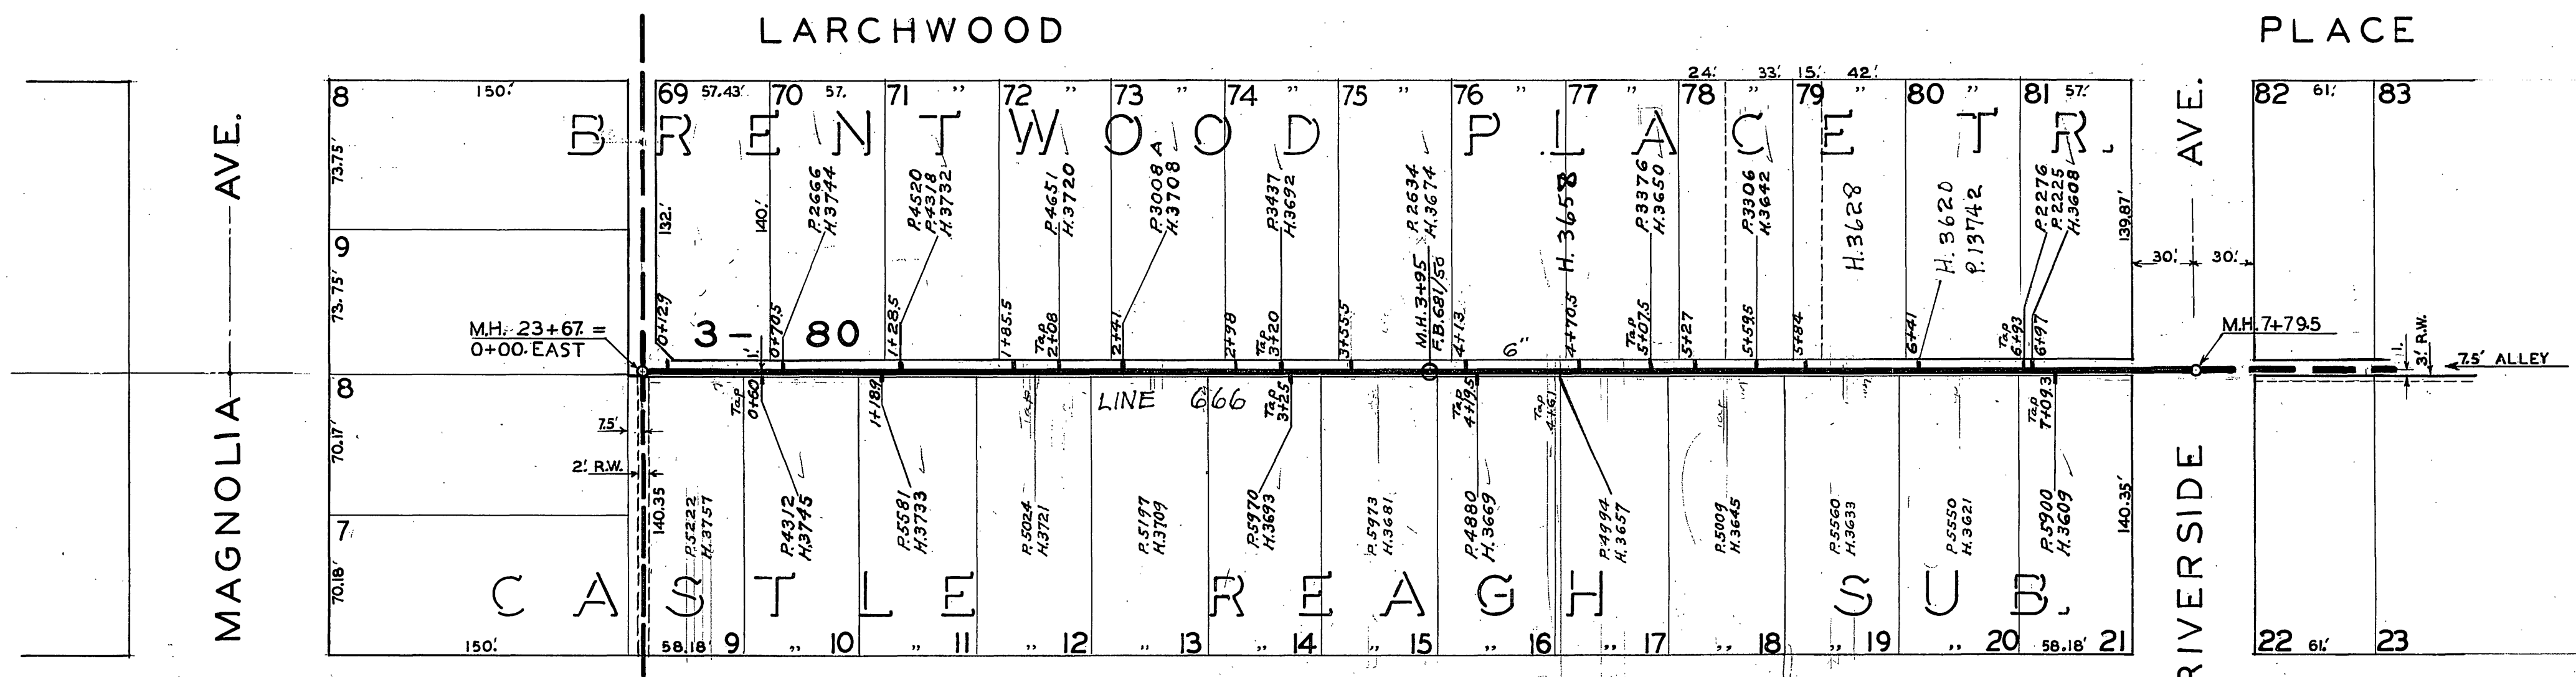


BOOK	THREE	PAGE	48

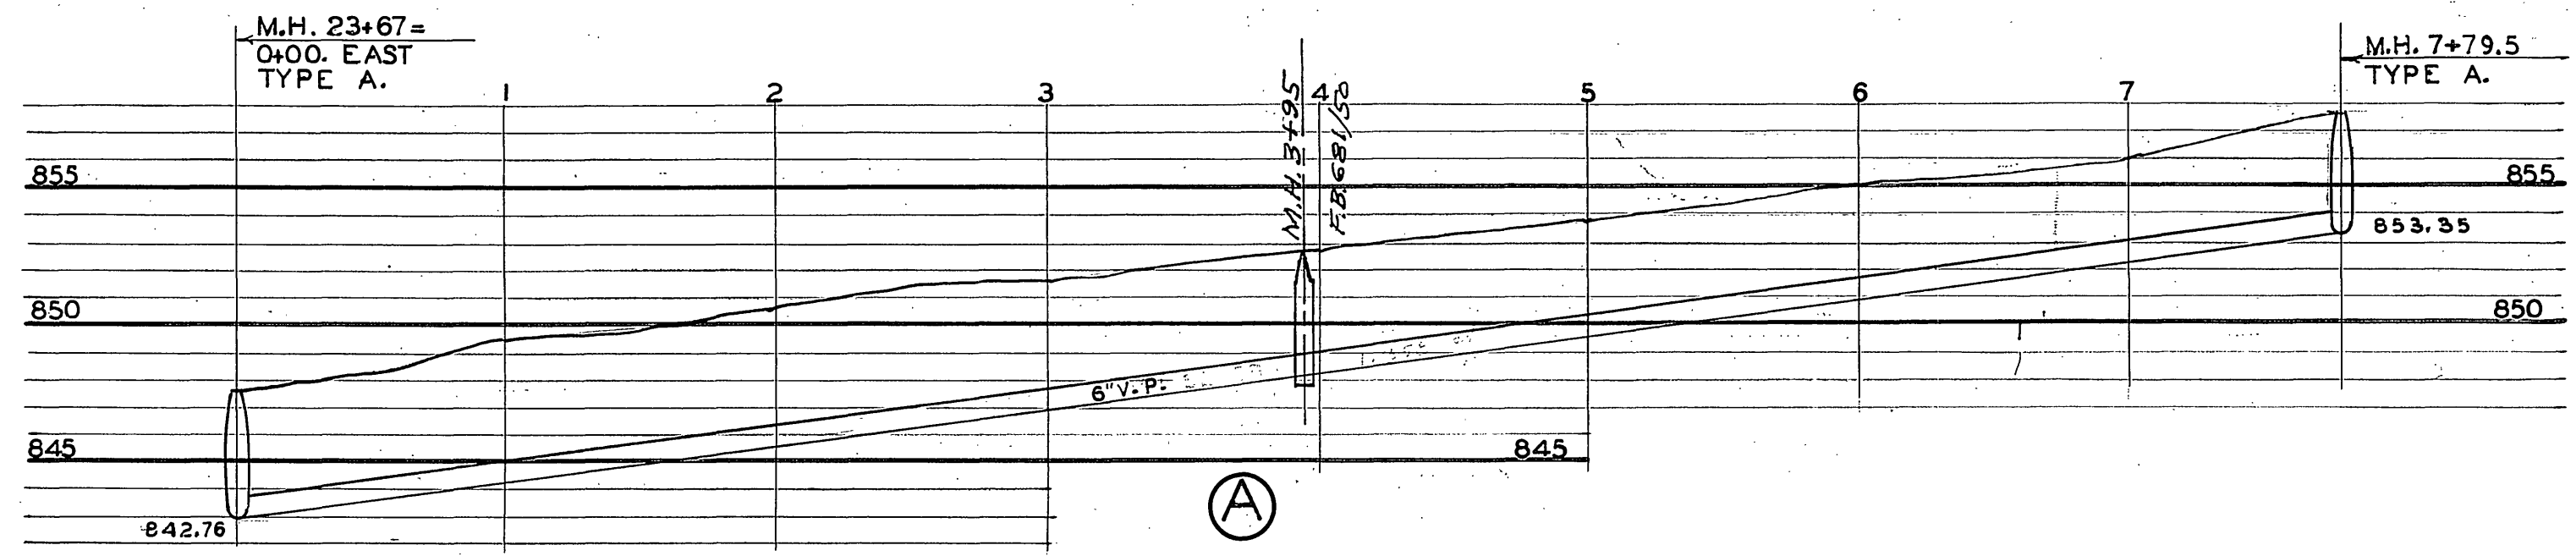

48