
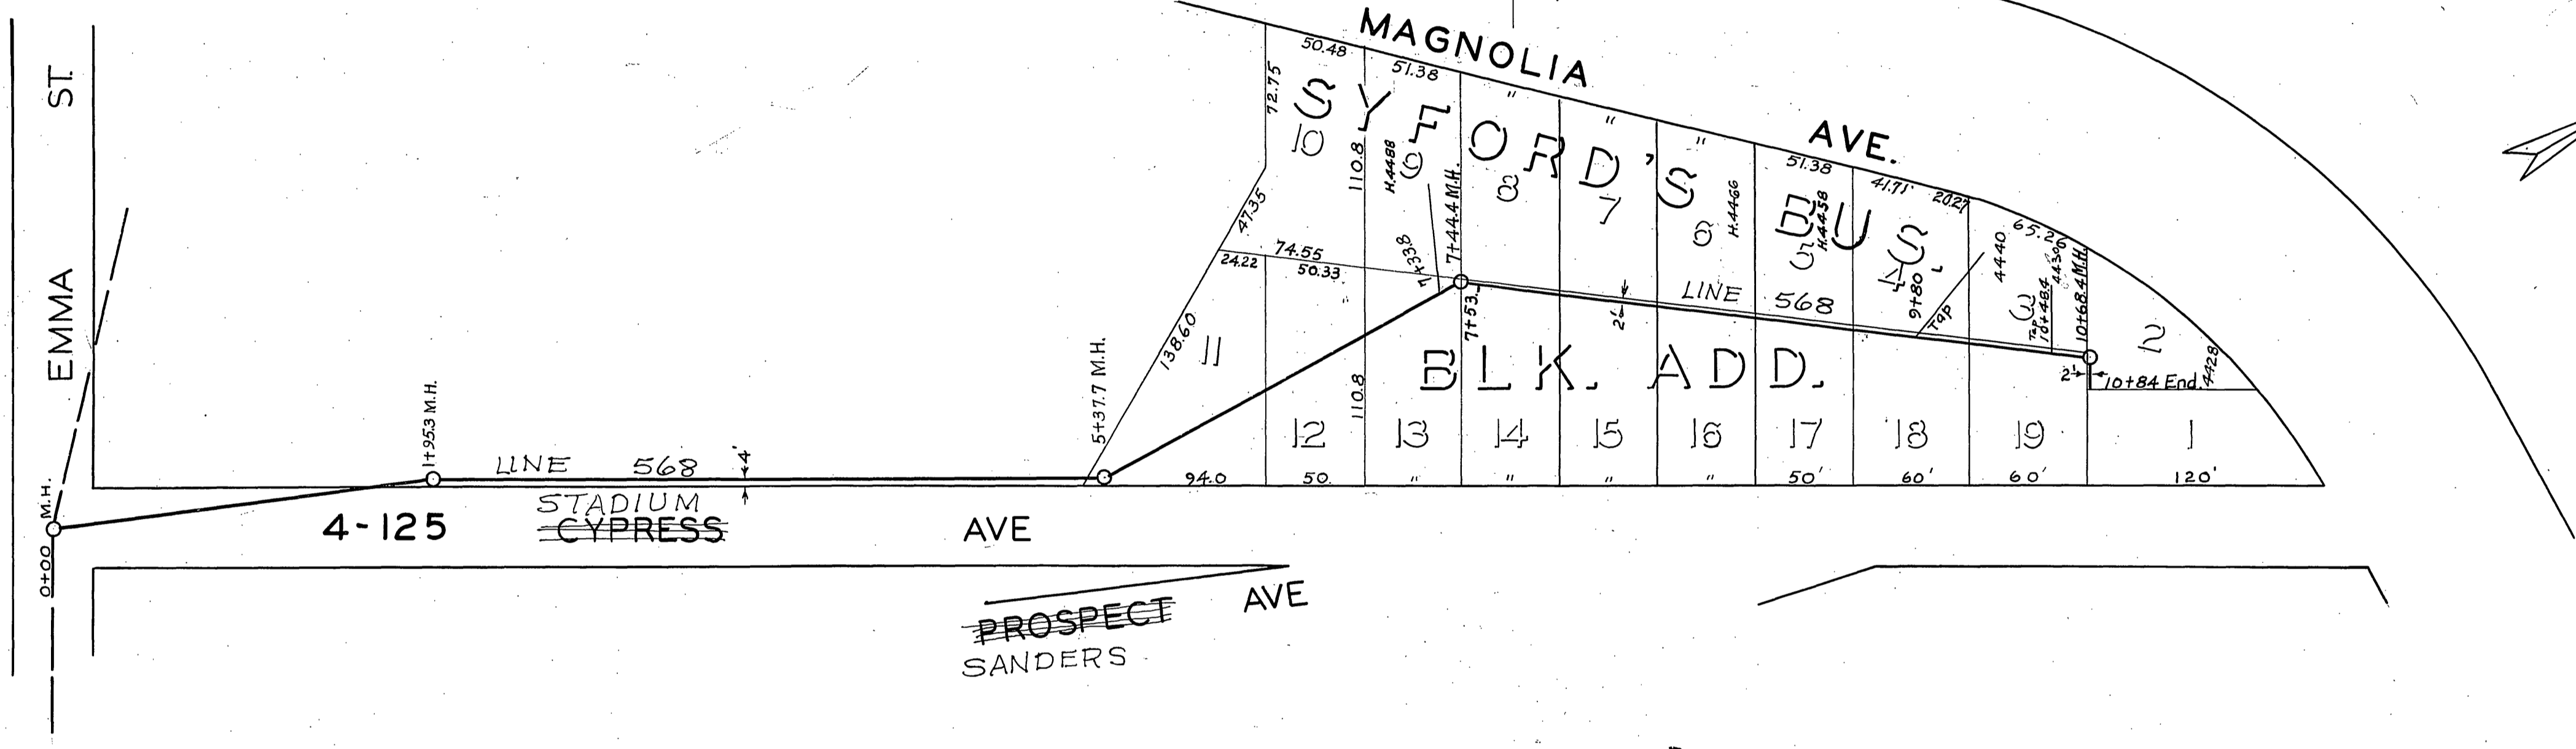
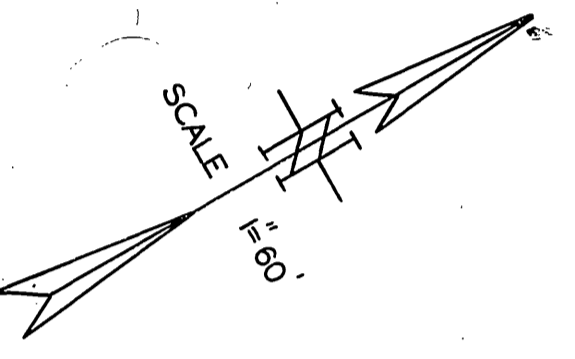


BOOK	THREE	PAGE	6

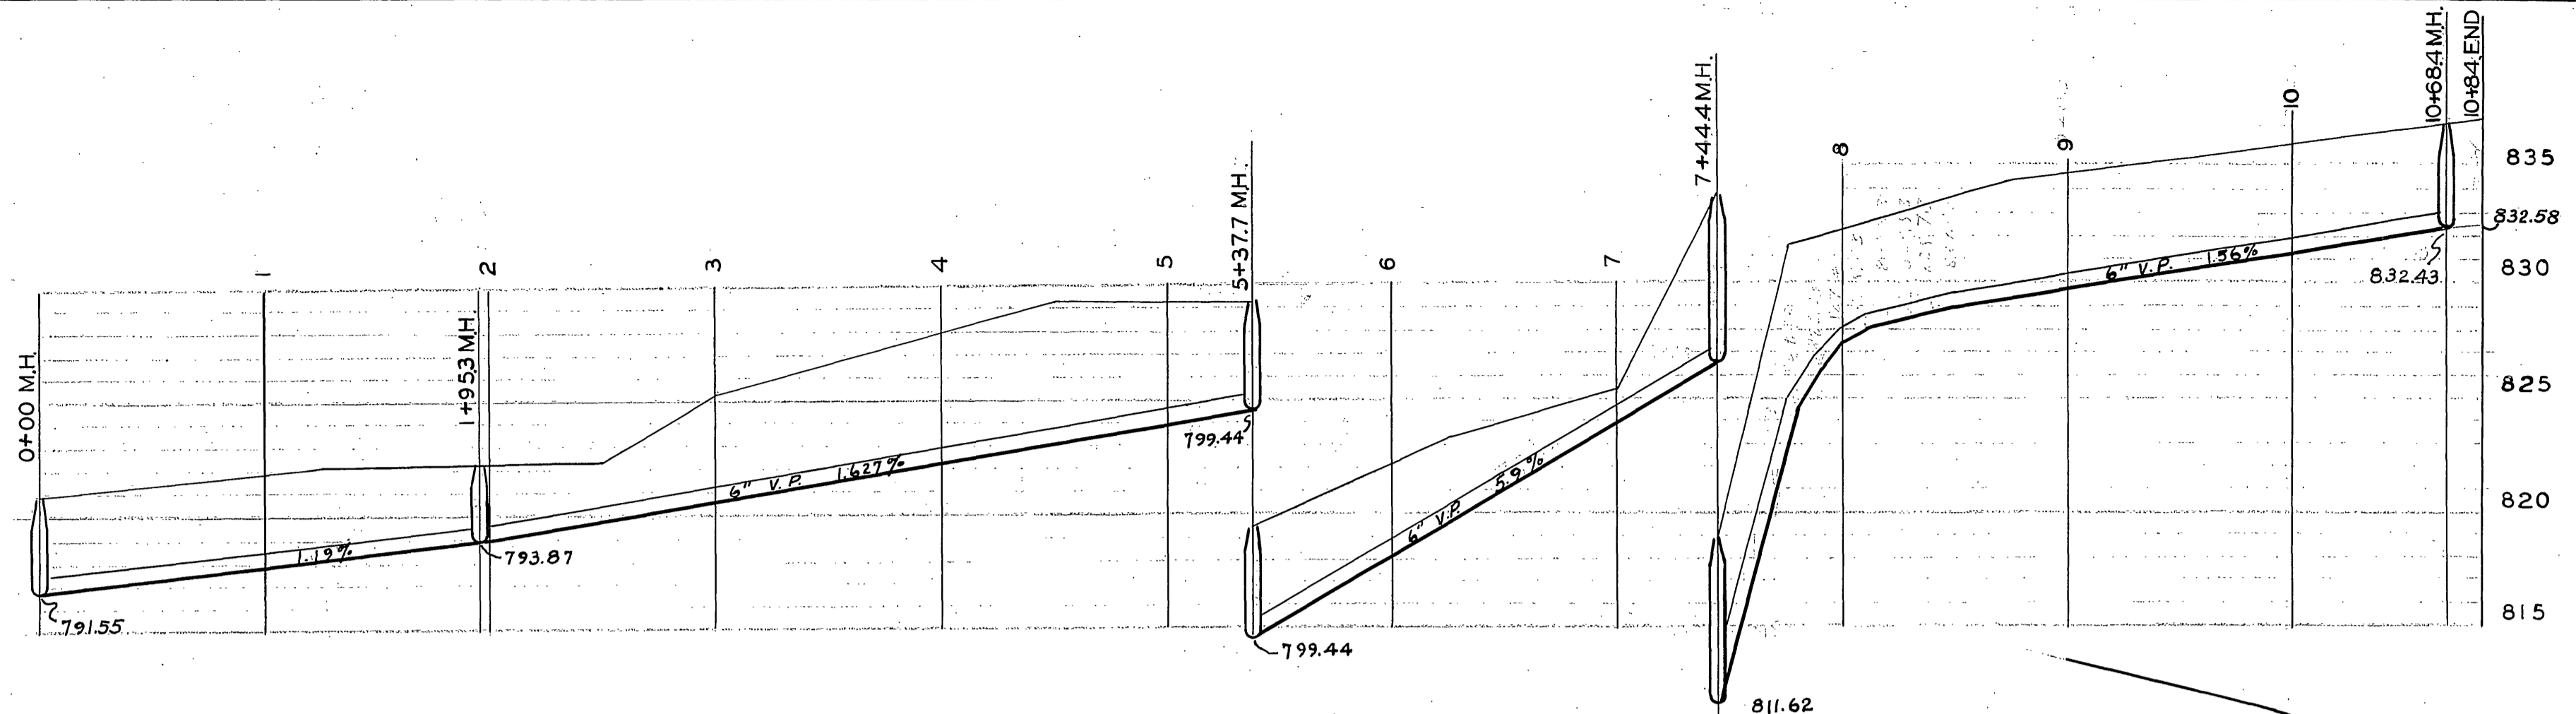

Oct 31/19 WH