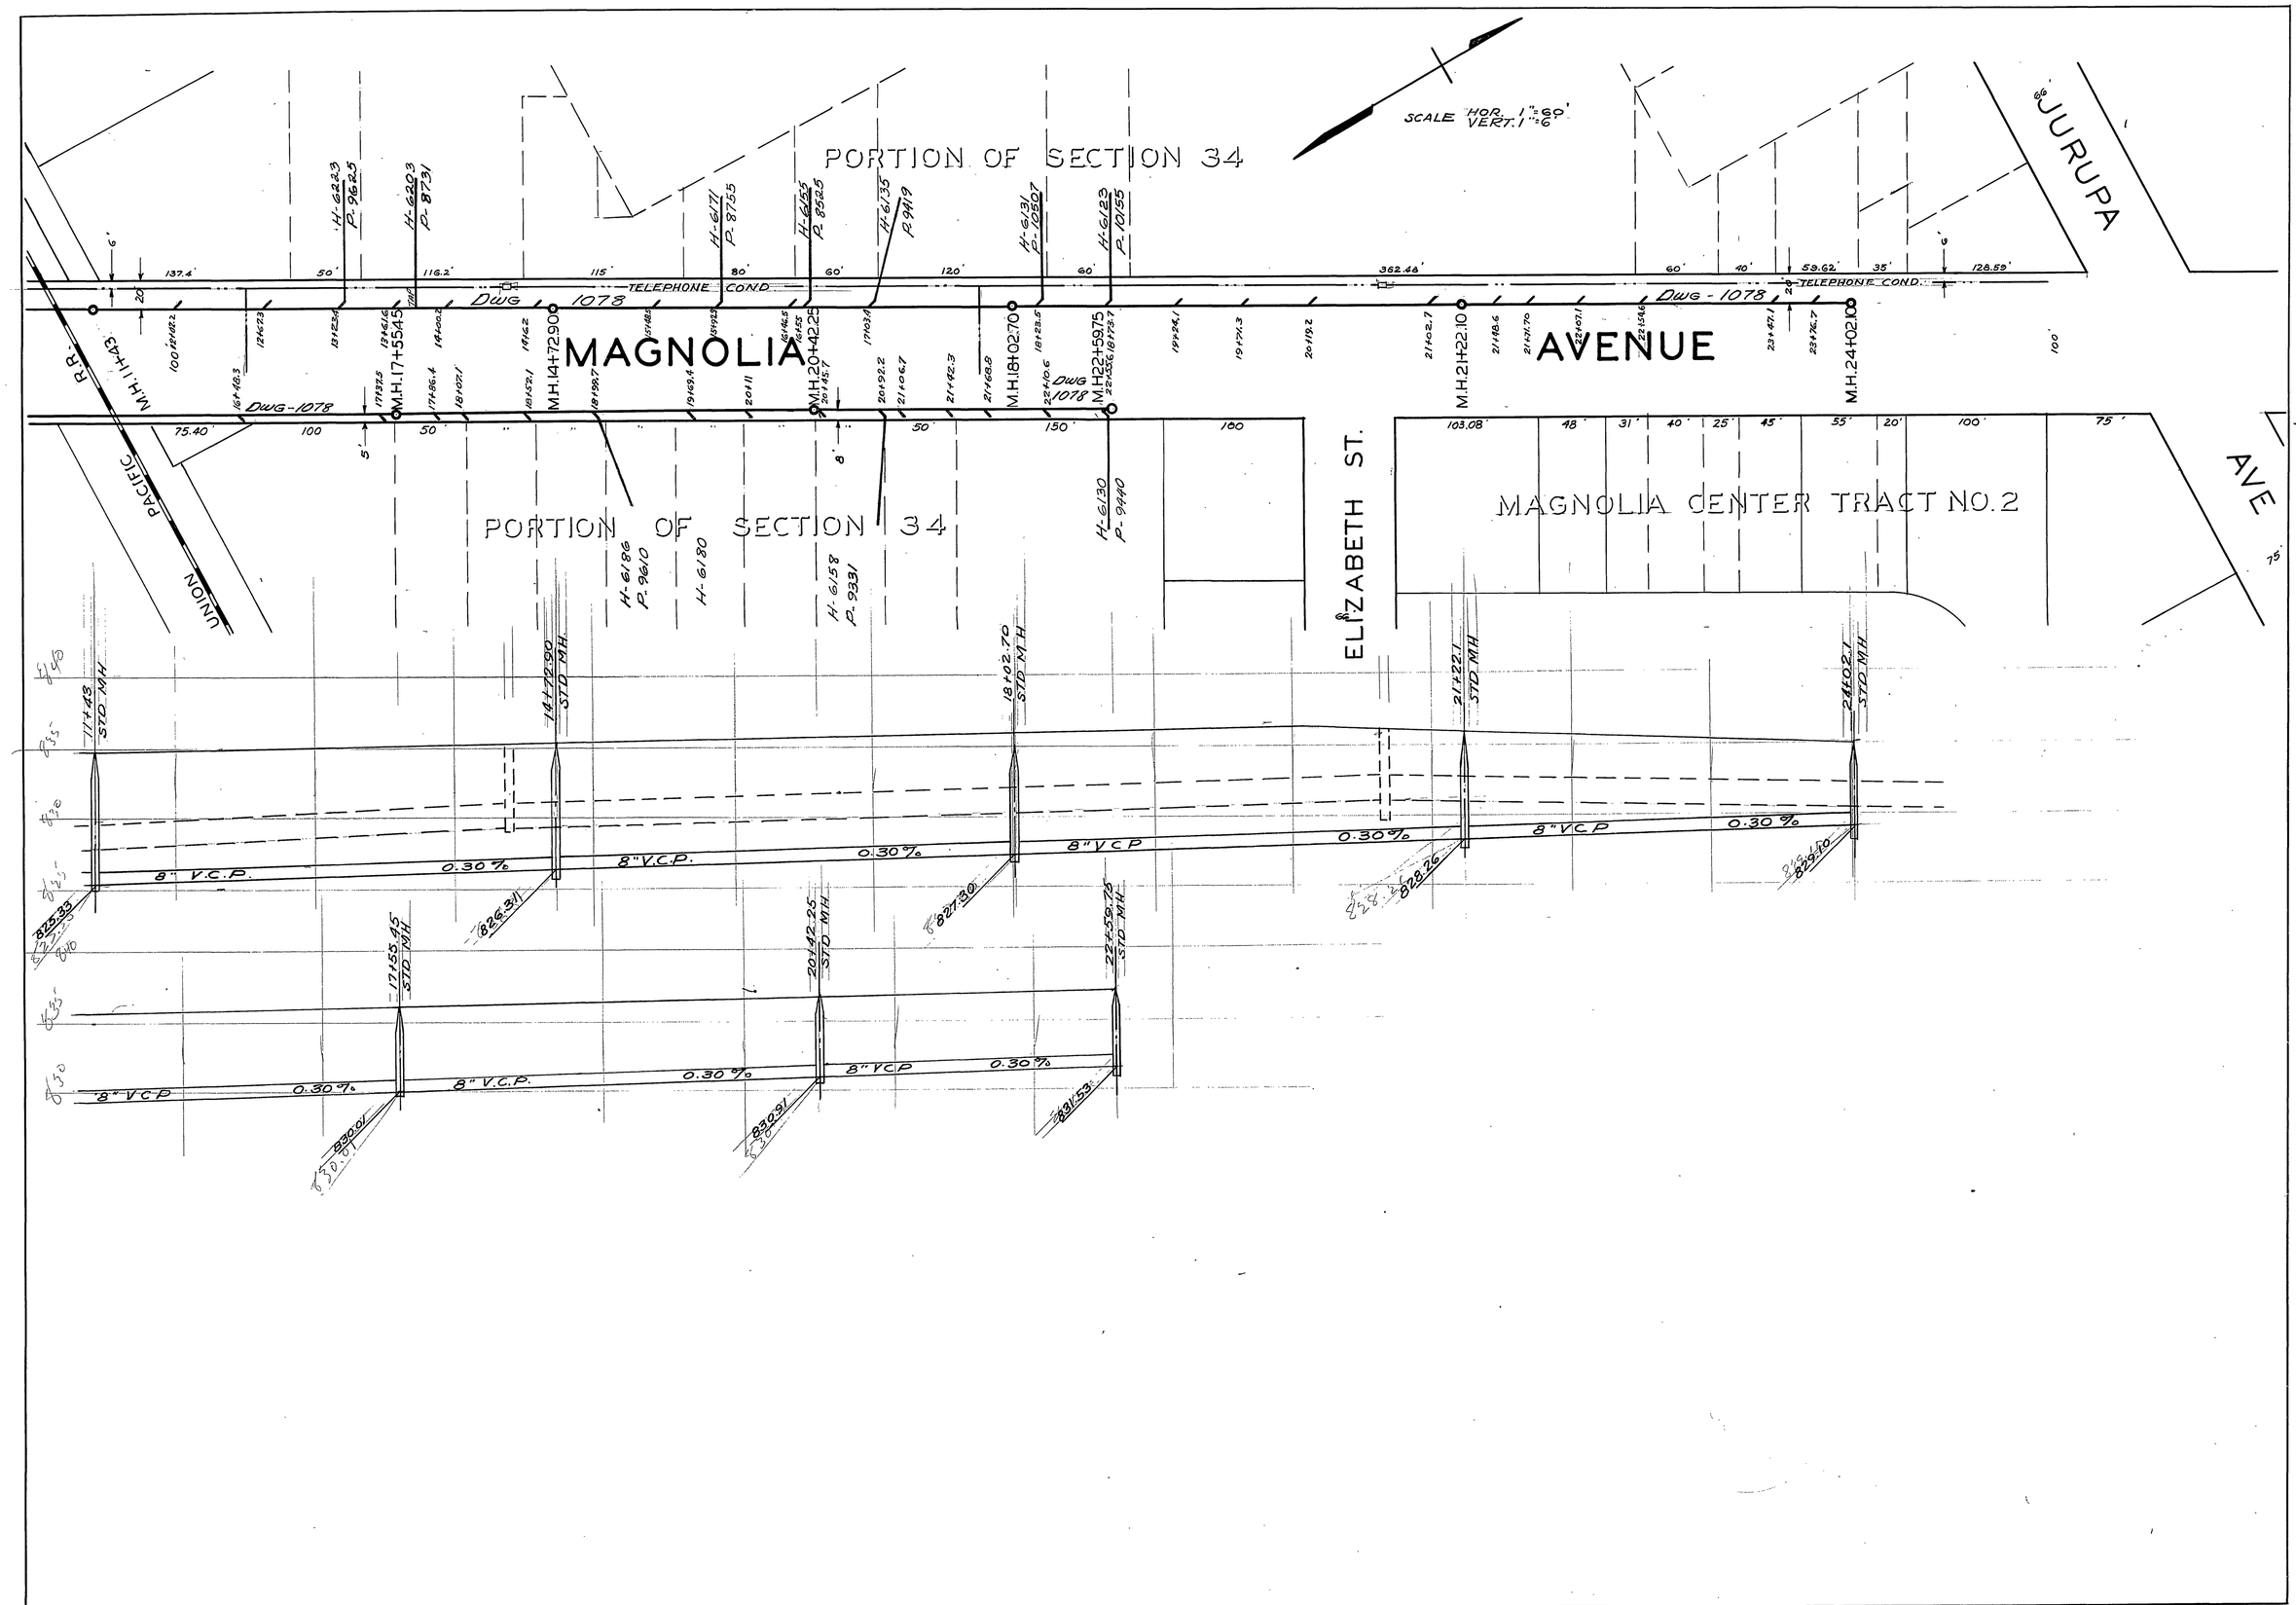

SCALE HOR. 1"=60' VERT. 1"=6'
PORTION OF SECTION 34
MAGNOLIA AVENUE
JURUPA AVE
ELIZABETH ST.
MAGNOLIA CENTER TRACT NO. 2
UNION PACIFIC R.R.
TELEPHONE COND.
DWG 1078
M.H. 11+43
M.H. 17+55.45
M.H. 14+72.90
M.H. 20+42.25
M.H. 18+02.70
M.H. 22+59.75
M.H. 21+22.10
M.H. 24+02.10
H-6223 P-9625
H-6203 P-8731
H-6171 P-8755
H-6155 P-8525
H-6135 P-9419
H-6131 P-10507
H-6123 P-10155
H-6186 P-9610
H-6180
H-6158 P-9331
H-6130 P-9440
11+43 STD MH
14+72.90 STD MH
18+02.70 STD MH
21+22.1 STD MH
24+02.1 STD MH
17+55.45 STD MH
20+42.25 STD MH
22+59.75 STD MH
8" V.C.P.
0.30%
825.33
826.31
827.30
828.26
829.10
830.01
830.91
831.53