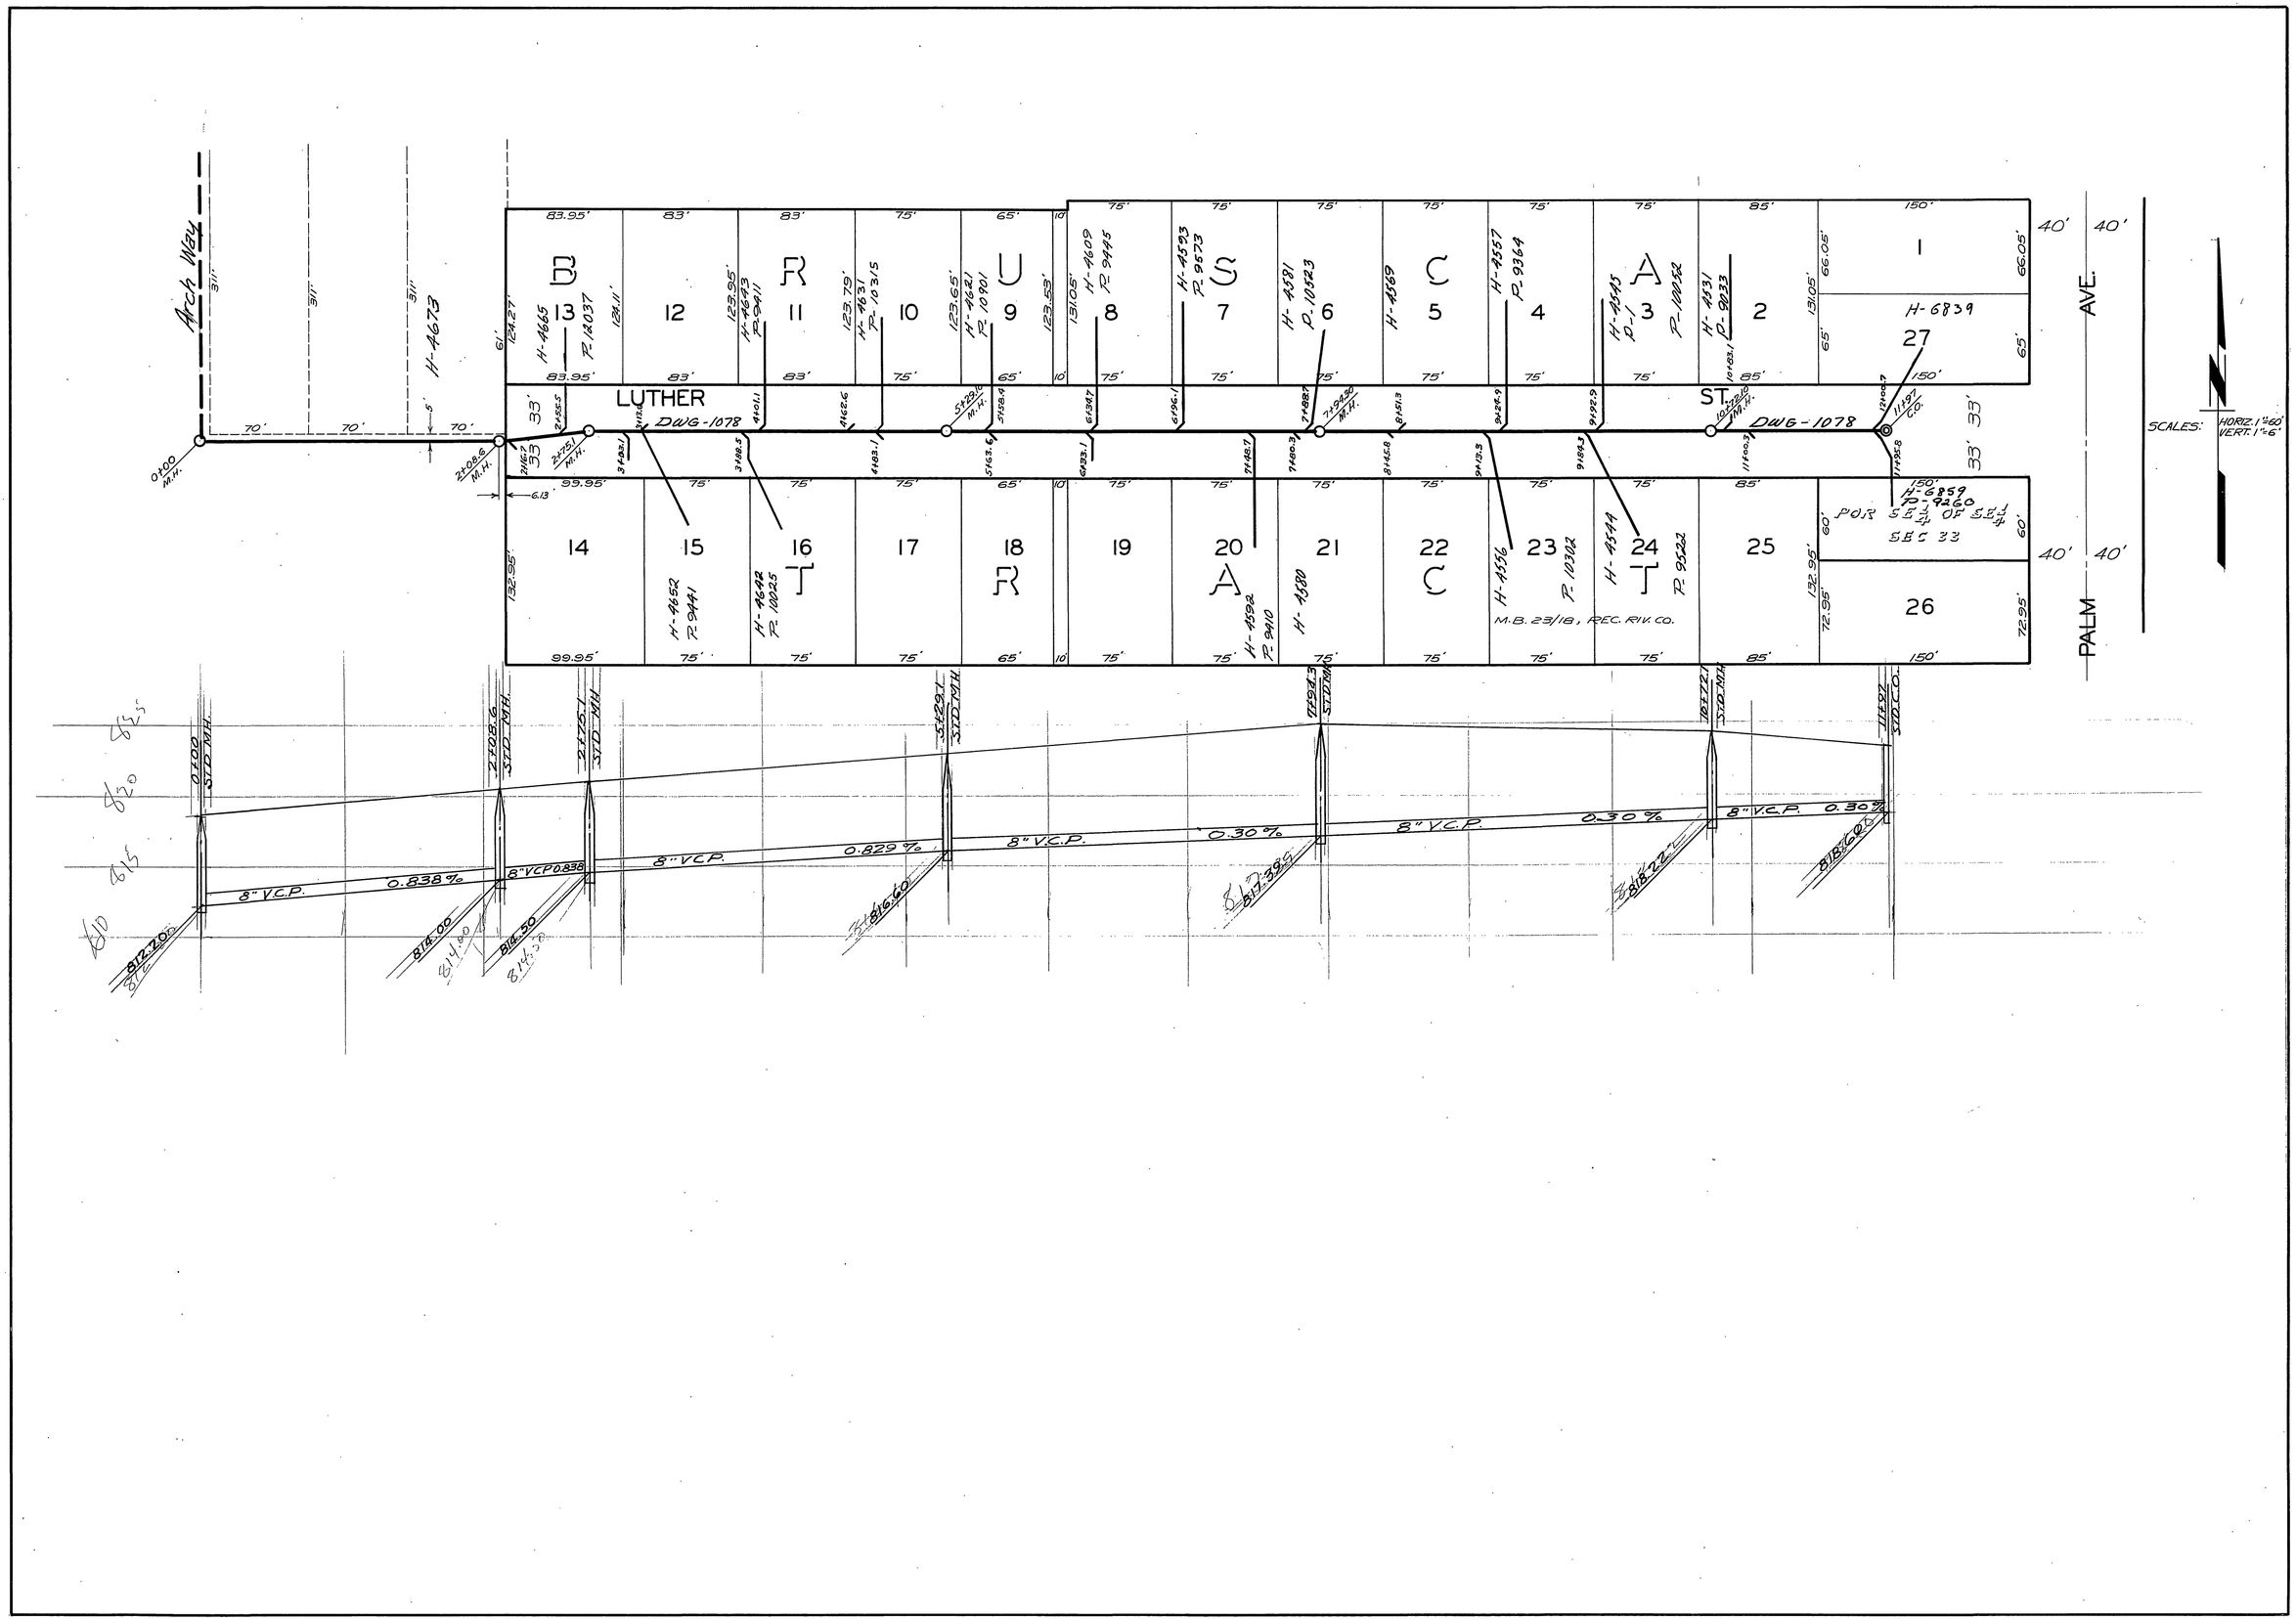

Arch Way
LUTHER
ST.
DWG-1078
PALM
AVE.
SCALES: HORIZ. 1"=60' VERT. 1"=6'
M.B. 23/18, REC. RIV. CO.
POR SE¼ OF SE¼ SEC 33
8" V.C.P.
0.838%
0.829%
0.30%