



SCALE HOR 1"=60'
VERT 1"=6'

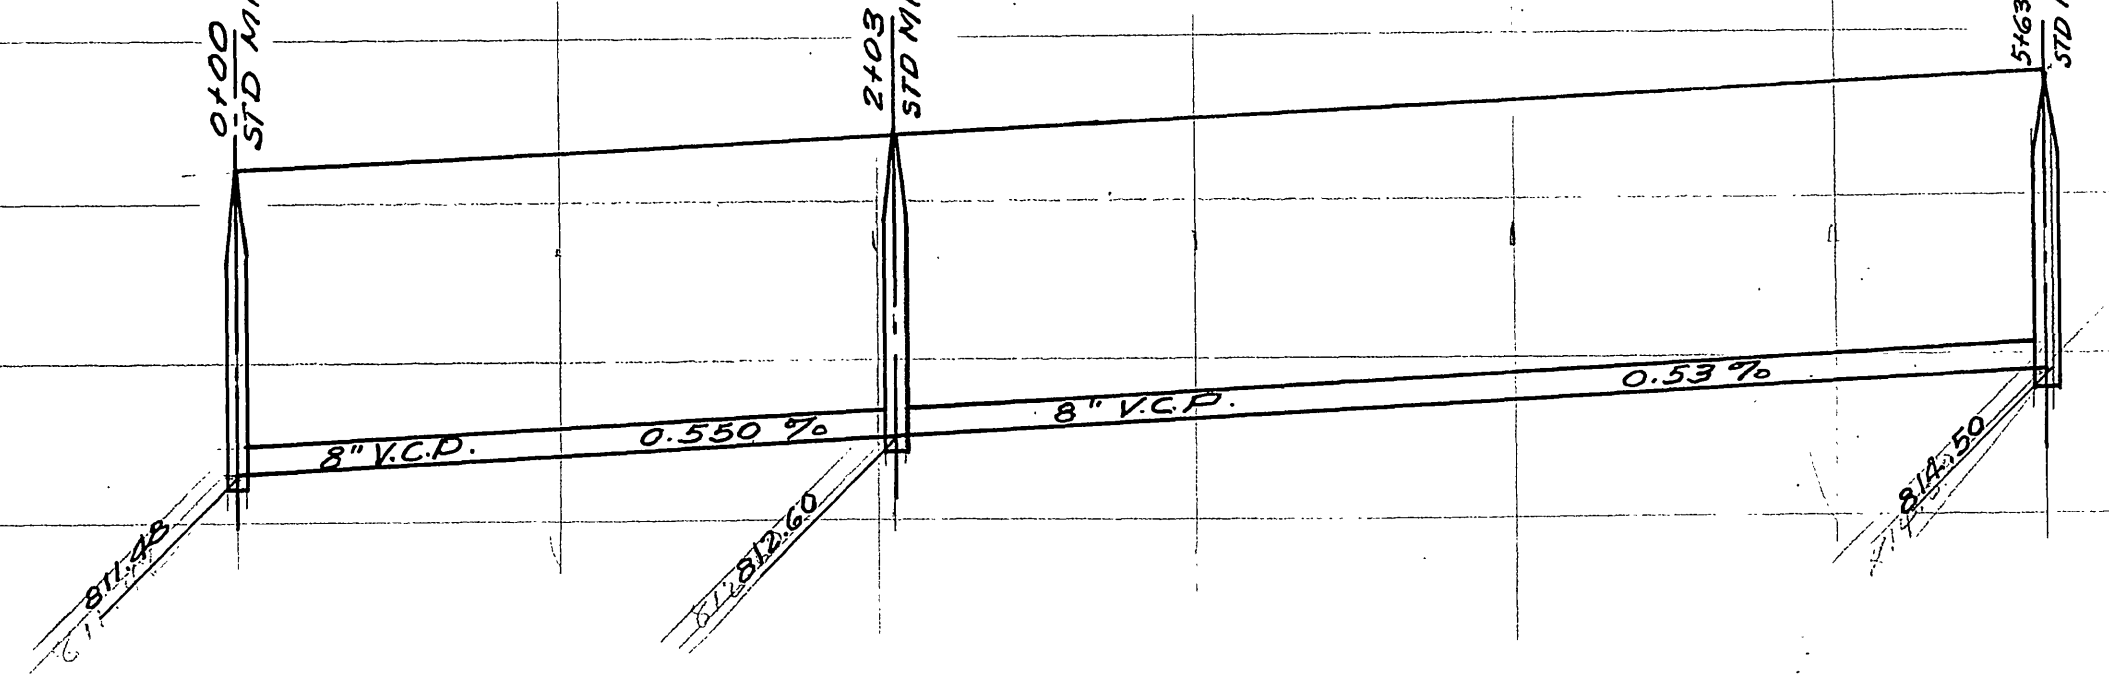

SCALE HOR 1"=60'
VERT 1"=6'

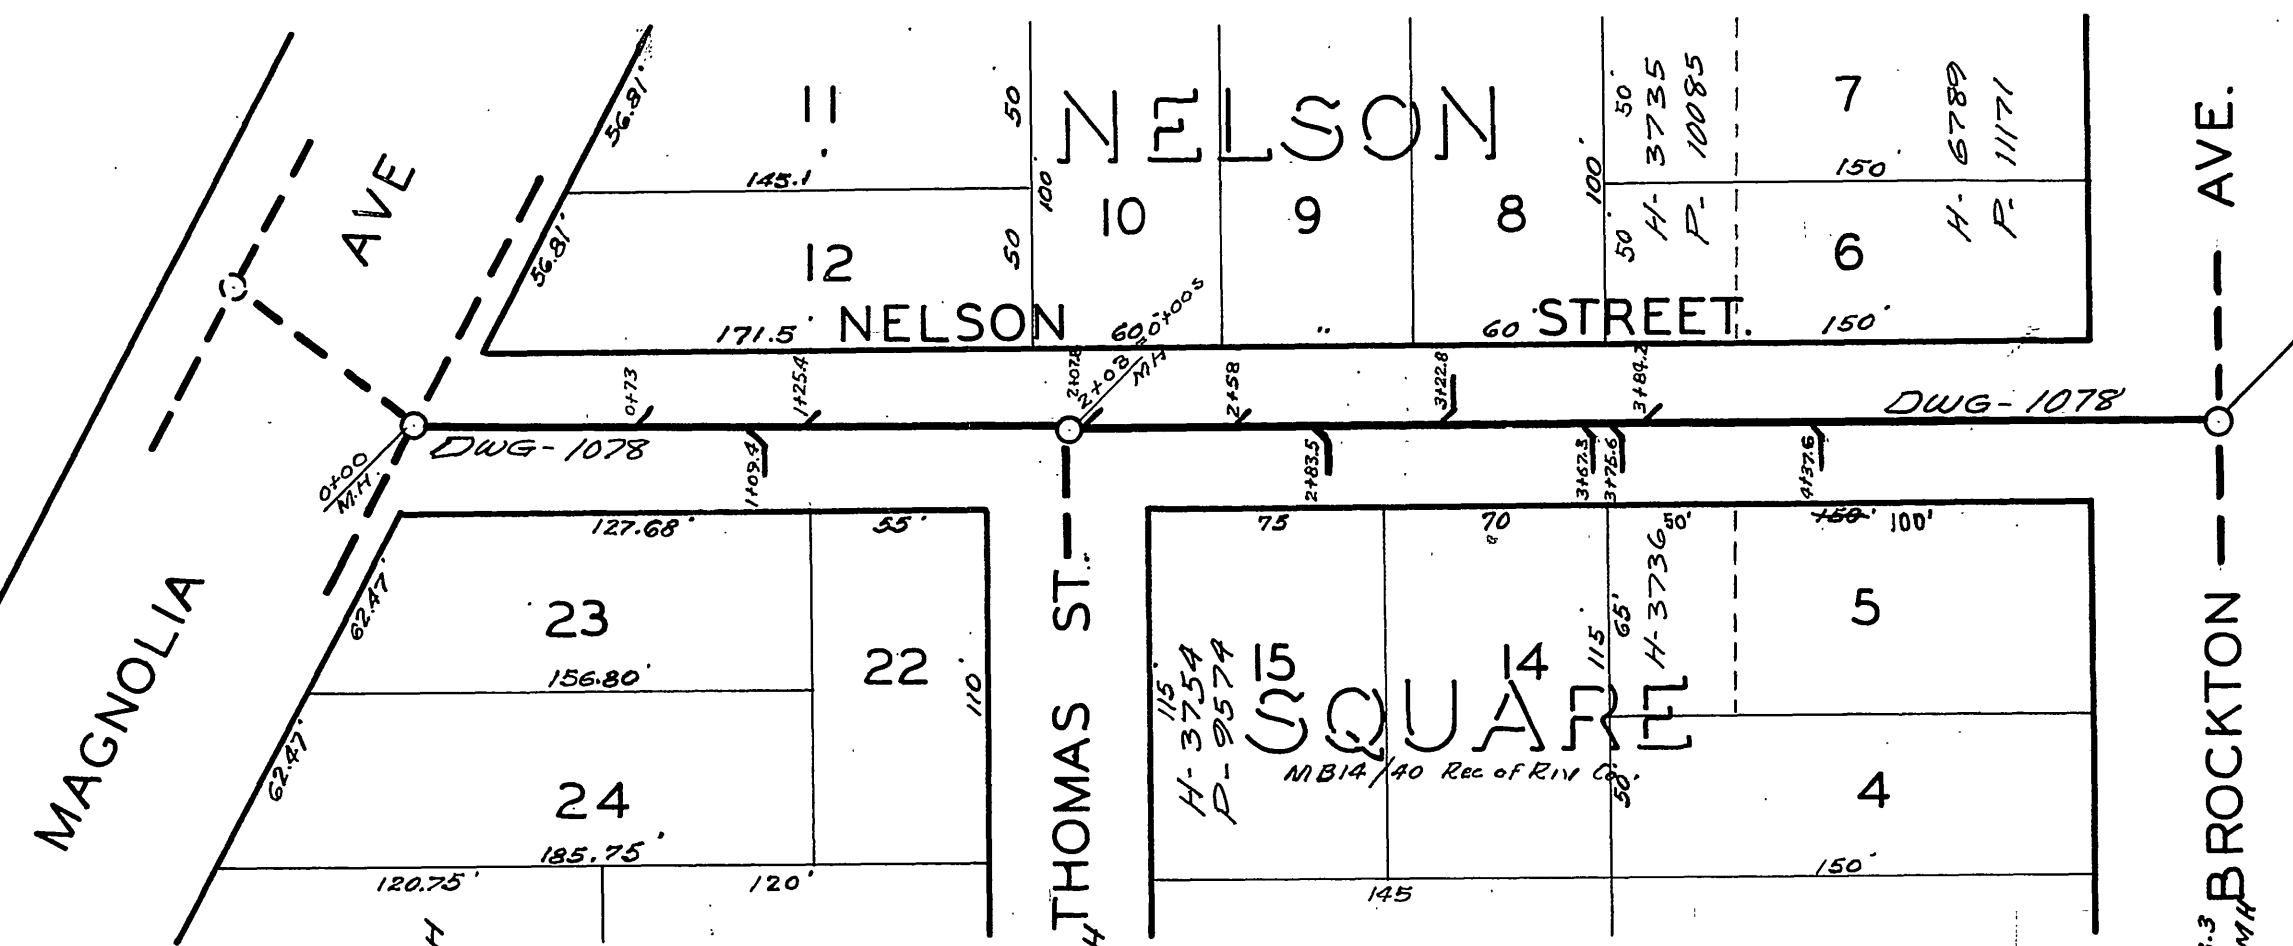