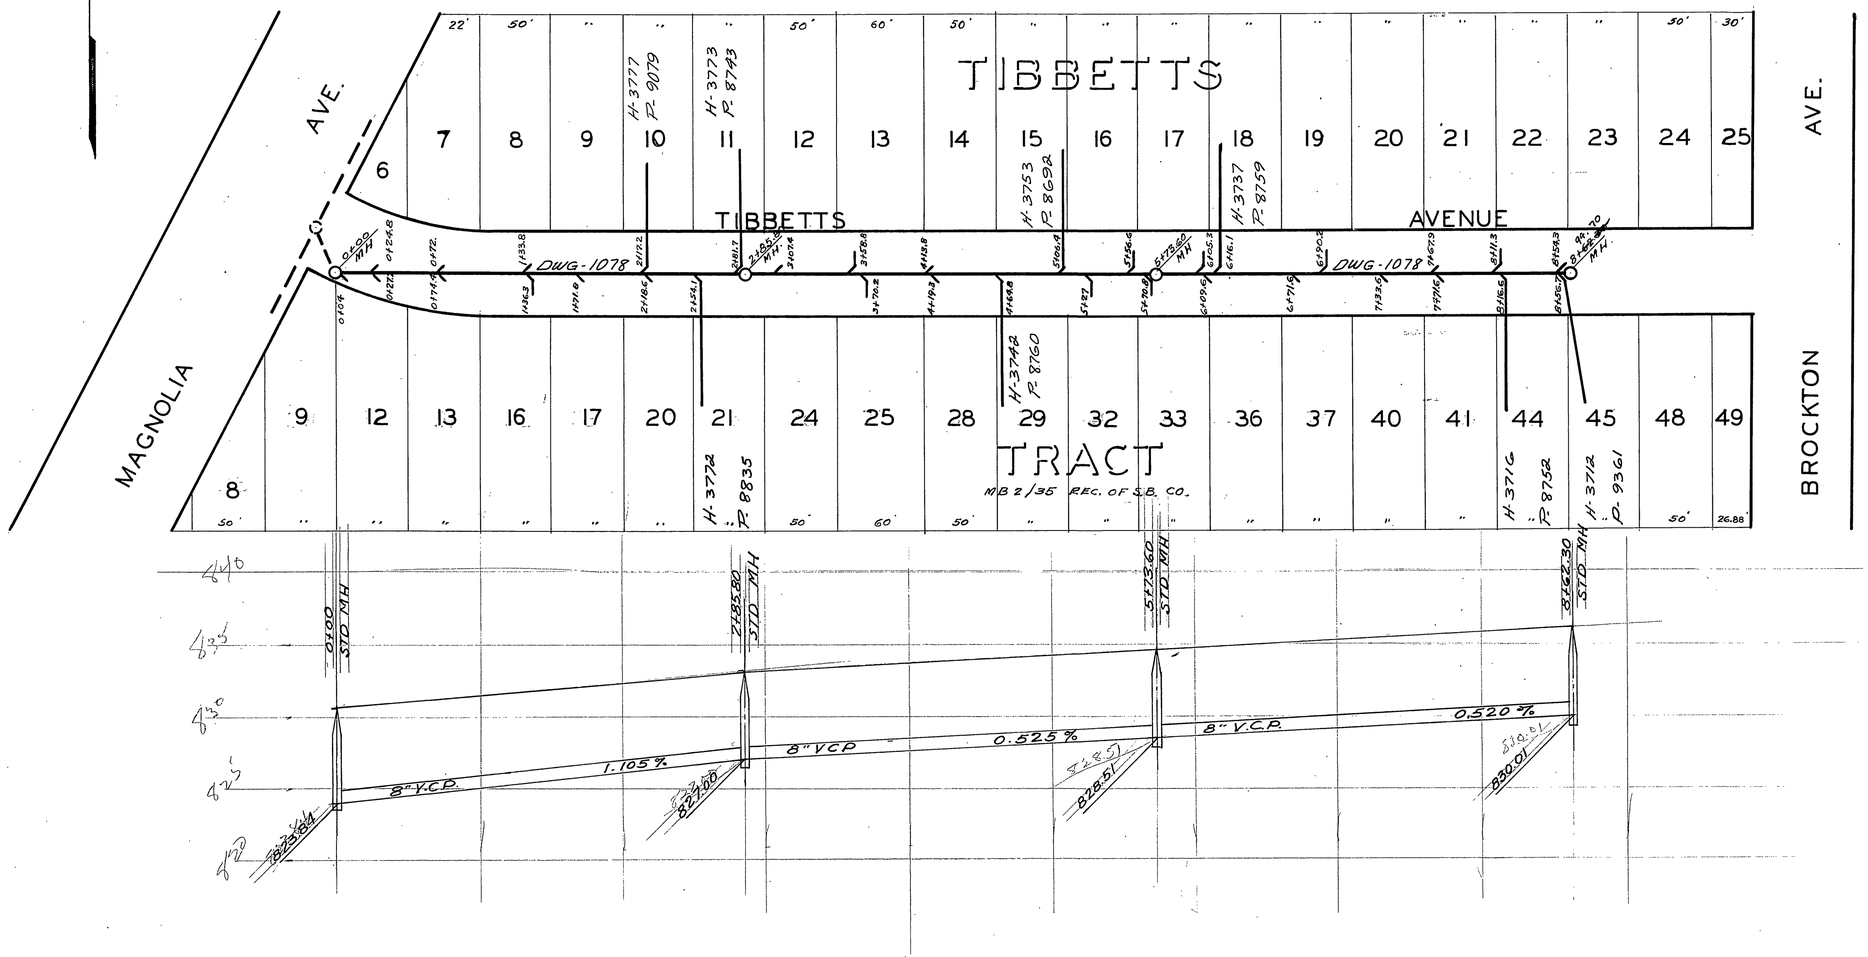SCALE HOR. 1"=60'
VERT. 1"=6'