


SCALE  
HOR 1" = 60'  
VERT 1" = 6'

ROSSMUIR ST.

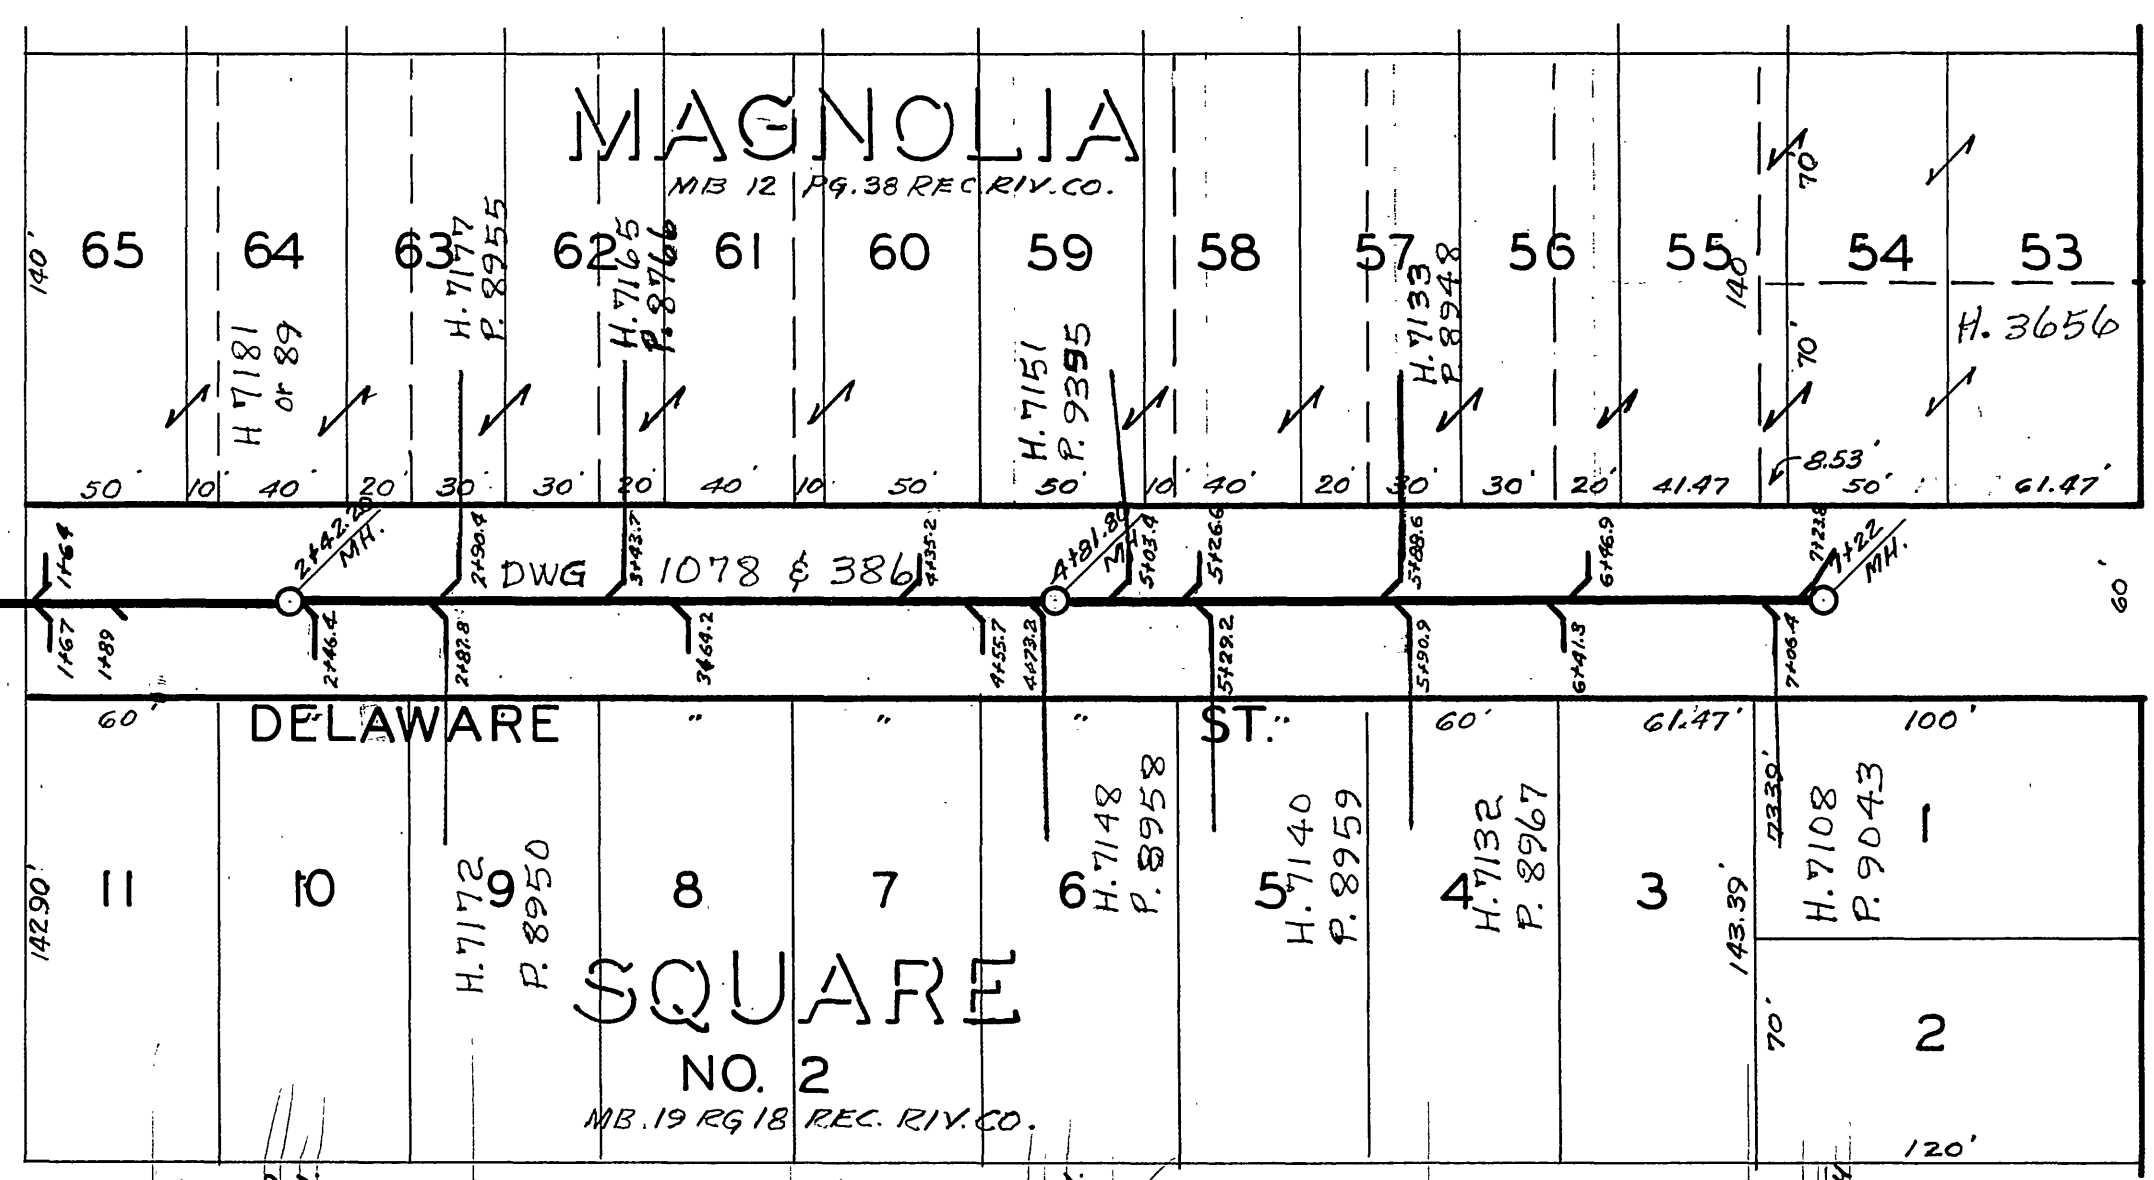

80'  
ST.  
WASHINGTON

