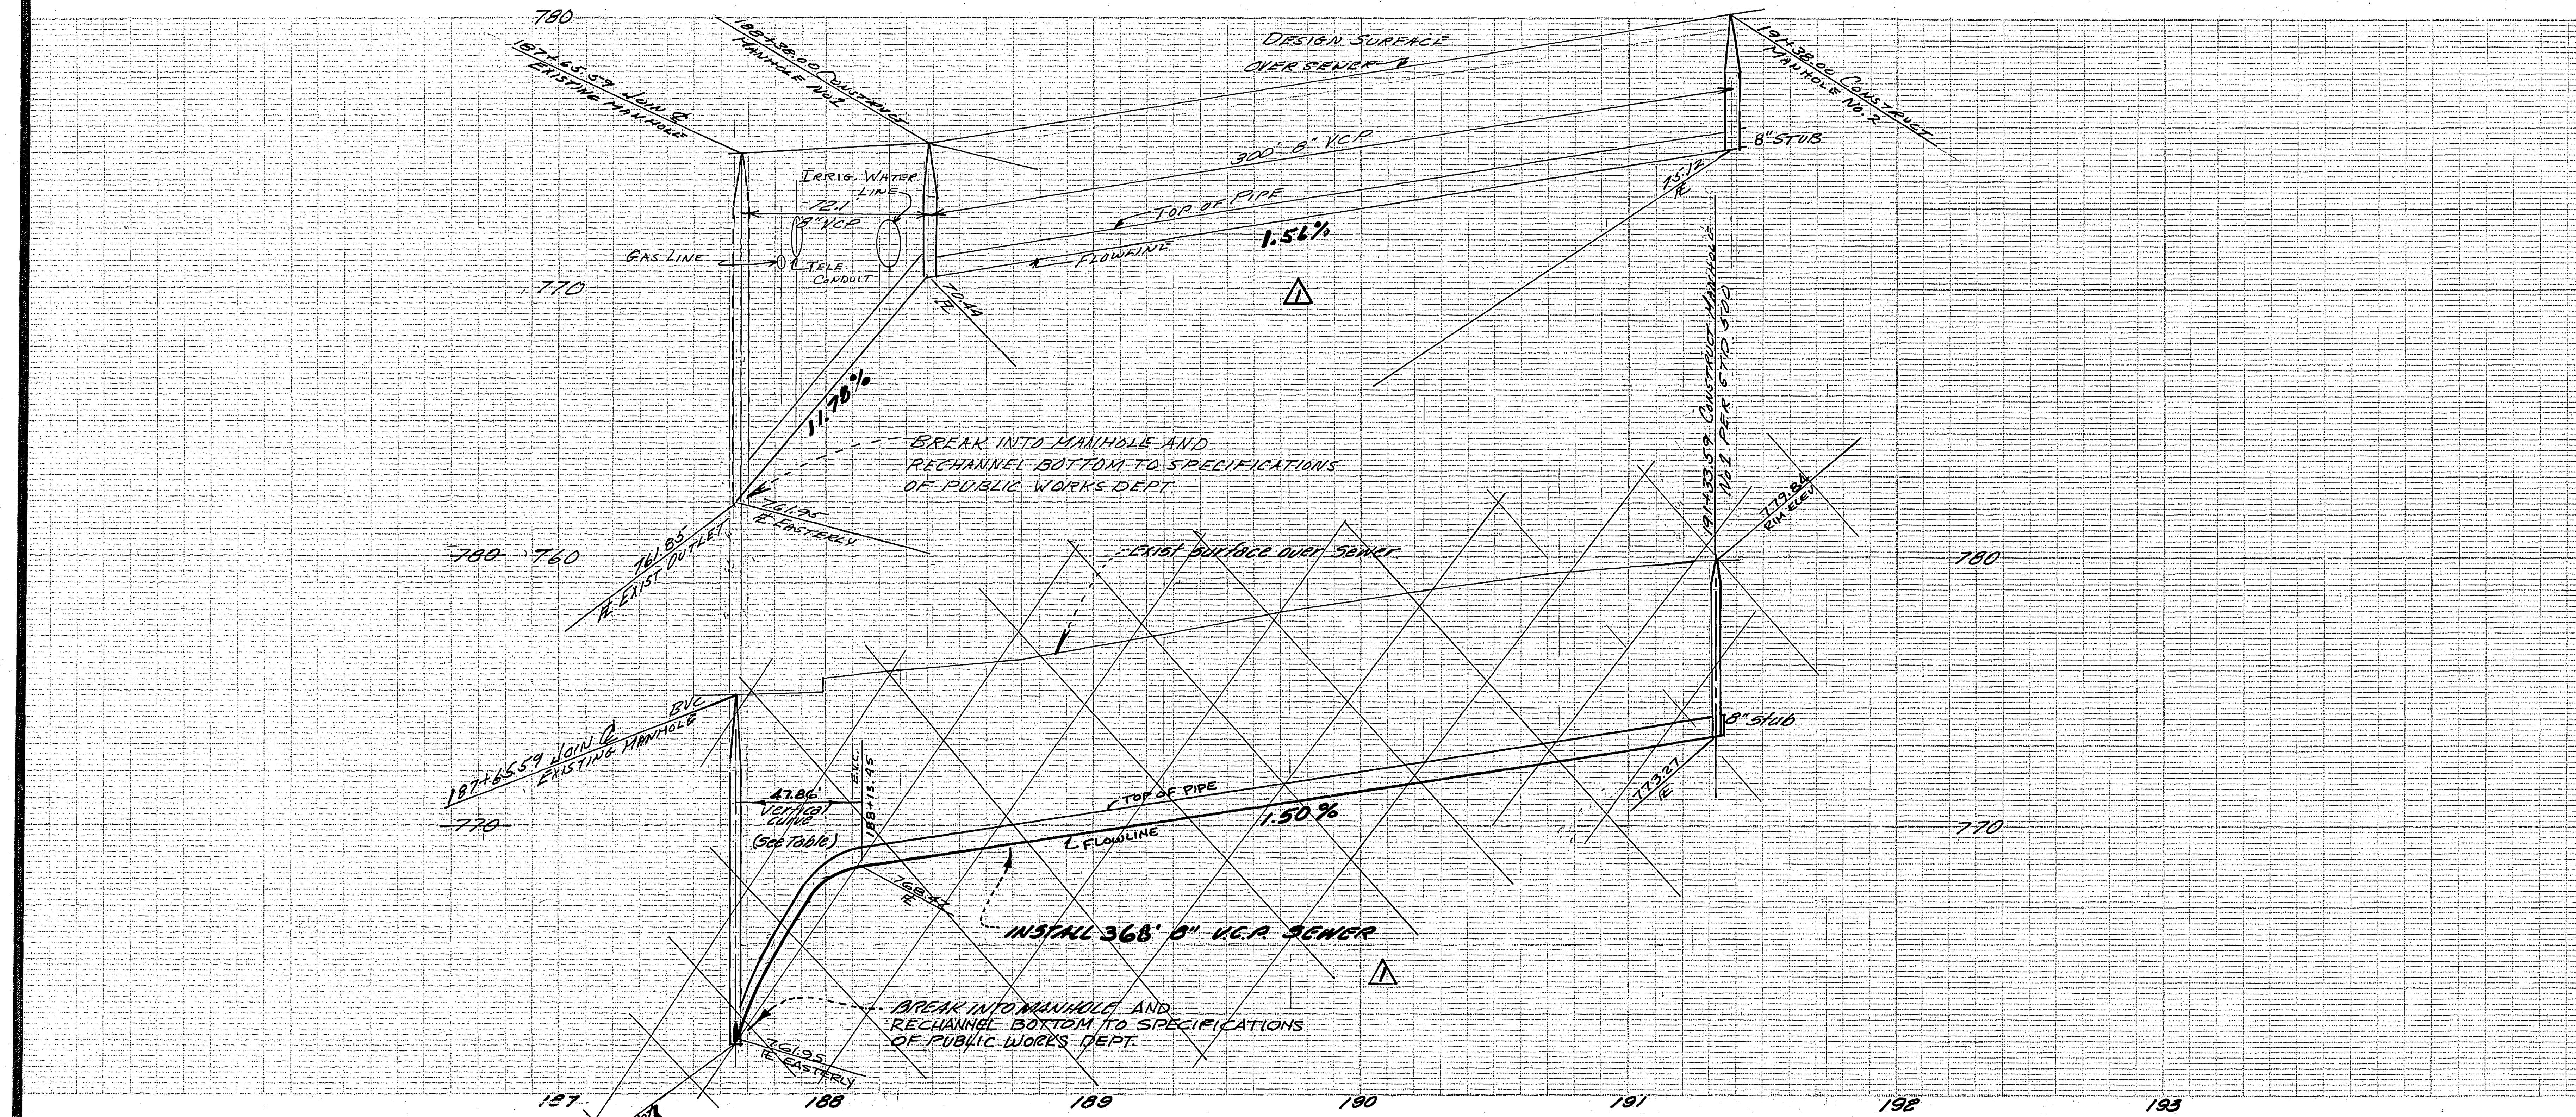

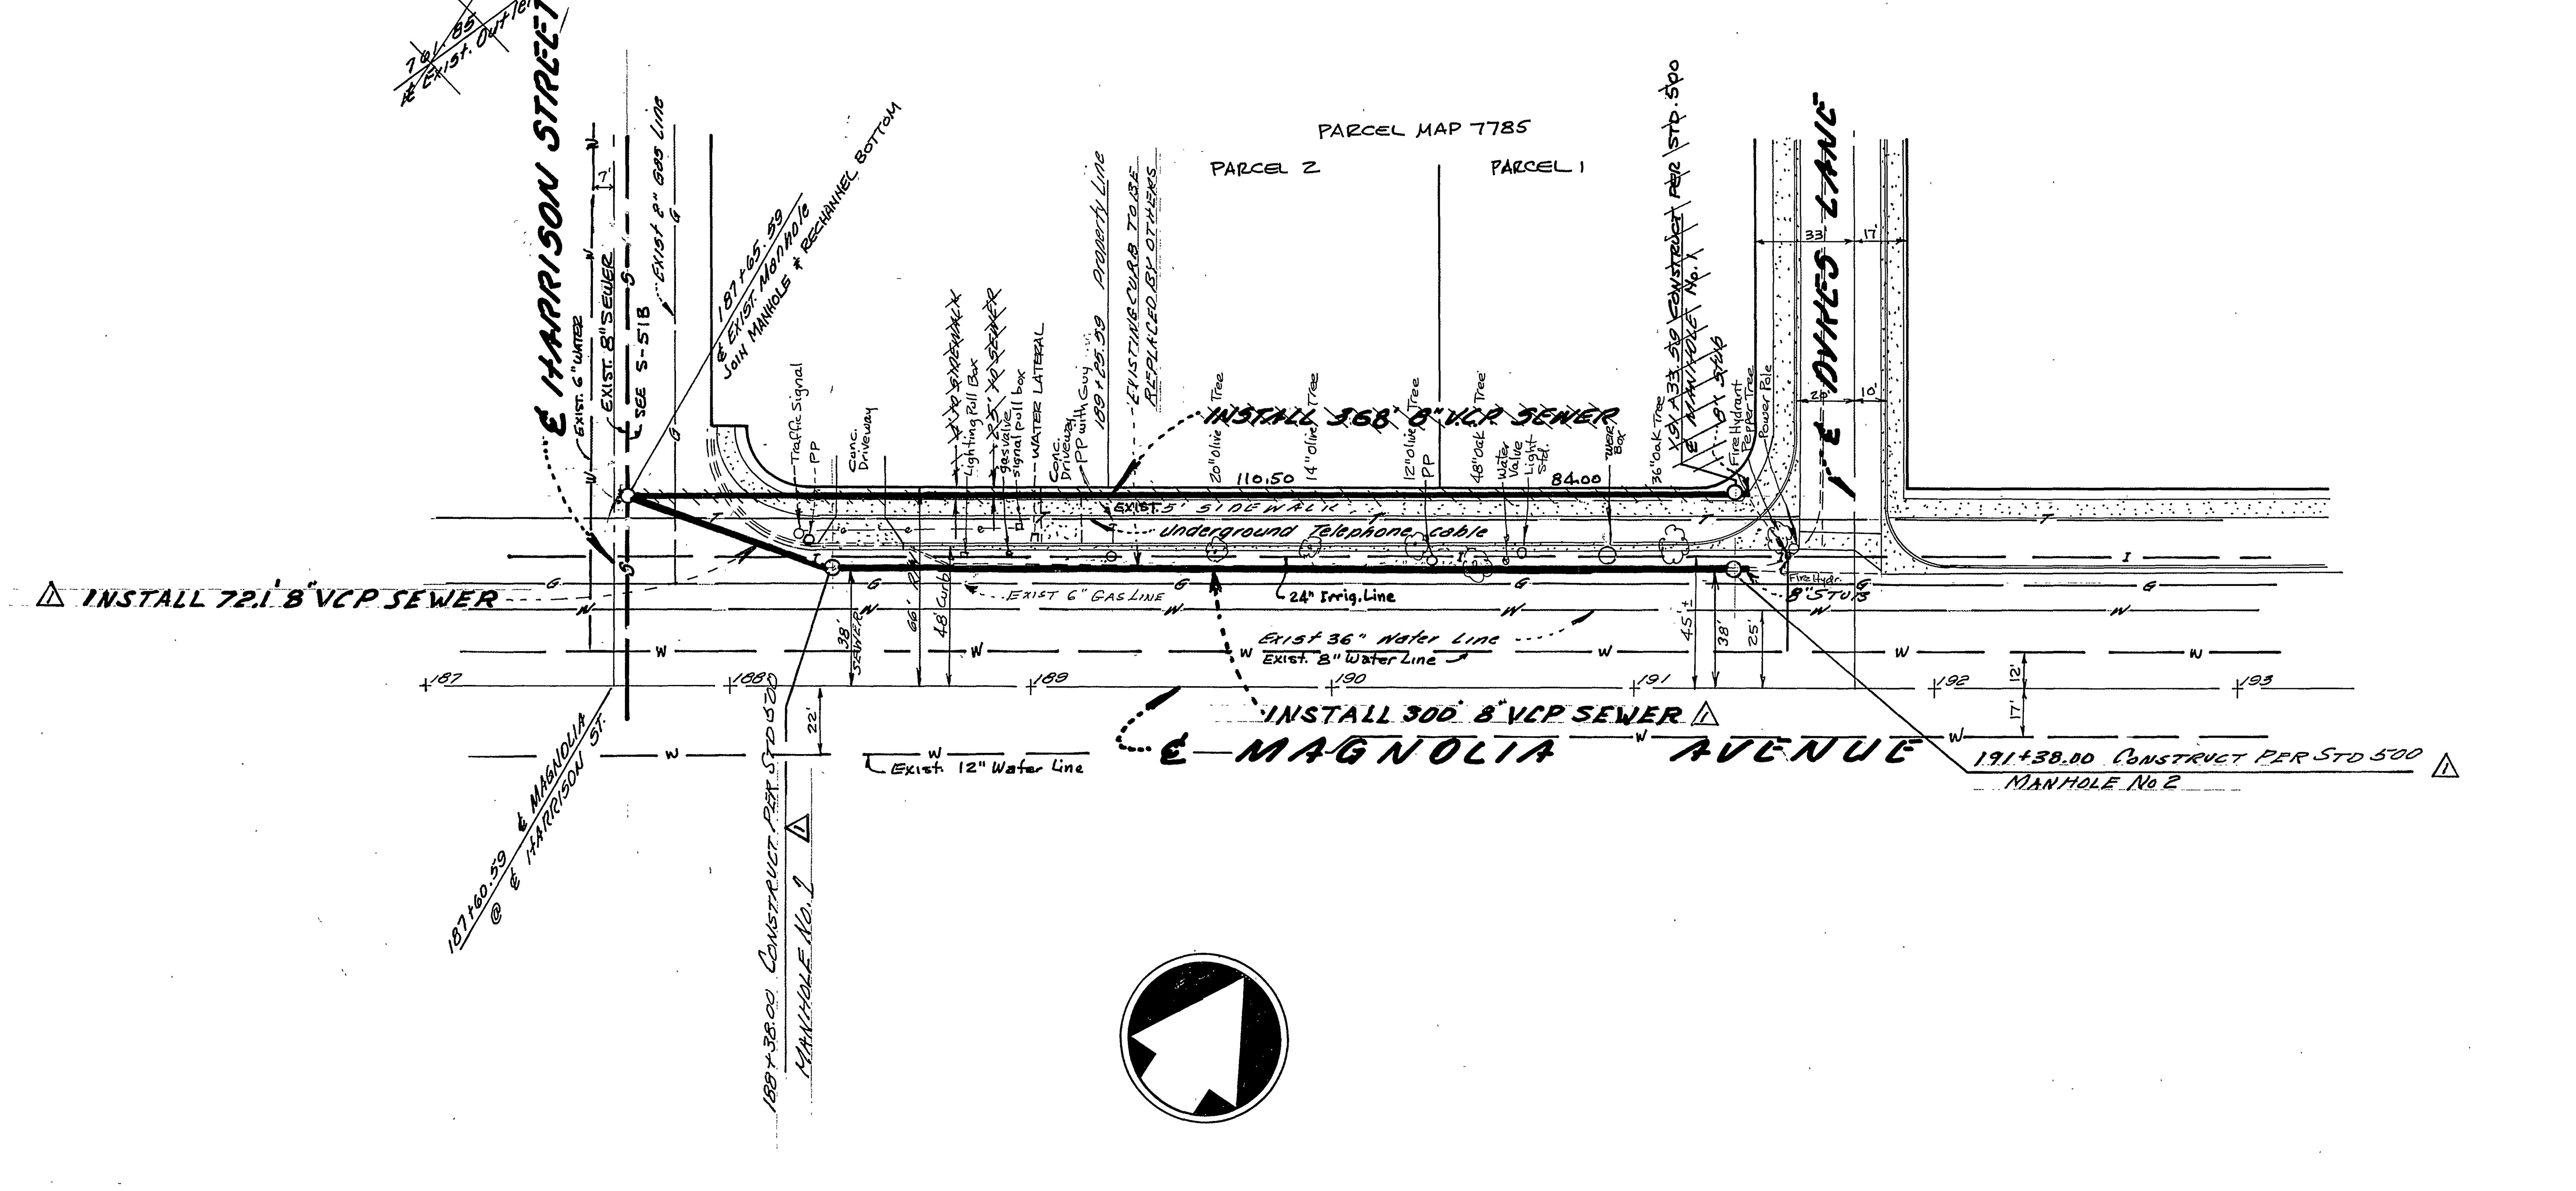

SEWER PROFILE DATA

STATION	FLOWLINE ELEVATION	DESCRIPTION
187+65.59	761.95	℄ MANHOLE - BEGIN V.C.
187+69.45	762.68	
187+73.45	763.84	
187+78.45	764.87	
187+83.45	765.76	
187+88.45	766.53	
187+93.45	767.17	
187+98.45	767.69	
188+03.45	768.07	
188+08.45	768.33	
188+13.45	768.47	END V.C.
188+38.45	768.84	
188+63.45	769.22	
188+88.45	769.59	
189+13.45	769.97	
189+38.45	770.34	
189+63.45	770.72	
189+88.45	771.09	
190+13.45	771.47	
190+38.45	771.84	
190+63.45	772.22	
190+88.45	772.59	
191+33.59	773.27	℄ MANHOLE

GENERAL NOTES

1. Construction shall be in accordance with the City of Riverside standard drawings and the standard specifications for Public Works construction, 1973 Edition.
2. Pipe shall be bedded per Case 1, Std. Drawing # 452, unless otherwise noted.
3. The Water Department shall be notified at least 2 weeks before construction begins (Phone 787-7285)
4. The location of wyes and laterals to be determined in the field at the direction of the owner.
5. It shall be the responsibility of the Contractor to clear the Right of Way in accordance with the provisions of law as it affects each utility including irrigation lines and appurtenances and at no cost to the City.
6. A plug shall be installed and will remain in place where the new sewer connects with the existing sewer until the new sewer is accepted by the City.
7. Contractor is to verify existing sewer elevation prior to construction.

NOTICE TO CONTRACTOR

The existence and location of any underground utility pipes or structures shown on these plans are obtained by a search of the available records. To the best of our knowledge there are no existing utilities except as shown on the plans.

The Contractor is required to take precautionary measures to protect the utility lines shown and any other line not of record or not shown on these plans.

The CONTRACTOR SHALL NOTIFY ALL Utility COMPANIES 14 Days AND 48 Hours prior to start of Construction

So.Cal.Gas Co. 781-6123
Electric Dept. 787-7431
Traffic Signal Shop 787-7576
Water Dept 787-7285

BENCH MARK

* AS BUILT 11-26-79 B.P.

City of Riverside Brass Disc. 0-38 On porch of Arlington Branch of Riverside Public Library, at the Int. of Magnolia Ave. and Roosevelt St. Elev. = 788.35

Construction B.M. (this project only)
Top of 1" I.P. mon. on Northerly R/W line of Magnolia at the Westerly property line of this project. Elev. = 777.05

△1 Craig Smith (714) 792-1338 7-14-78 RCE 20,820

APPROVED BY
Wesley Hylen 8-26-76
CHIEF UTILITIES ENGINEER WATER — DATE

CARLOS F. GUZMAN AND ASSOCIATES
P.O. BOX 607
REDLANDS, CA. 92373
K R King 8-19-76 RCE 13537

MARK	REVISIONS	APPR.	DATE
△1	Relocate sewer to miss footing of Bldg.		1-20-78

DESIGNED BY ____ DRAWN BY ____ CHECKED BY BDM

CITY OF RIVERSIDE, CALIFORNIA
DEPARTMENT OF PUBLIC WORKS

APPROVED BY	BY	DATE
OFFICE ENGINEER	RW	9/27
PARK DEPARTMENT		
TRAFFIC DIVISION		
ASSISTANT CITY ENG.		

APPROVED BY William D. Gardner
DIRECTOR OF PUBLIC WORKS
DATE 9/28/76

SEWER PLAN & PROFILE
PM 7785
MAGNOLIA AVENUE
From HARRISON STREET to DYKES LANE

HORIZ. SCALE: 1" = 40' VERT. SCALE: 1" = 4'

PROJECT NO. INDEXED
S-1049
SHEET 1 OF 1
FILE NO.