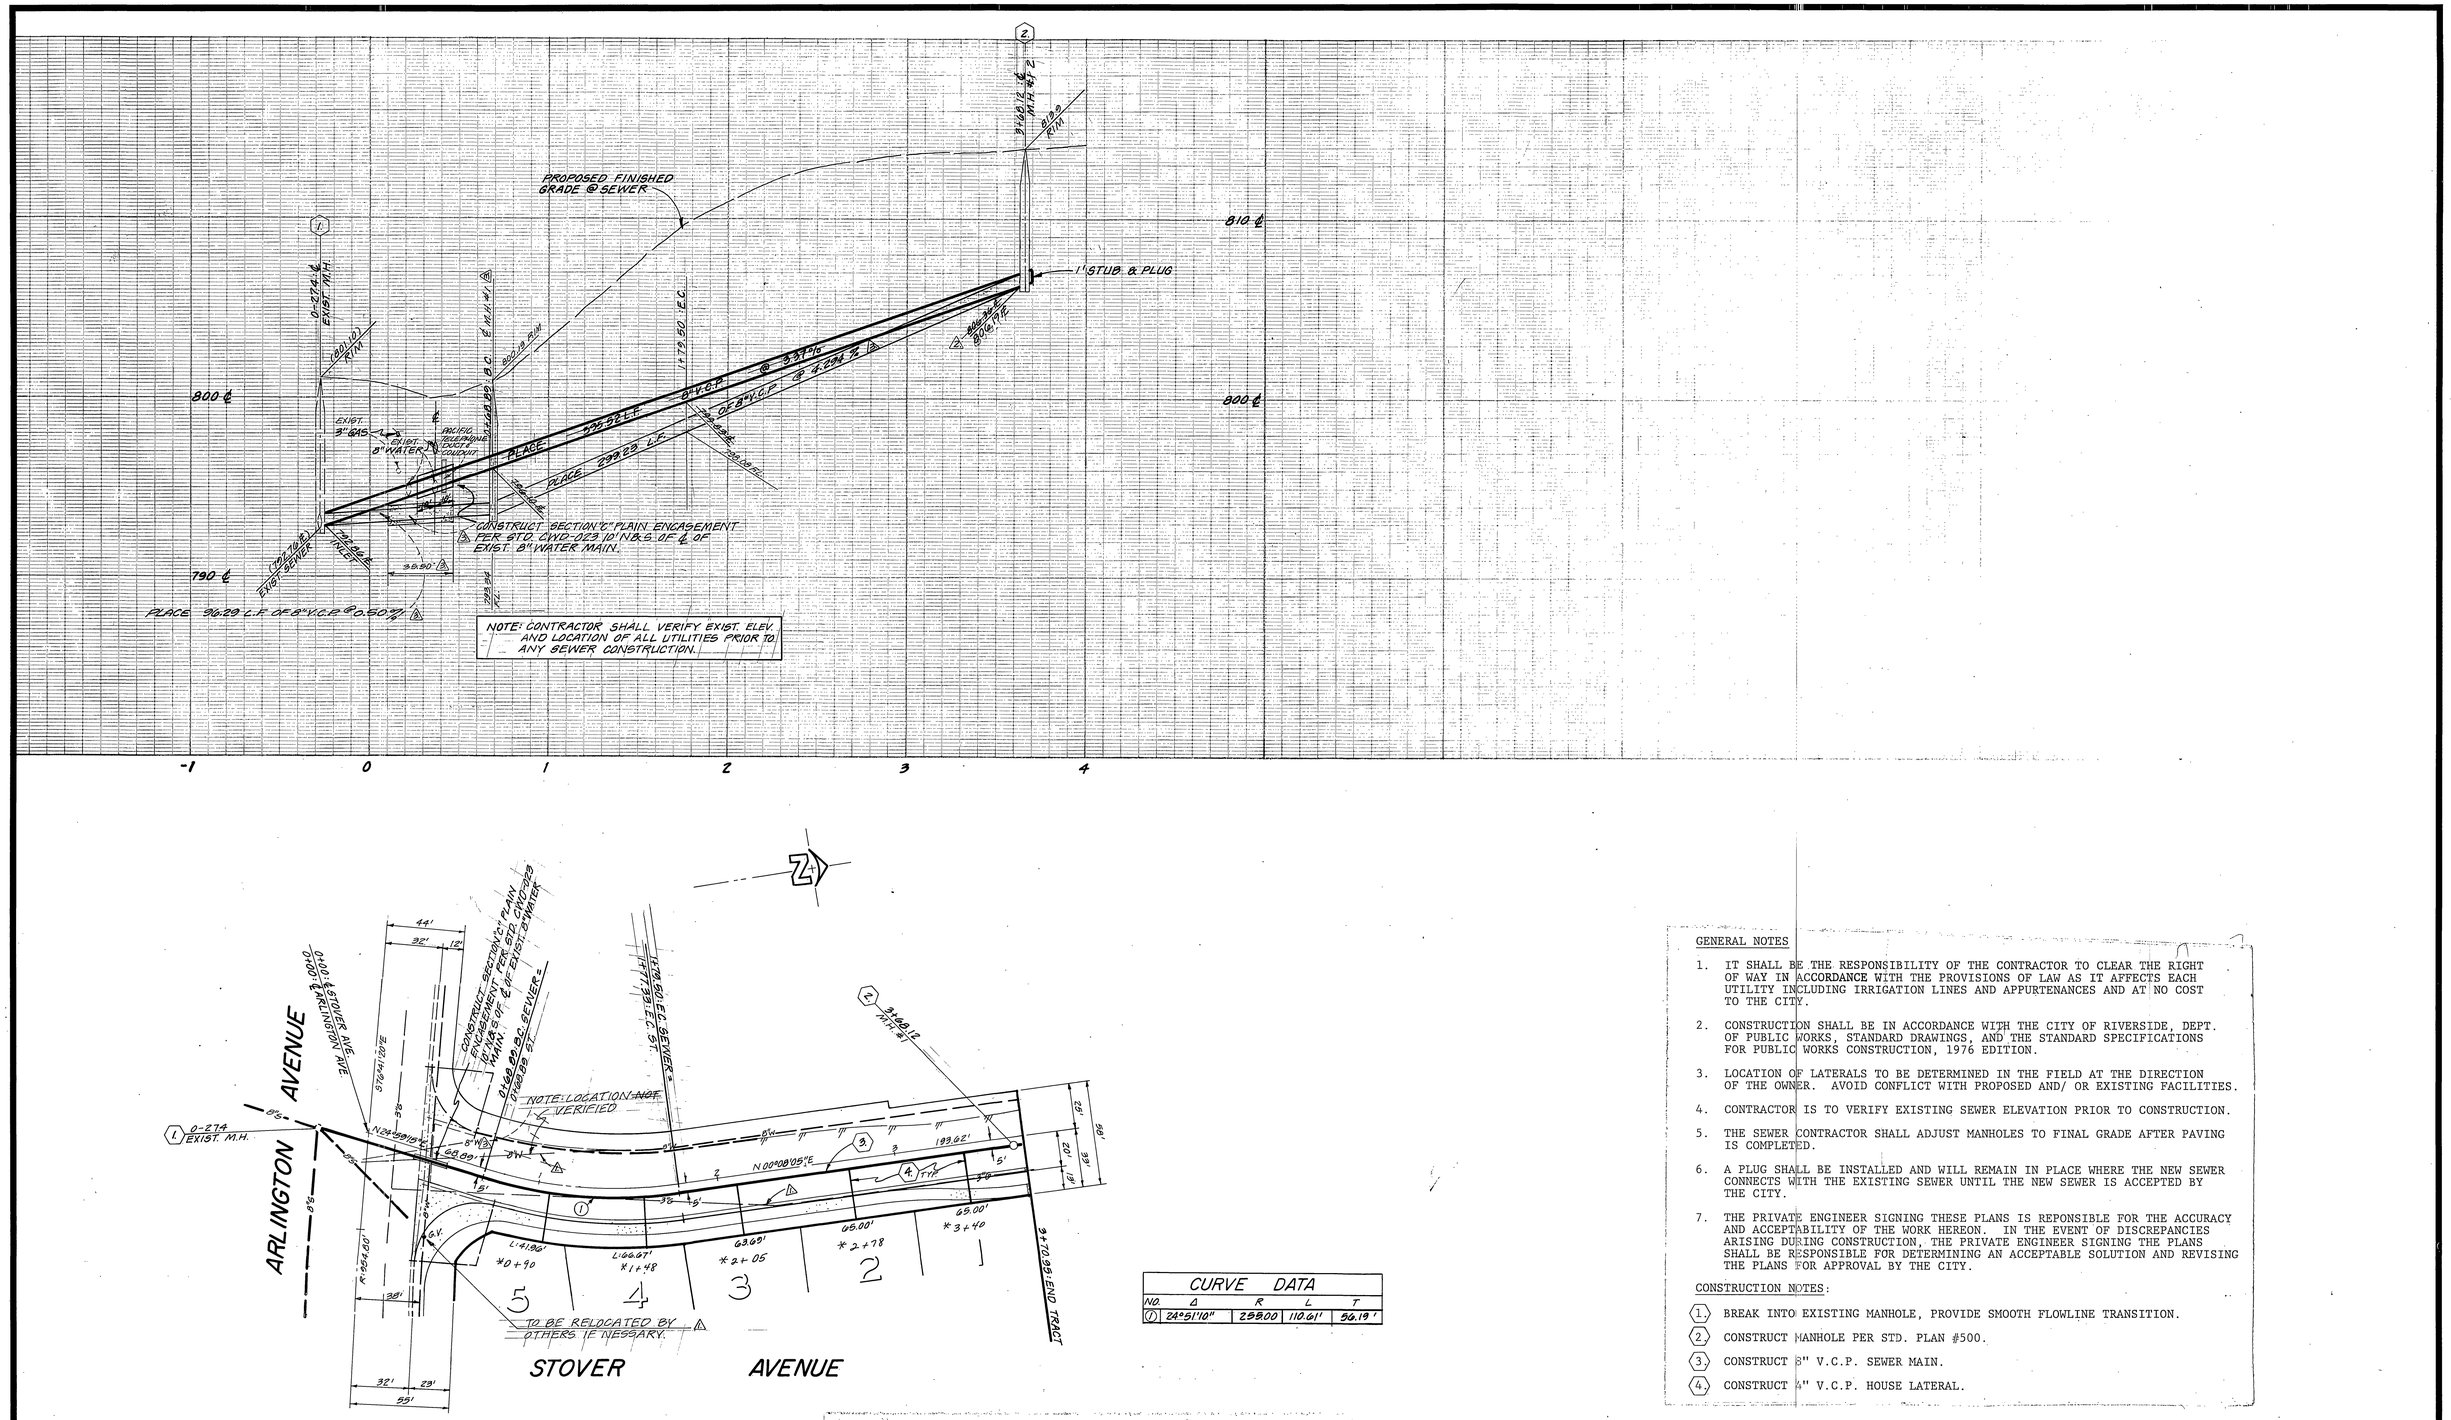

CURVE DATA				
NO.	Δ	R	L	T
1	24°51'10"	255.00	110.61'	56.19'

GENERAL NOTES

1. IT SHALL BE THE RESPONSIBILITY OF THE CONTRACTOR TO CLEAR THE RIGHT OF WAY IN ACCORDANCE WITH THE PROVISIONS OF LAW AS IT AFFECTS EACH UTILITY INCLUDING IRRIGATION LINES AND APPURTENANCES AND AT NO COST TO THE CITY.
2. CONSTRUCTION SHALL BE IN ACCORDANCE WITH THE CITY OF RIVERSIDE, DEPT. OF PUBLIC WORKS, STANDARD DRAWINGS, AND THE STANDARD SPECIFICATIONS FOR PUBLIC WORKS CONSTRUCTION, 1976 EDITION.
3. LOCATION OF LATERALS TO BE DETERMINED IN THE FIELD AT THE DIRECTION OF THE OWNER. AVOID CONFLICT WITH PROPOSED AND/ OR EXISTING FACILITIES.
4. CONTRACTOR IS TO VERIFY EXISTING SEWER ELEVATION PRIOR TO CONSTRUCTION.
5. THE SEWER CONTRACTOR SHALL ADJUST MANHOLES TO FINAL GRADE AFTER PAVING IS COMPLETED.
6. A PLUG SHALL BE INSTALLED AND WILL REMAIN IN PLACE WHERE THE NEW SEWER CONNECTS WITH THE EXISTING SEWER UNTIL THE NEW SEWER IS ACCEPTED BY THE CITY.
7. THE PRIVATE ENGINEER SIGNING THESE PLANS IS REPONSIBLE FOR THE ACCURACY AND ACCEPTABILITY OF THE WORK HEREON. IN THE EVENT OF DISCREPANCIES ARISING DURING CONSTRUCTION, THE PRIVATE ENGINEER SIGNING THE PLANS SHALL BE RESPONSIBLE FOR DETERMINING AN ACCEPTABLE SOLUTION AND REVISING THE PLANS FOR APPROVAL BY THE CITY.

CONSTRUCTION NOTES:

1. BREAK INTO EXISTING MANHOLE, PROVIDE SMOOTH FLOWLINE TRANSITION.
2. CONSTRUCT MANHOLE PER STD. PLAN #500.
3. CONSTRUCT 8" V.C.P. SEWER MAIN.
4. CONSTRUCT 4" V.C.P. HOUSE LATERAL.

Contractor agrees that he shall assume sole and complete responsibility for job site conditions during the course of construction of this Project, including safety of all persons and property; that this requirement shall apply continuously and not be limited to normal working hours; and that the Contractor shall defend, indemnify and hold the Owner and the Engineer harmless from any and all liability, real or alleged, in connection with the performance of work on this Project, excepting for liability arising from the sole negligence of the Owner or the Engineer.

BENCH MARK

CITY BENCH MARK 62-D ED. 1VA" I.P. & CO. TAG CAPPED, @ INTERSECTION OF ARLINGTON AVE. & MITCHELL AVE. FB. 237/57.

ELEV: 800.374

CITY OF RIVERSIDE
DOMESTIC SYSTEM

BY: Wesley Stafen 8-10-77
CHIEF UTILITIES ENGINEER, WATER DATE

J. F. DAVIDSON ASSOCIATES
CIVIL ENGINEERS - SURVEYORS - PLANNERS
RIVERSIDE, CALIFORNIA

APPROVED BY Jack W Canty DATE 5/6/77
R.E. No. 17550

W.O. 5045 FOR: TRADE WEST ENG. INC. F.B. 1012

MARK	REVISIONS	APPR.	DATE
3	REVISED ALIGNMENT & ADDED MANHOLES		11/14/77
2	CHANGED ELEV TO CONFORM TO GRADES		11/1/77
1	ADDED ADDITIONAL UTILITIES		8/8/77

DESIGNED BY D.S. DRAWN BY D.S. CHECKED BY

CITY OF RIVERSIDE, CALIFORNIA
DEPARTMENT OF PUBLIC WORKS

	BY	DATE
APPROVED BY		
PRINCIPAL ENGINEER		
PARK DEPARTMENT		
TRAFFIC DIVISION		
CHIEF P. W. ENGR.		

APPROVED BY William D. Hendricks
DIRECTOR OF PUBLIC WORKS
DATE 8/16/77

*AS BUILT 8-78 KPT

INDEXED R.R.

SEWER PLAN & PROFILE
TRACT 8885
STOVER AVENUE

PROJECT NO. S-1115

SHEET 1 OF 1

HORIZ. SCALE: 1" = 40' VERT. SCALE: 1" = 4'

FILE NO. 5531