



PROFILE PLAN
SCALE HORIZ. 1" = 40'
VERT. 1" = 8'

A SEVEN (7) DAY ADVANCE NOTIFICATION IS REQUIRED PRIOR TO STARTING WORK WITHIN THE DEPARTMENT OF WATER RESOURCES EASEMENT. CONTACT THE DIVISION OF LAND AND RIGHT OF WAY ENCROACHMENT PERMIT SECTION SACRAMENTO CALIFORNIA AT (916)-448-7360.


ALL TRENCHES SHALL BE EXCAVATED TO COMPLY WITH FEDERAL OCCUPATIONAL SAFETY HEALTH ADMINISTRATION STANDARDS NO. 2207 TRENCH BACKFILL SHALL BE PLACED IN NO GREATER THAN 4-INCH LIFTS IF HAND COMPACTED OR NO GREATER THAN 8-INCH LIFTS IF POWER COMPACTED. BACKFILL COMPACTED WITHIN DWR'S EASEMENT SHALL BE COMPACTED TO 90 PERCENT RELATIVE COMPACTION (ASTM D698).

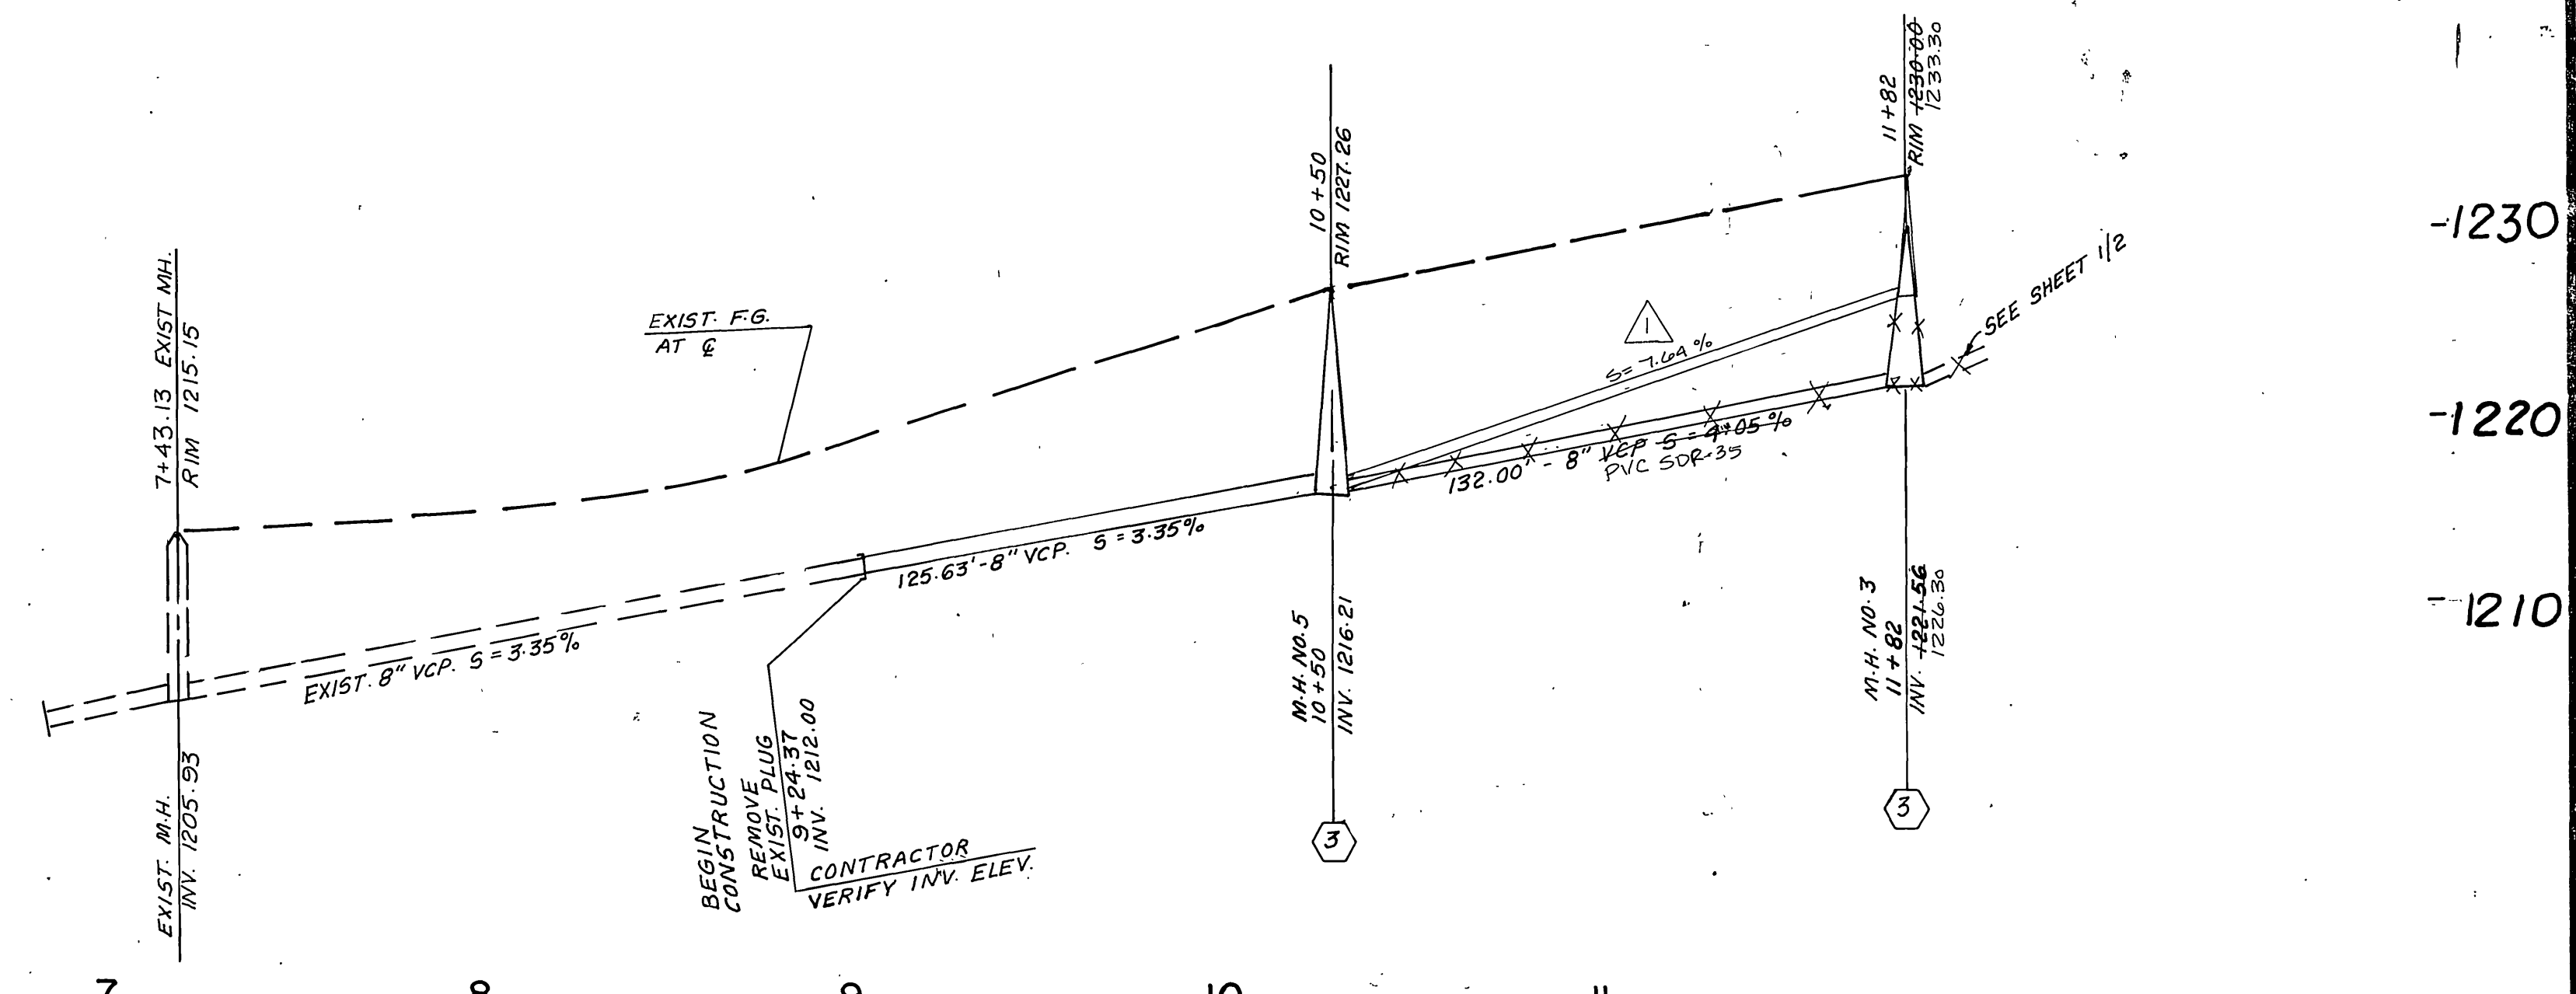

MT. VERNON AVE.
SEWER LINE EXT.

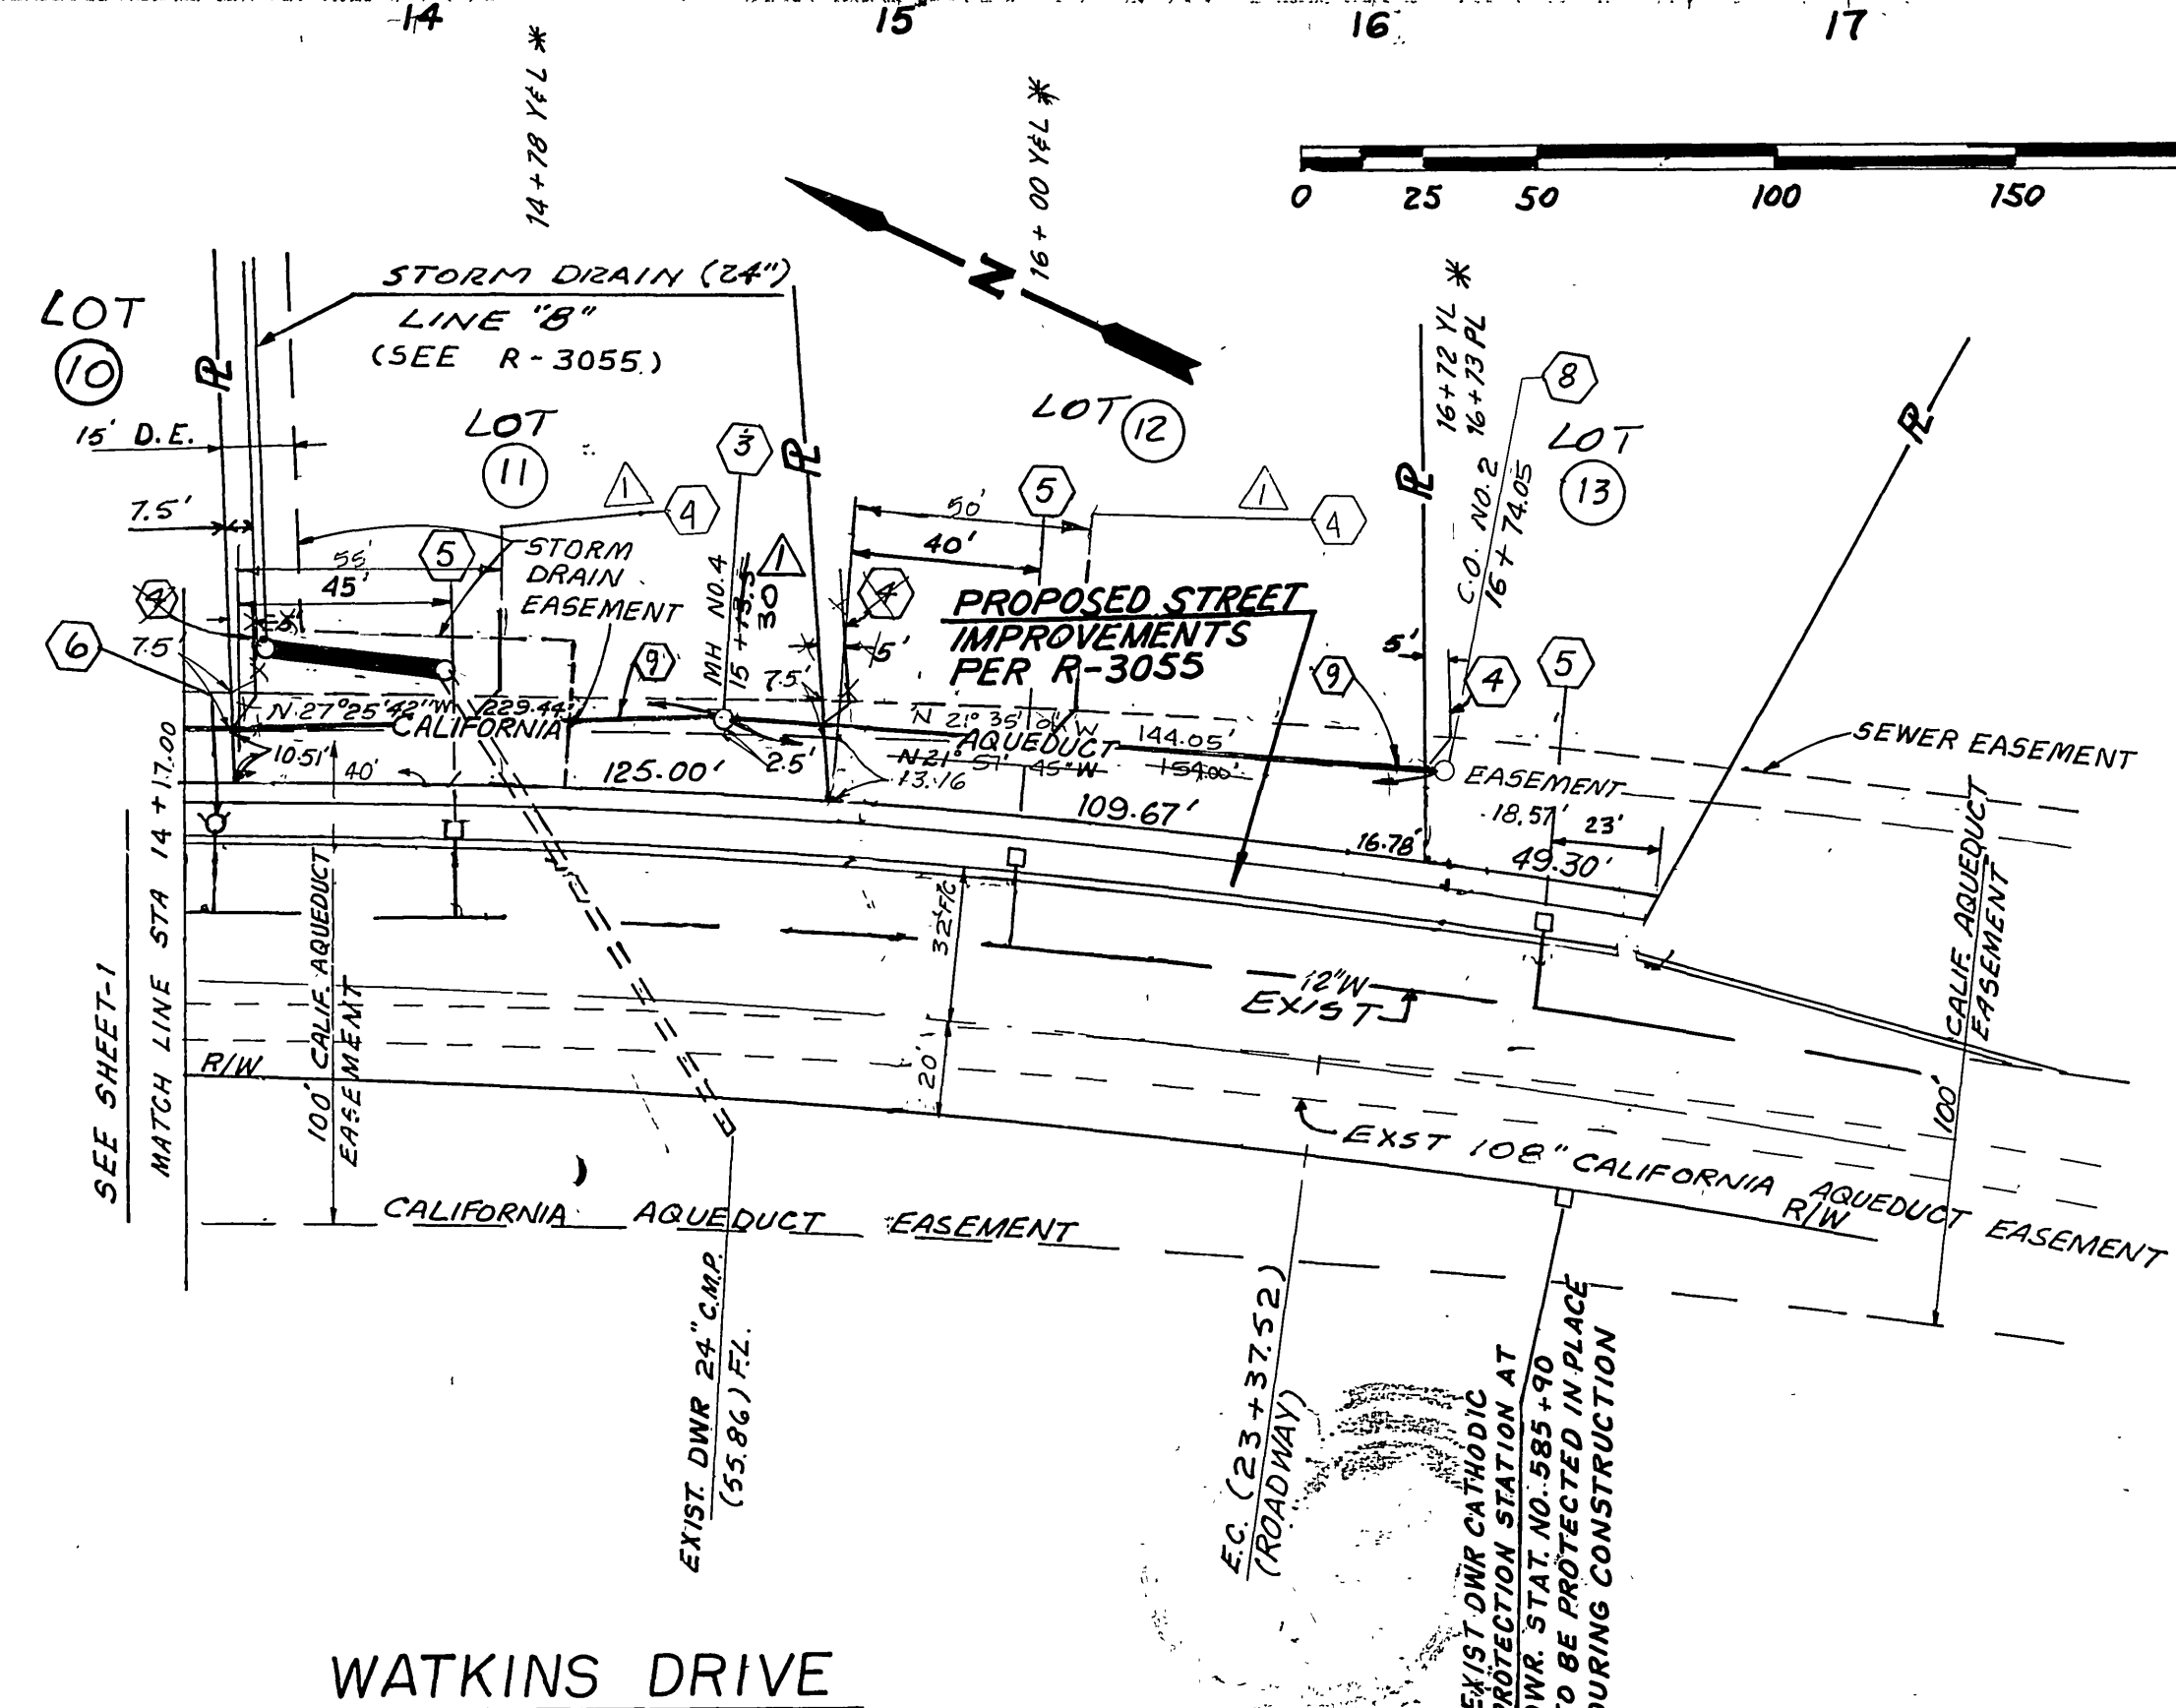

WATKINS DRIVE

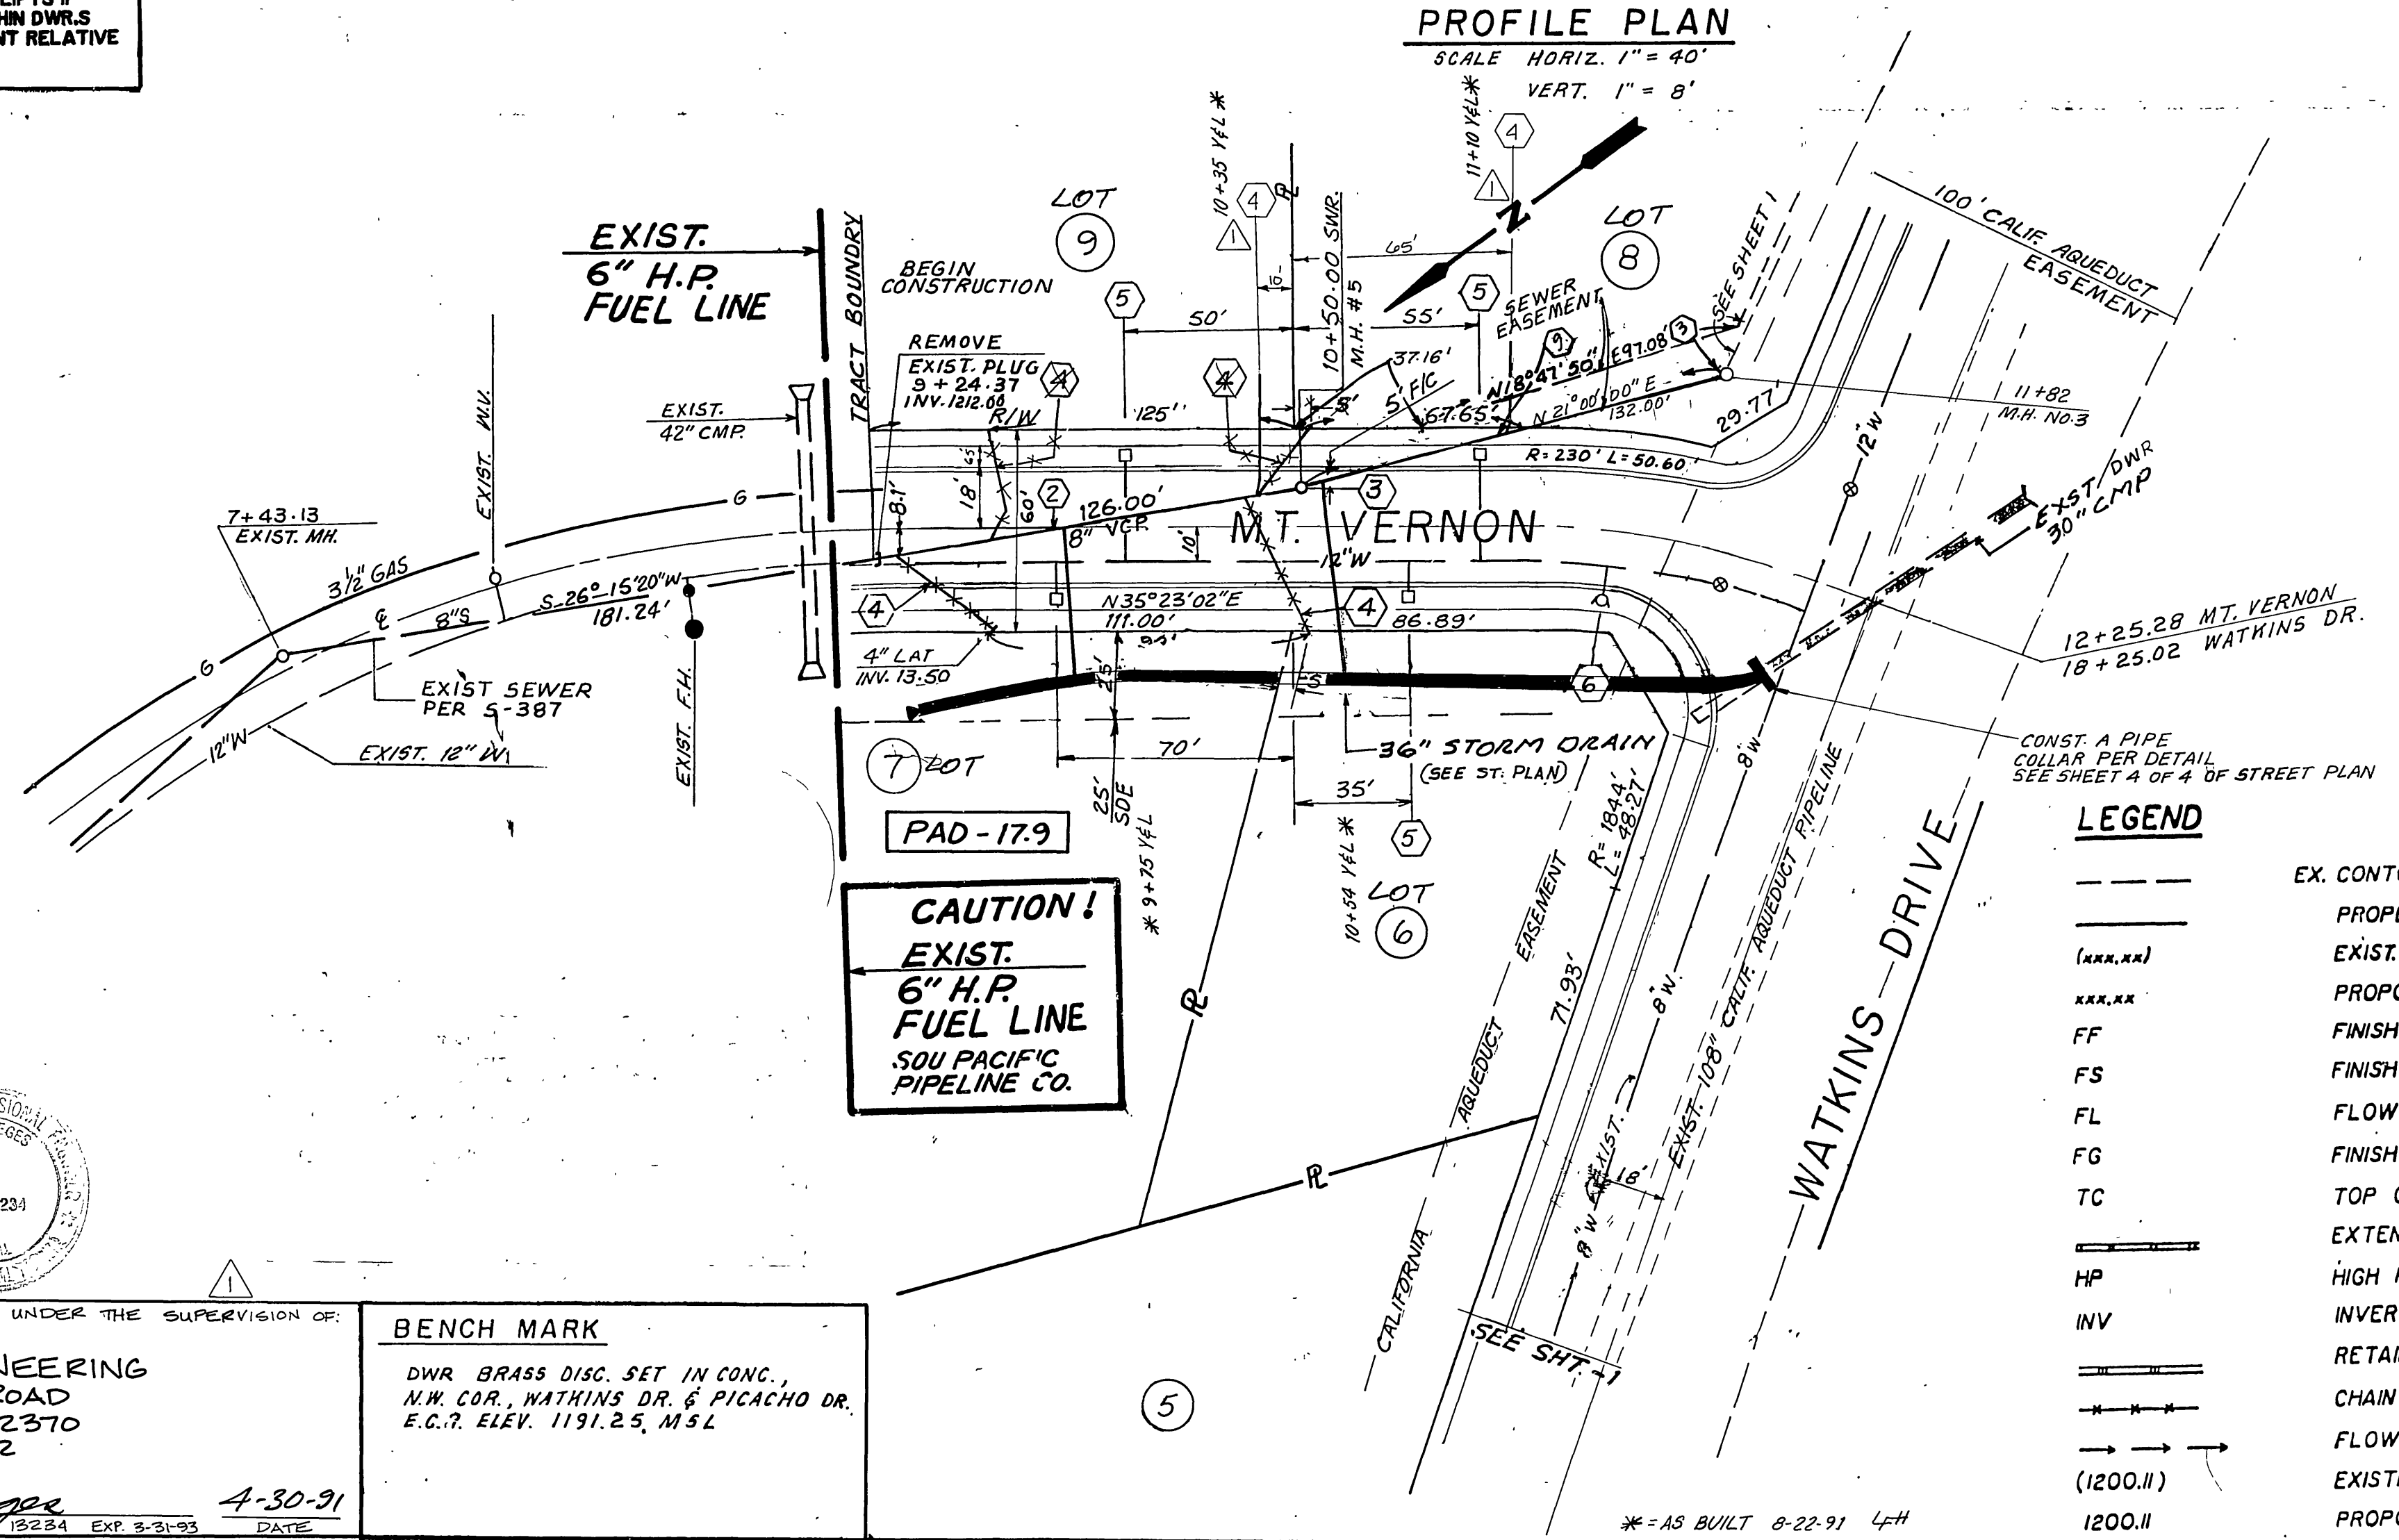

LEGEND

---	EX. CONTOUR LINES
---	PROPERTY LINES
(XXX.XX)	EXIST. ELEVATION
XXX.XX	PROPOSED ELEV.
FF	FINISH FLOOR
FS	FINISH SURFACE
FL	FLOW LINE
FG	FINISH GRADE
TC	TOP OF CURB
---	EXTENDED FOOTING
HP	HIGH POINT
INV	INVERT ELEV.
---	RETAINING WALL
---	CHAIN LINK FENCE
---	FLOW LINE
(1200.II)	EXISTING ELEV.
1200.II	PROPOSED ELEV.



CITY OF RIVERSIDE WATER SYSTEM

SIGNED BY *Richard J. Duda*

DATE 3-8-90

REVISIONS PREPARED UNDER THE SUPERVISION OF:

PERRIS ENGINEERING
1051 DAVIDS ROAD
PERRIS, CA. 92370
(714) 657-2822

Paul Dieges 4-30-91
PAUL DIEGES R.C.E. 12234 EXP. 3-31-93

BENCH MARK

DWR BRASS DISC. SET IN CONC.,
N.W. COR. WATKINS DR. & PICACHO DR.
E.C.P. ELEV. 1191.25, M.S.L.

LEGAL DESCRIPTION

A PORTION OF SEC. 20 & 29 T2S., R. 4W. S.B. & M. BOUNDED BY WATKINS DR. & INTERSECTED BY MT. VERNON AVE. AS SHOWN BY MAP BOOK 64, PG. 189 PER RECORDS OF RIVERSIDE COUNTY, CONTAINING 10.54± ACRES.

ACREAGE LAND SYSTEMS Inc.

102 E. GRAND BLVD.
CORONA, CA 91719
(714) 734-0152

REVISOR	DATE	BY
1	11/9/90	Paul Dieges
2	11/21/90	Paul Dieges
3	11/21/90	Paul Dieges
CITY OF RIVERSIDE PUBLIC WORKS DEPARTMENT

APPROVED BY *Barry Ford* DATE 11/26/90

CHIEF P.W. ENGINEER

SEWER PLAN 27171

TRACT NO. 23064

WATKINS DR. & MT. VERNON AVE.

HORIZ. SCALE: 1" = 40' VERT. SCALE: 1" = 8'

ACCOUNT NO. S-1543

SHEET 2 OF 2