


PROFILE
 HORIZ. SCALE 1" = 40'
 VERT. SCALE 1" = 4'

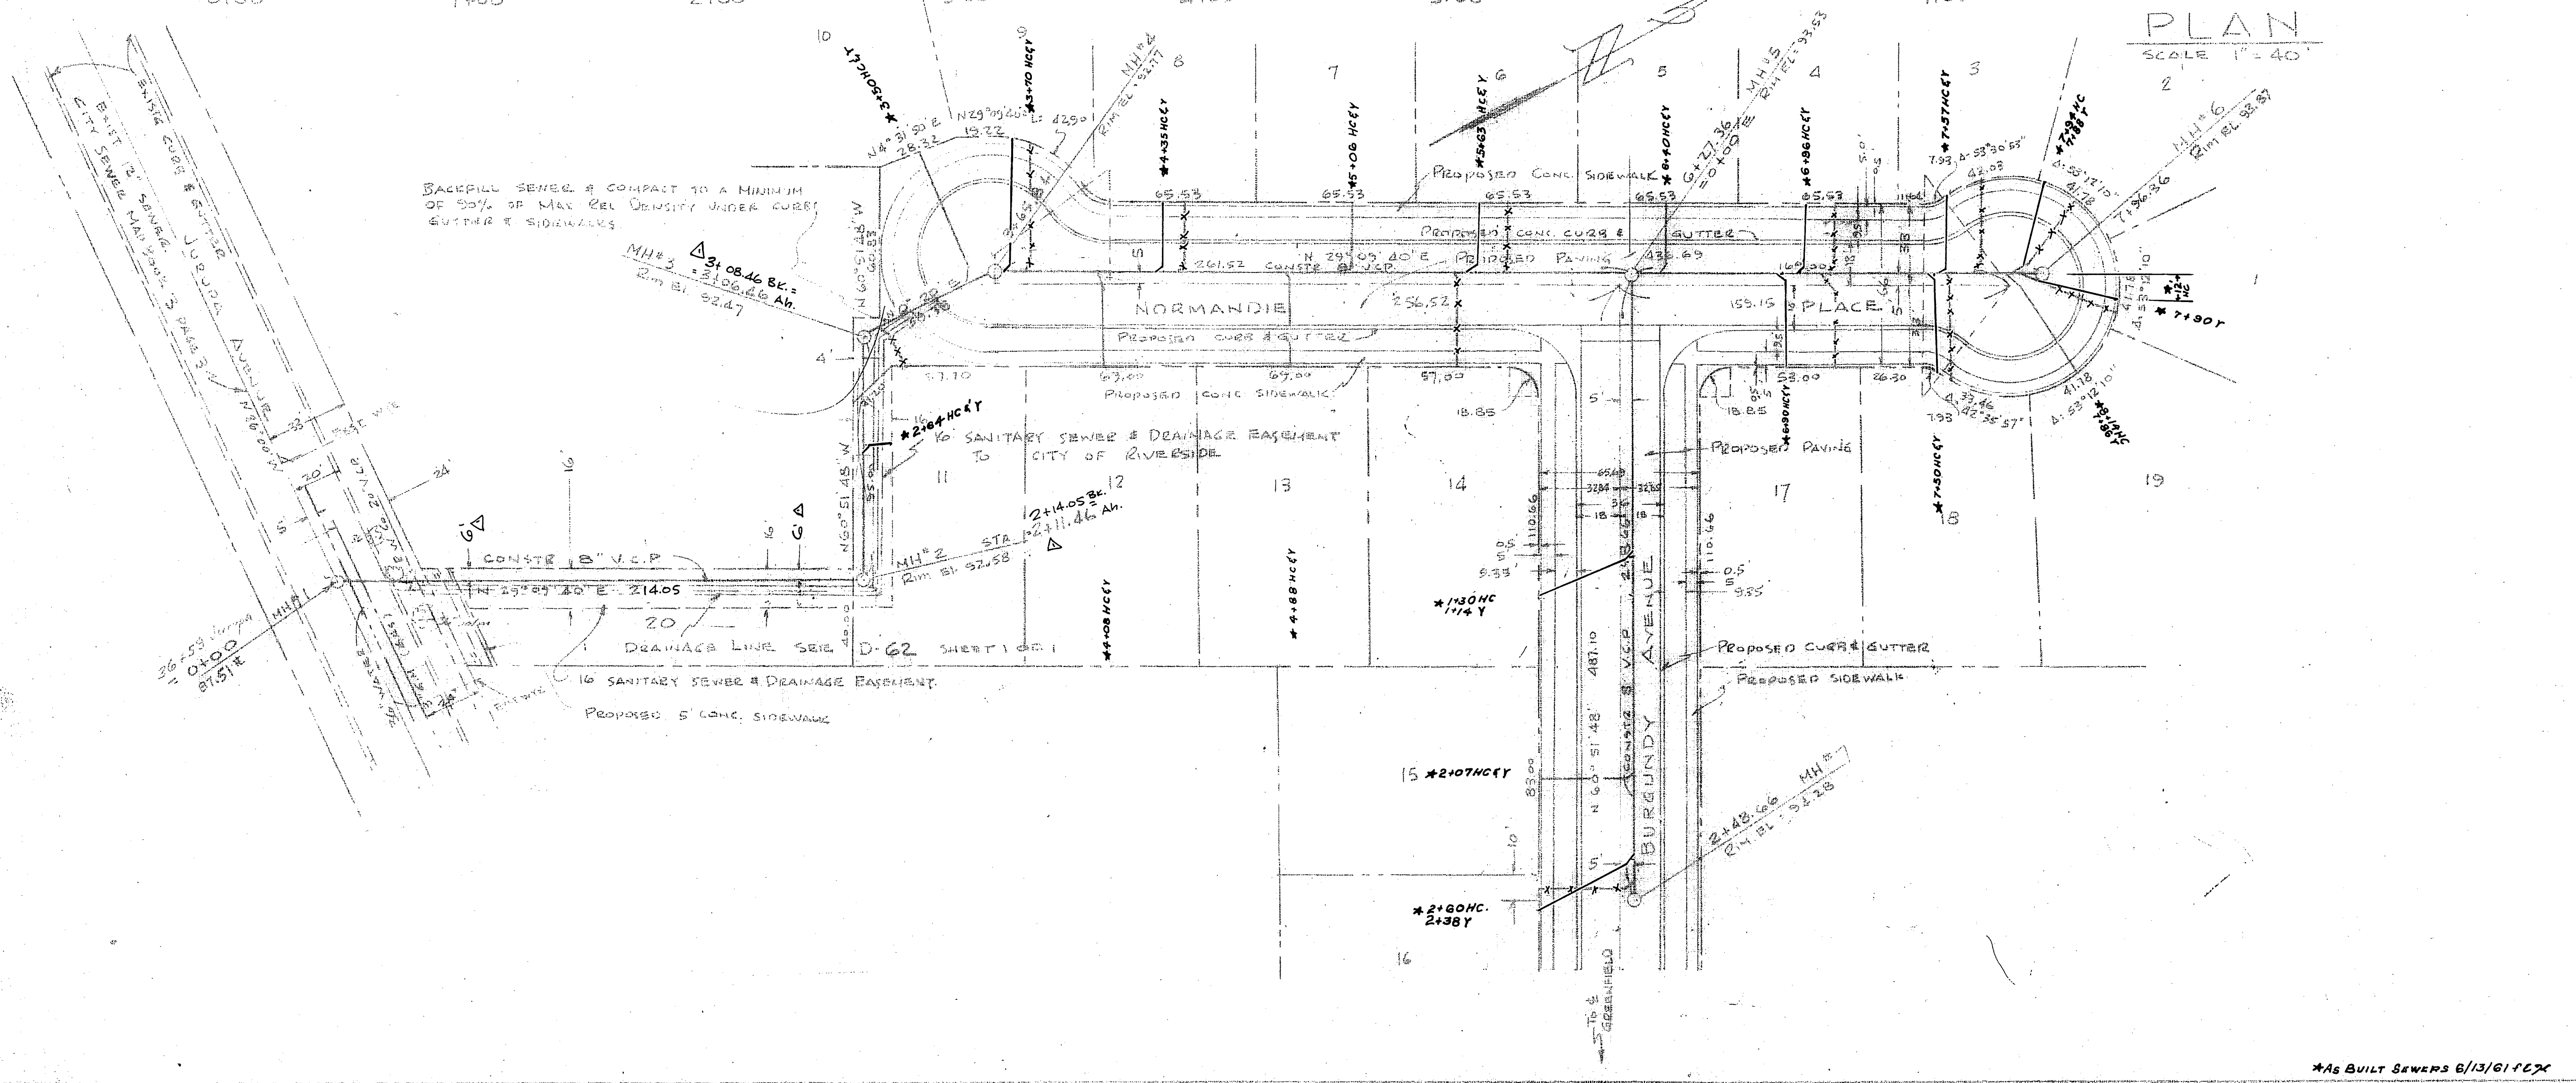

PLAN
 SCALE 1" = 40'

GENERAL NOTES:

B.M. - P.K. EAST CUES MEADOWBROOK LANE 15' NORTH OF JURUPA AVE RETURN. U.S.G.S. EL. 791.55

ALL CONSTRUCTION SHALL CONFORM TO STANDARD DWGS. AND SPECIFICATION 460 OF THE CITY OF RIVERSIDE

CONSTRUCT STD. MANHOLE (SHOWN AS MH) AS PER CITY STANDARD DRAWING No. 500

HOUSE CONNECTIONS TO BE FIELD LOCATED.

MANHOLE RIMS IN UNIMPROVED AREAS SHALL BE LOCATED 2' MINIMUM OF 6" ABOVE GRADE.

REVISIONS MARK DATE DESCRIPTION			CITY OF RIVERSIDE CALIFORNIA DEPARTMENT OF PUBLIC WORKS SEWER PLAN & PROFILE NORMANDIE PL. & BURGUNDY AVENUE TRACT NO. 2101 SCALE 1" = 40' HORIZ. 1/2" VERT.
Δ	9/21/61	MOVE 8" V.C.P. SEWER 2' EAST TO MISS TREE. W.S. 0179	
DESIGNED BY	CHECKED BY	APPROVED BY	No. S-284 SHEET 1 OF 1
RECOMMENDED BY	DATE	DATE	