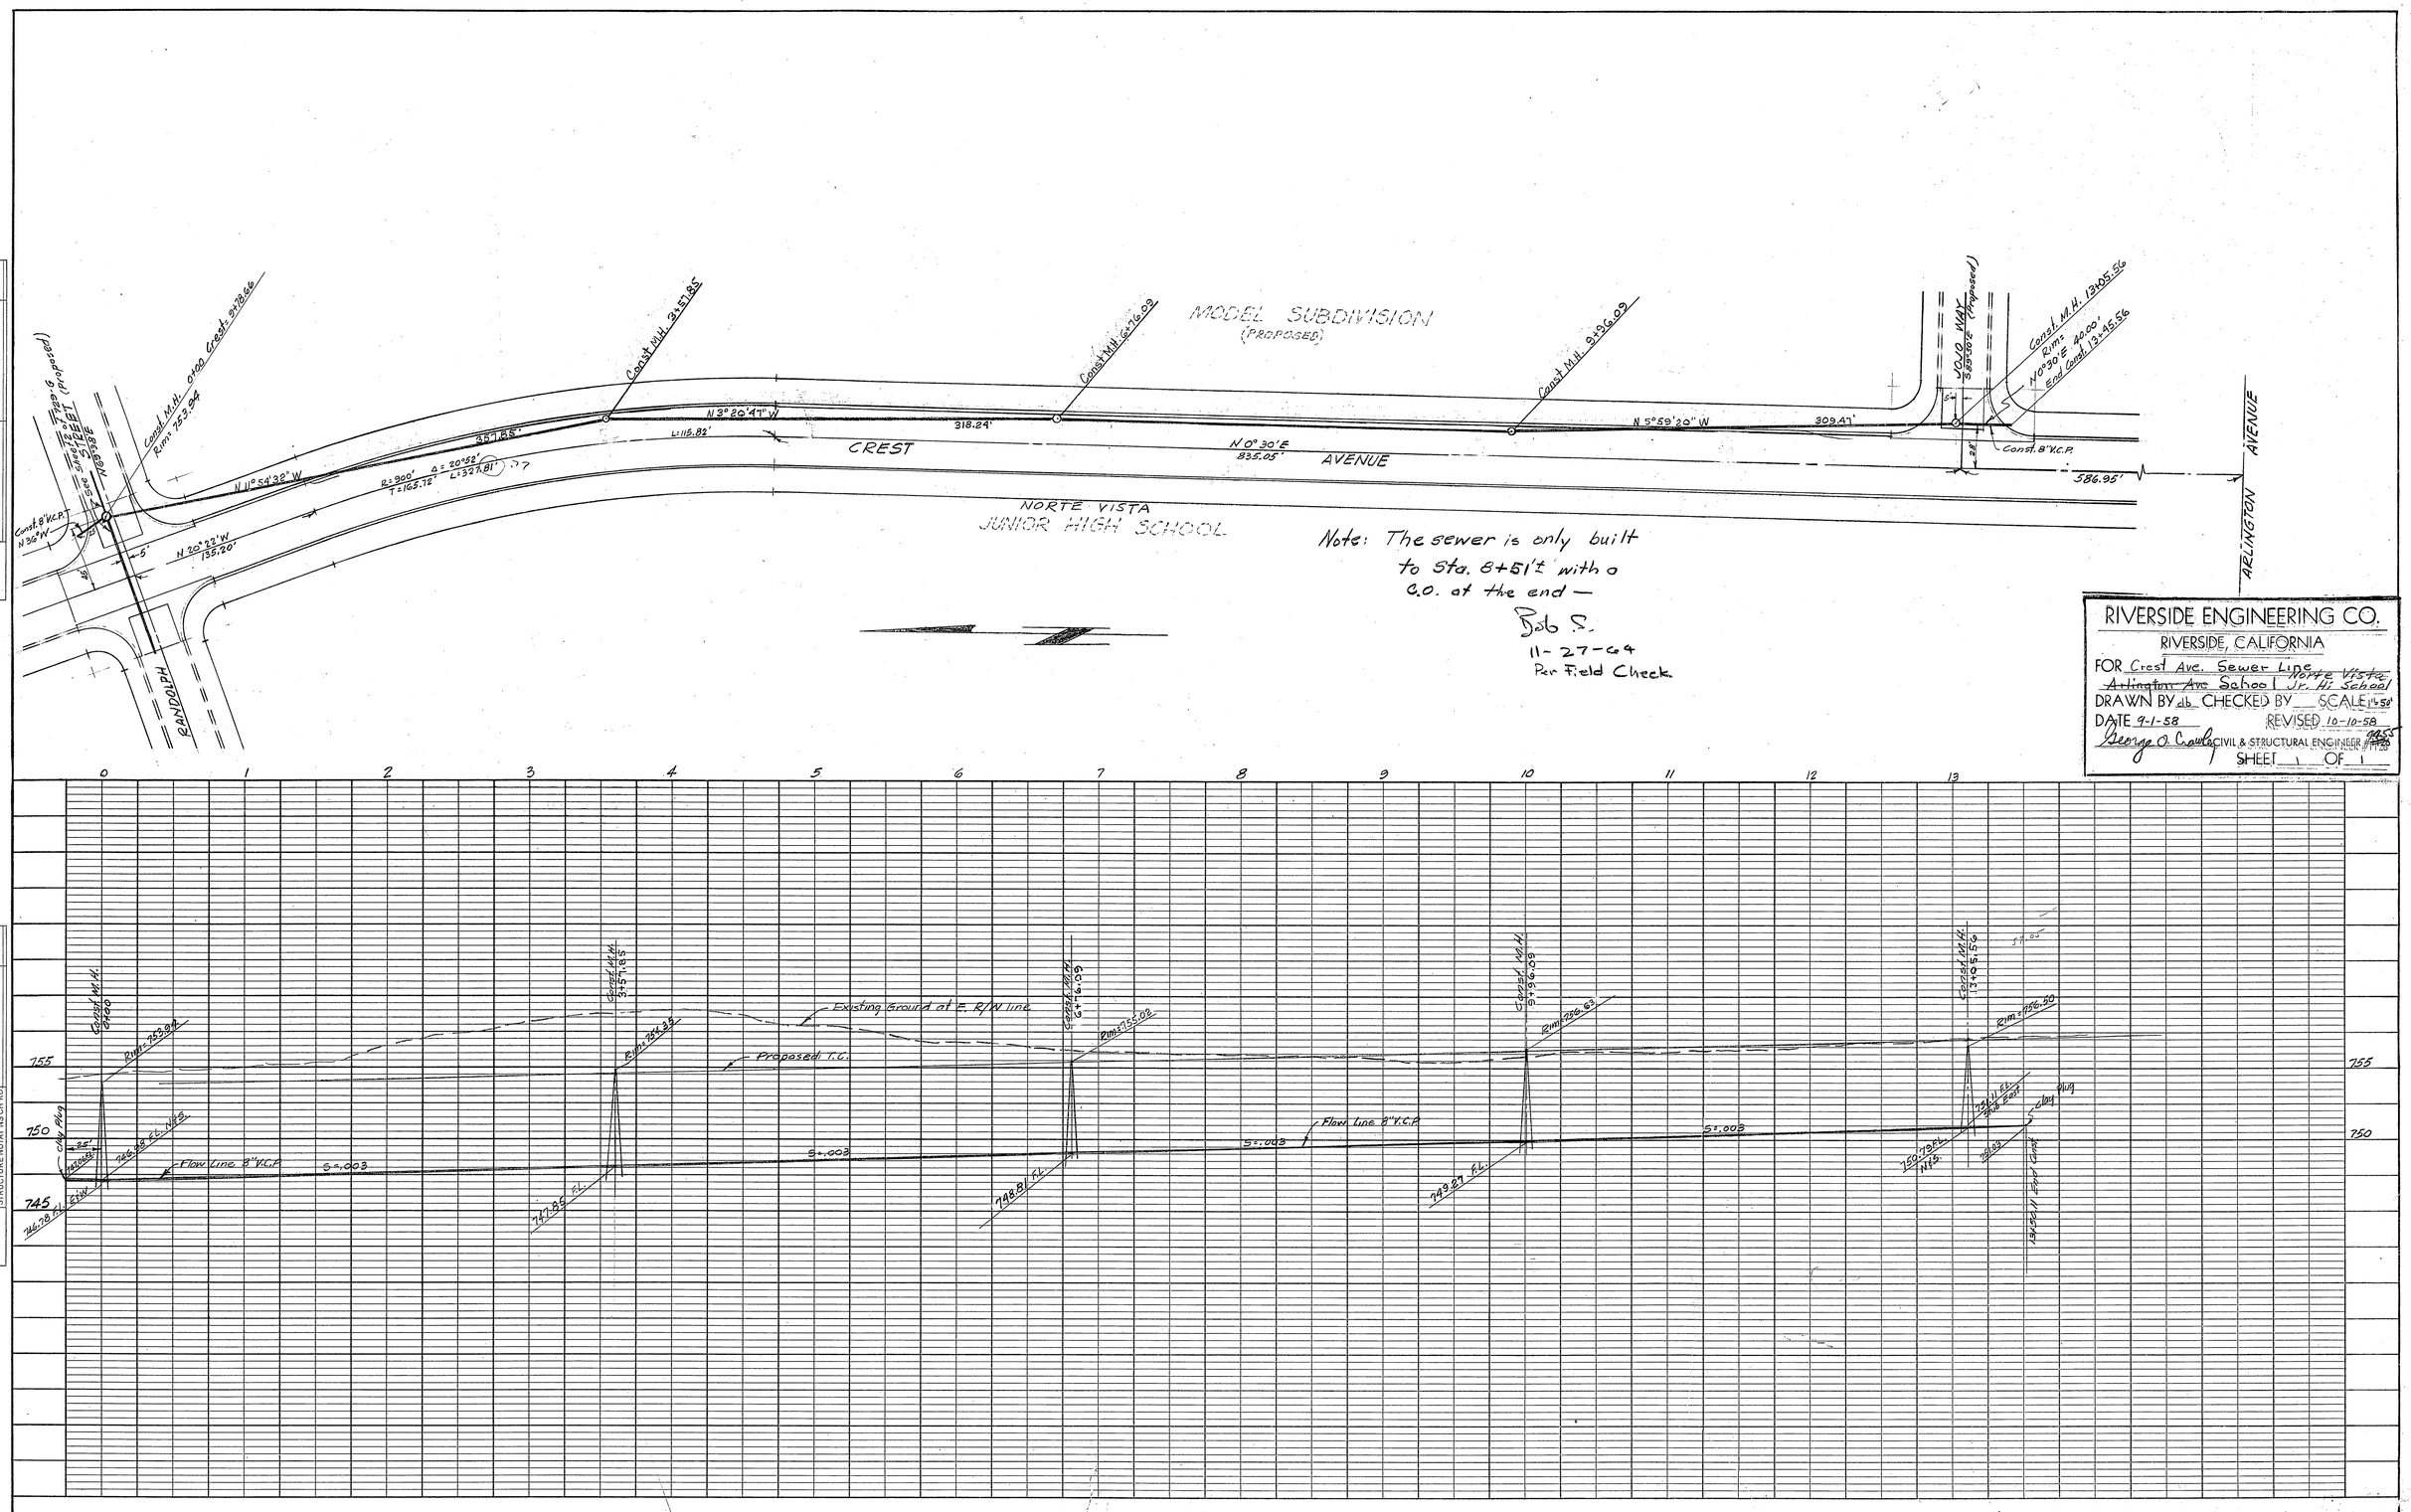

RIVERSIDE ENGINEERING CO.
RIVERSIDE, CALIFORNIA
FOR Crest Ave. Sewer Line ~~Arlington Ave~~ School ~~Norte Vista~~ Jr. Hi School
DRAWN BY db CHECKED BY ___ SCALE 1"=50'
DATE 9-1-58 REVISED 10-10-58
George O. Crawley CIVIL & STRUCTURAL ENGINEER #1755
SHEET 1 OF 1

PLAN
NOTE BOOK NO. ___
SURVEYED
PLOTTED
ALIGNMENT CHECKED
RT. OF WAY CHECKED
BY
DATE

PROFILE
NOTE BOOK NO. ___
SURVEYED
PLOTTED
GRADES CHECKED
B. M.'s NOTED
STRUCTURE NOTAT'NS CH'KD
BY
DATE

PLATE 1 - PLAN - PROFILE O. P. R. & R. E. STANDARD
KEUFFEL & ESSER CO., NEW YORK.

MADE IN U.S.A. 347-1 ON "ALBANENE" NO. 195L TRACING PAPER
REG. U.S. PAT. OFF.
86670

S-323 ~~711-N~~