
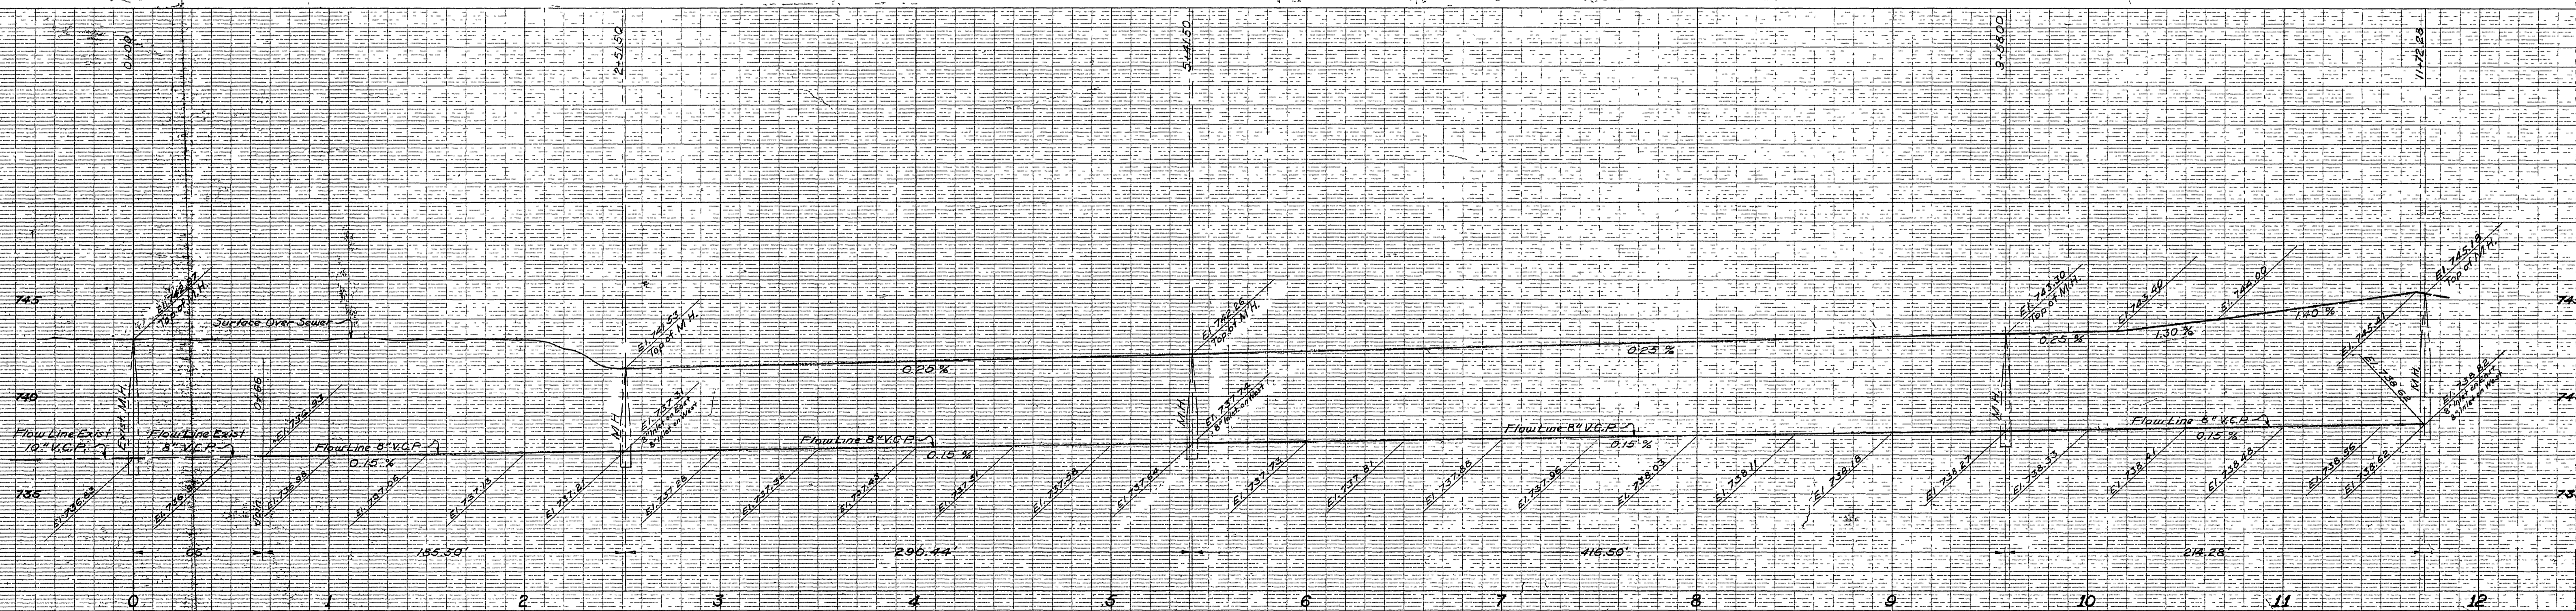


NOTE:
BM East Rim of Manhole
243.5' Westerly of Challen
Avenue and 251.5' Northerly
of Huron Avenue
ELEV. 742.91'

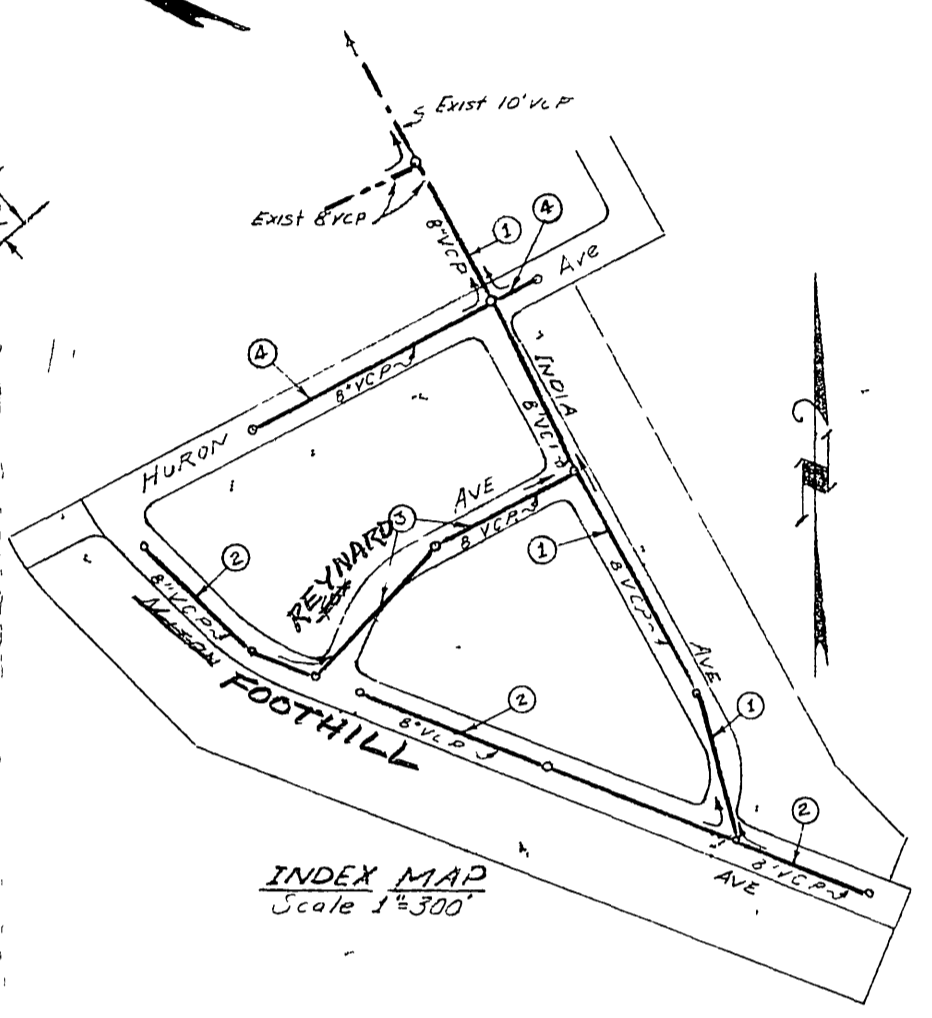


SIERRA FOOT HILLS TRACT
SANITARY SEWERS
INDIA AVENUE


C.V. BROWN JR. AND GORDON STEWART
CIVIL ENGINEERS

DATE _____ SCALE _____ FILE NO. _____
APPROVED _____

EA

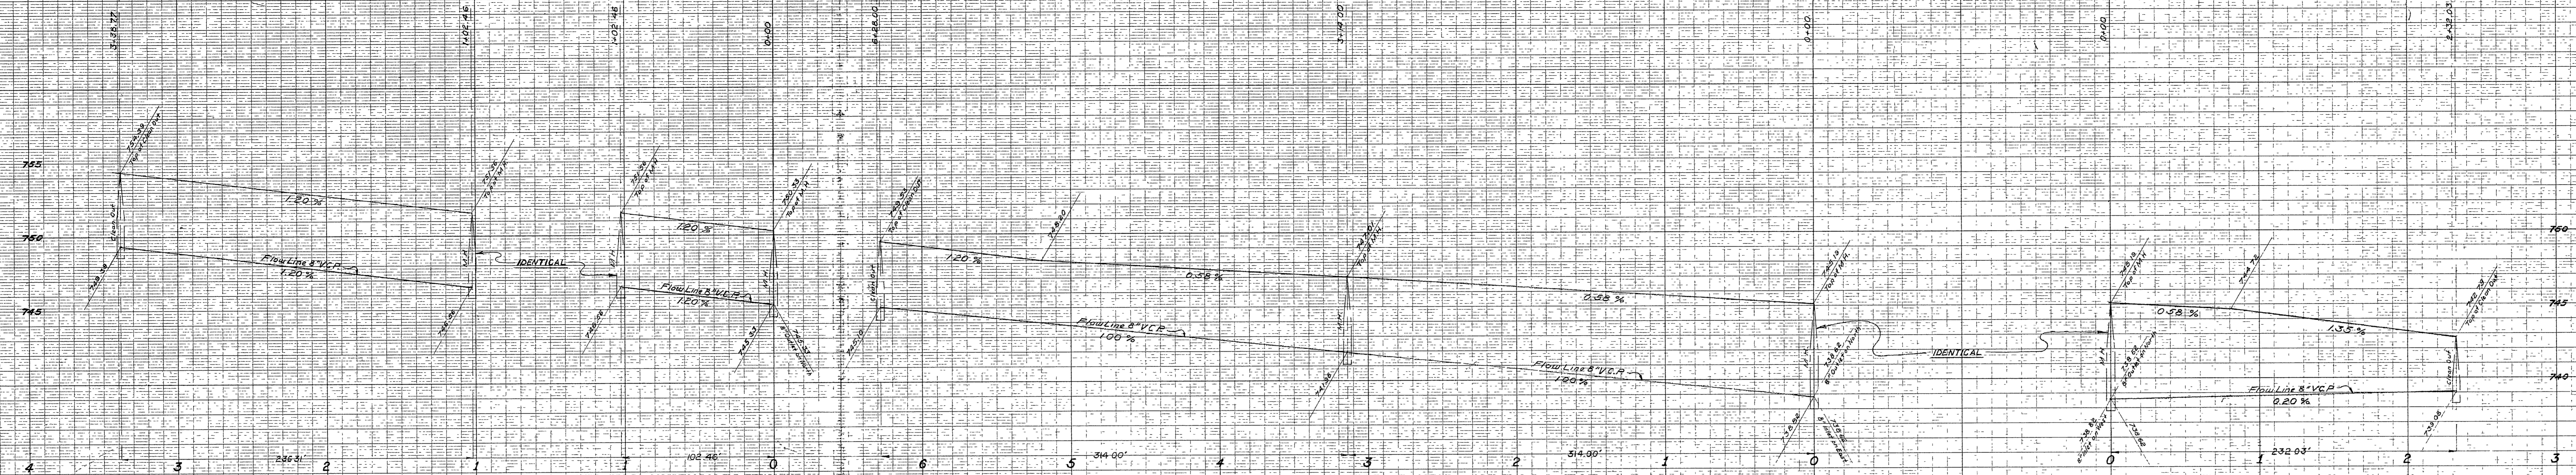



B.M.
East rim of Manhole 243.5
Westerly of Chatham Avenue
and 251.5 Northerly of
Thron Avenue
Elev. 742.97

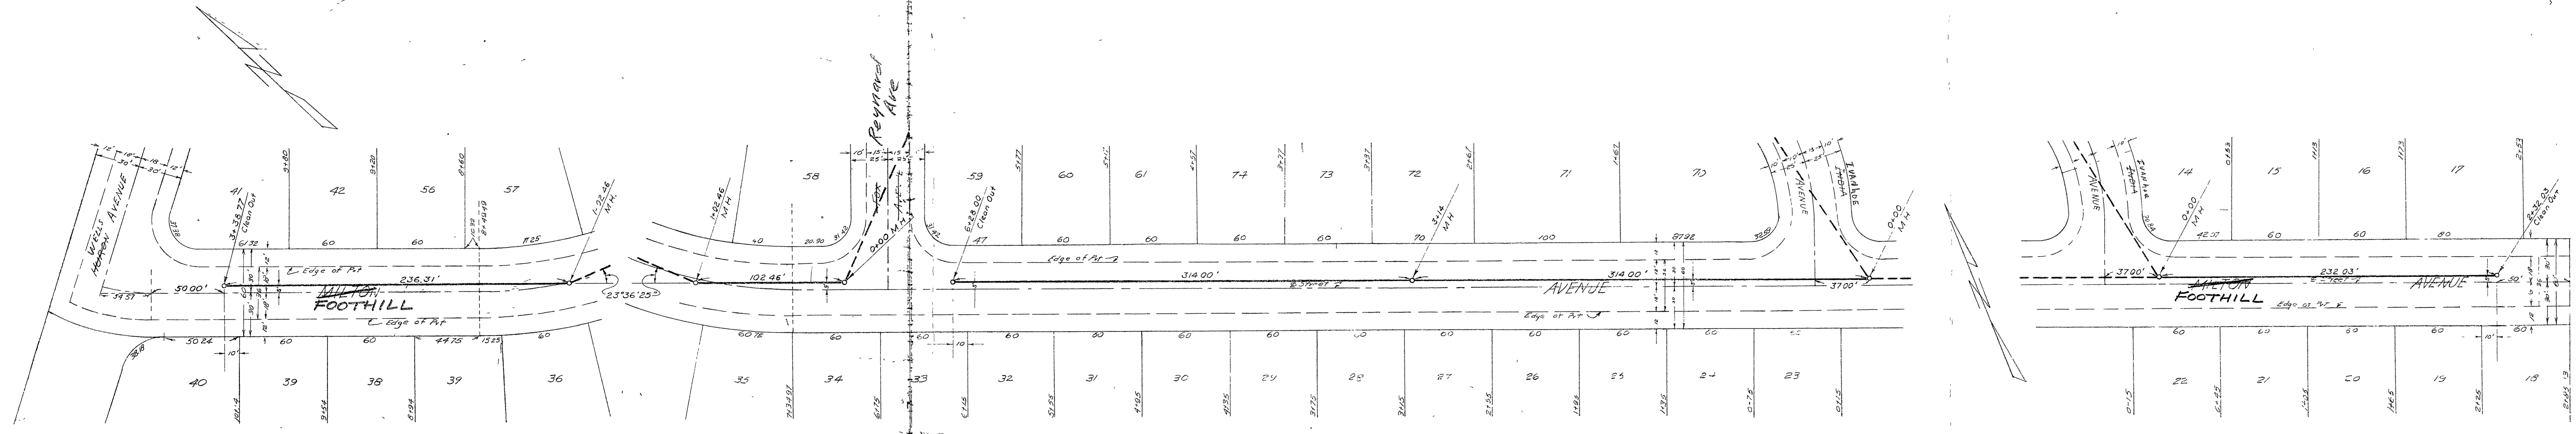

SIERRA FOOT HILLS TRACT
SANITARY SEWERS
FOOTHILL MILK AVENUE
CV. BROWN JR. AND GORDON STEWART
CIVIL ENGINEERS
DATE: _____ APPROVED: _____ SCALE: 1"=40' FILE NO: _____

S-340
Sh. 2

SHEET 3 OF SANITARY SEWERS

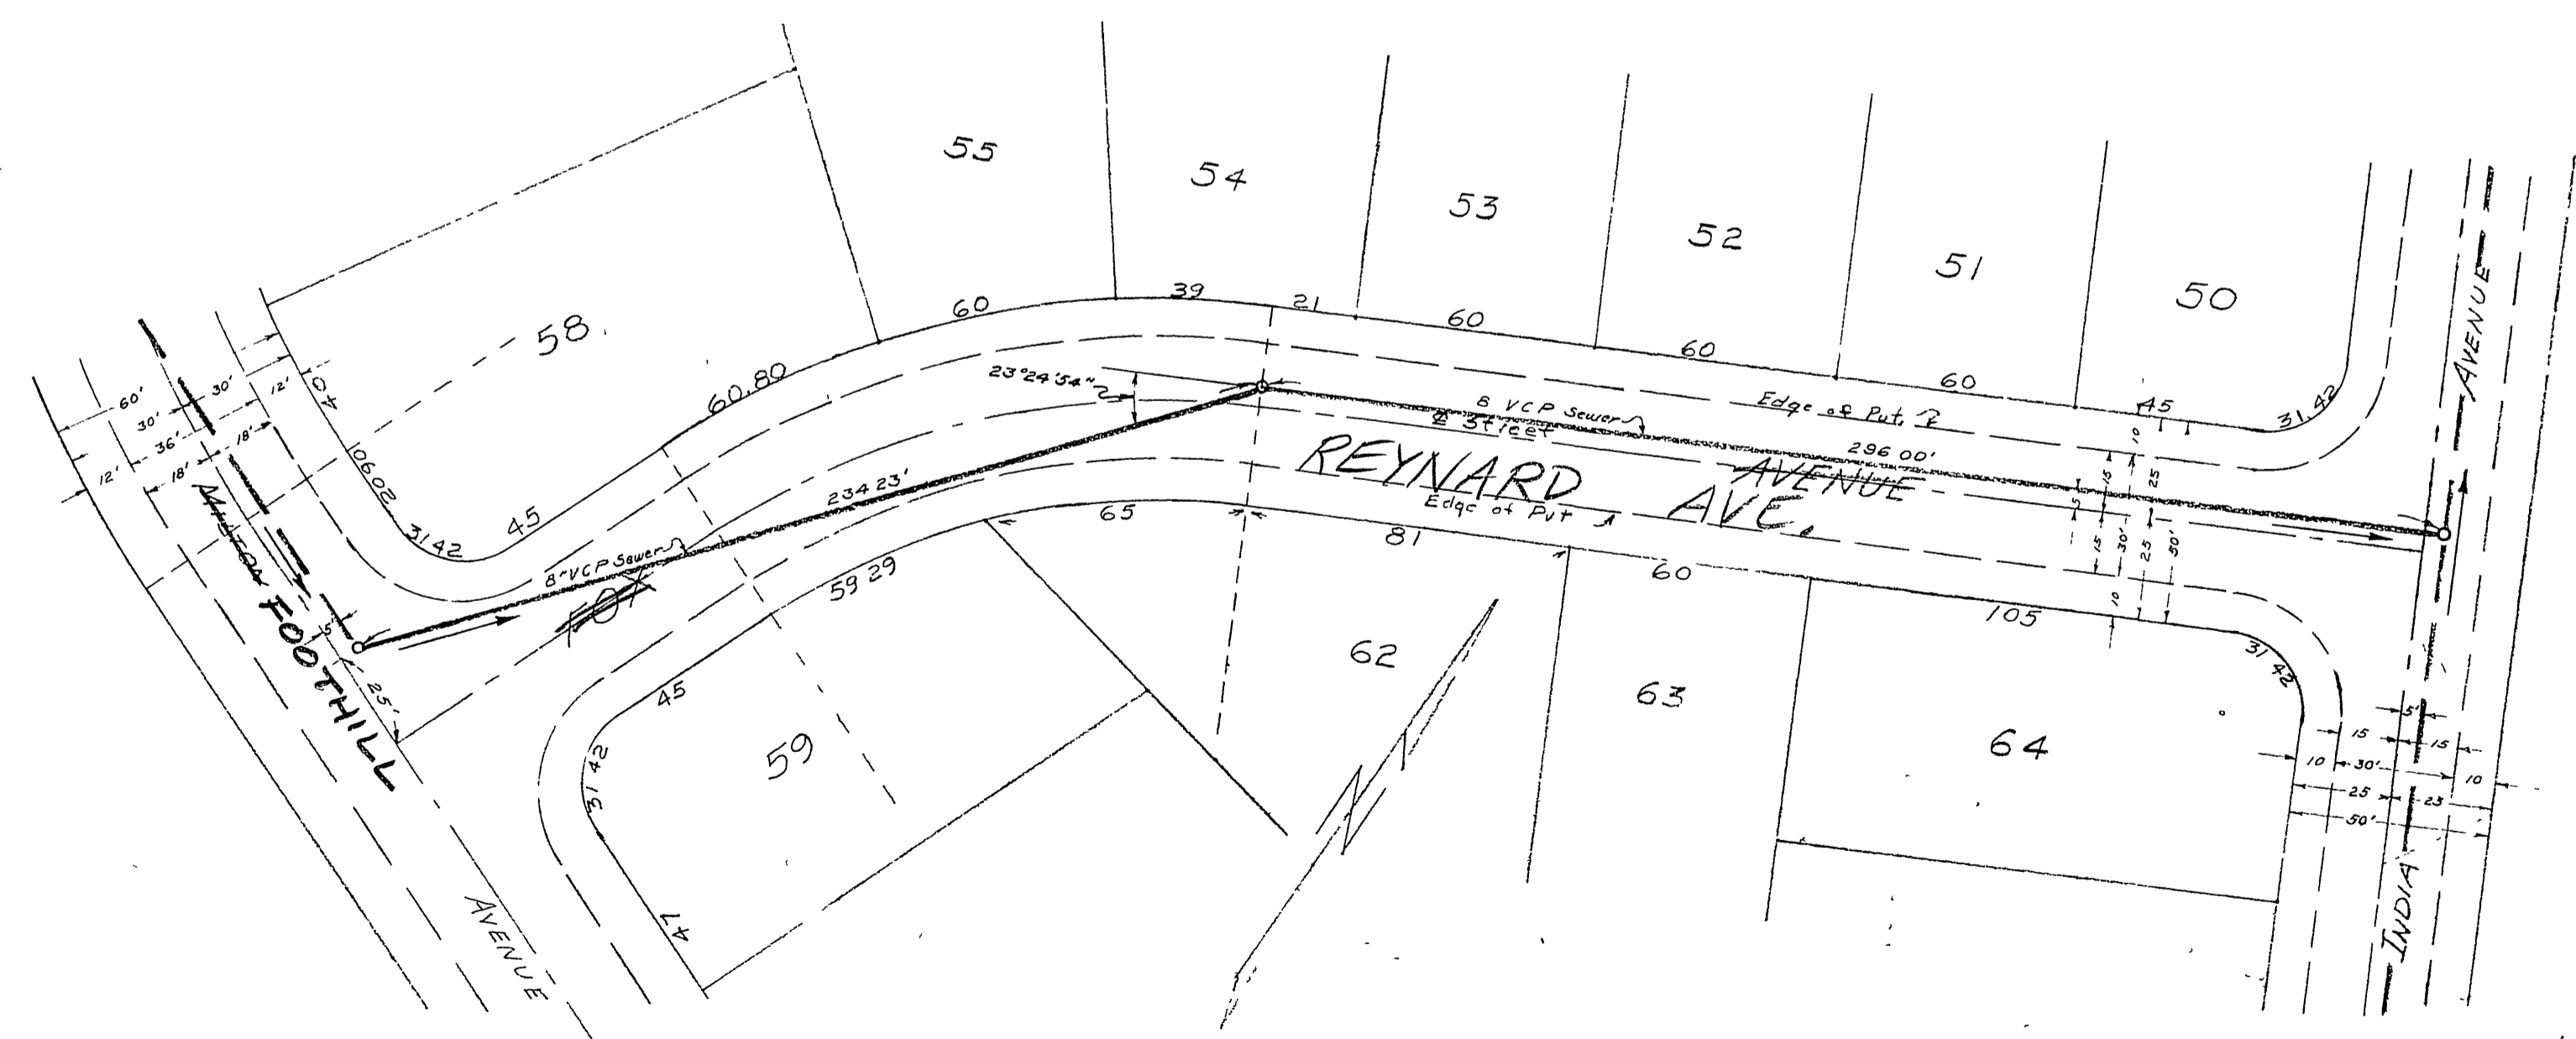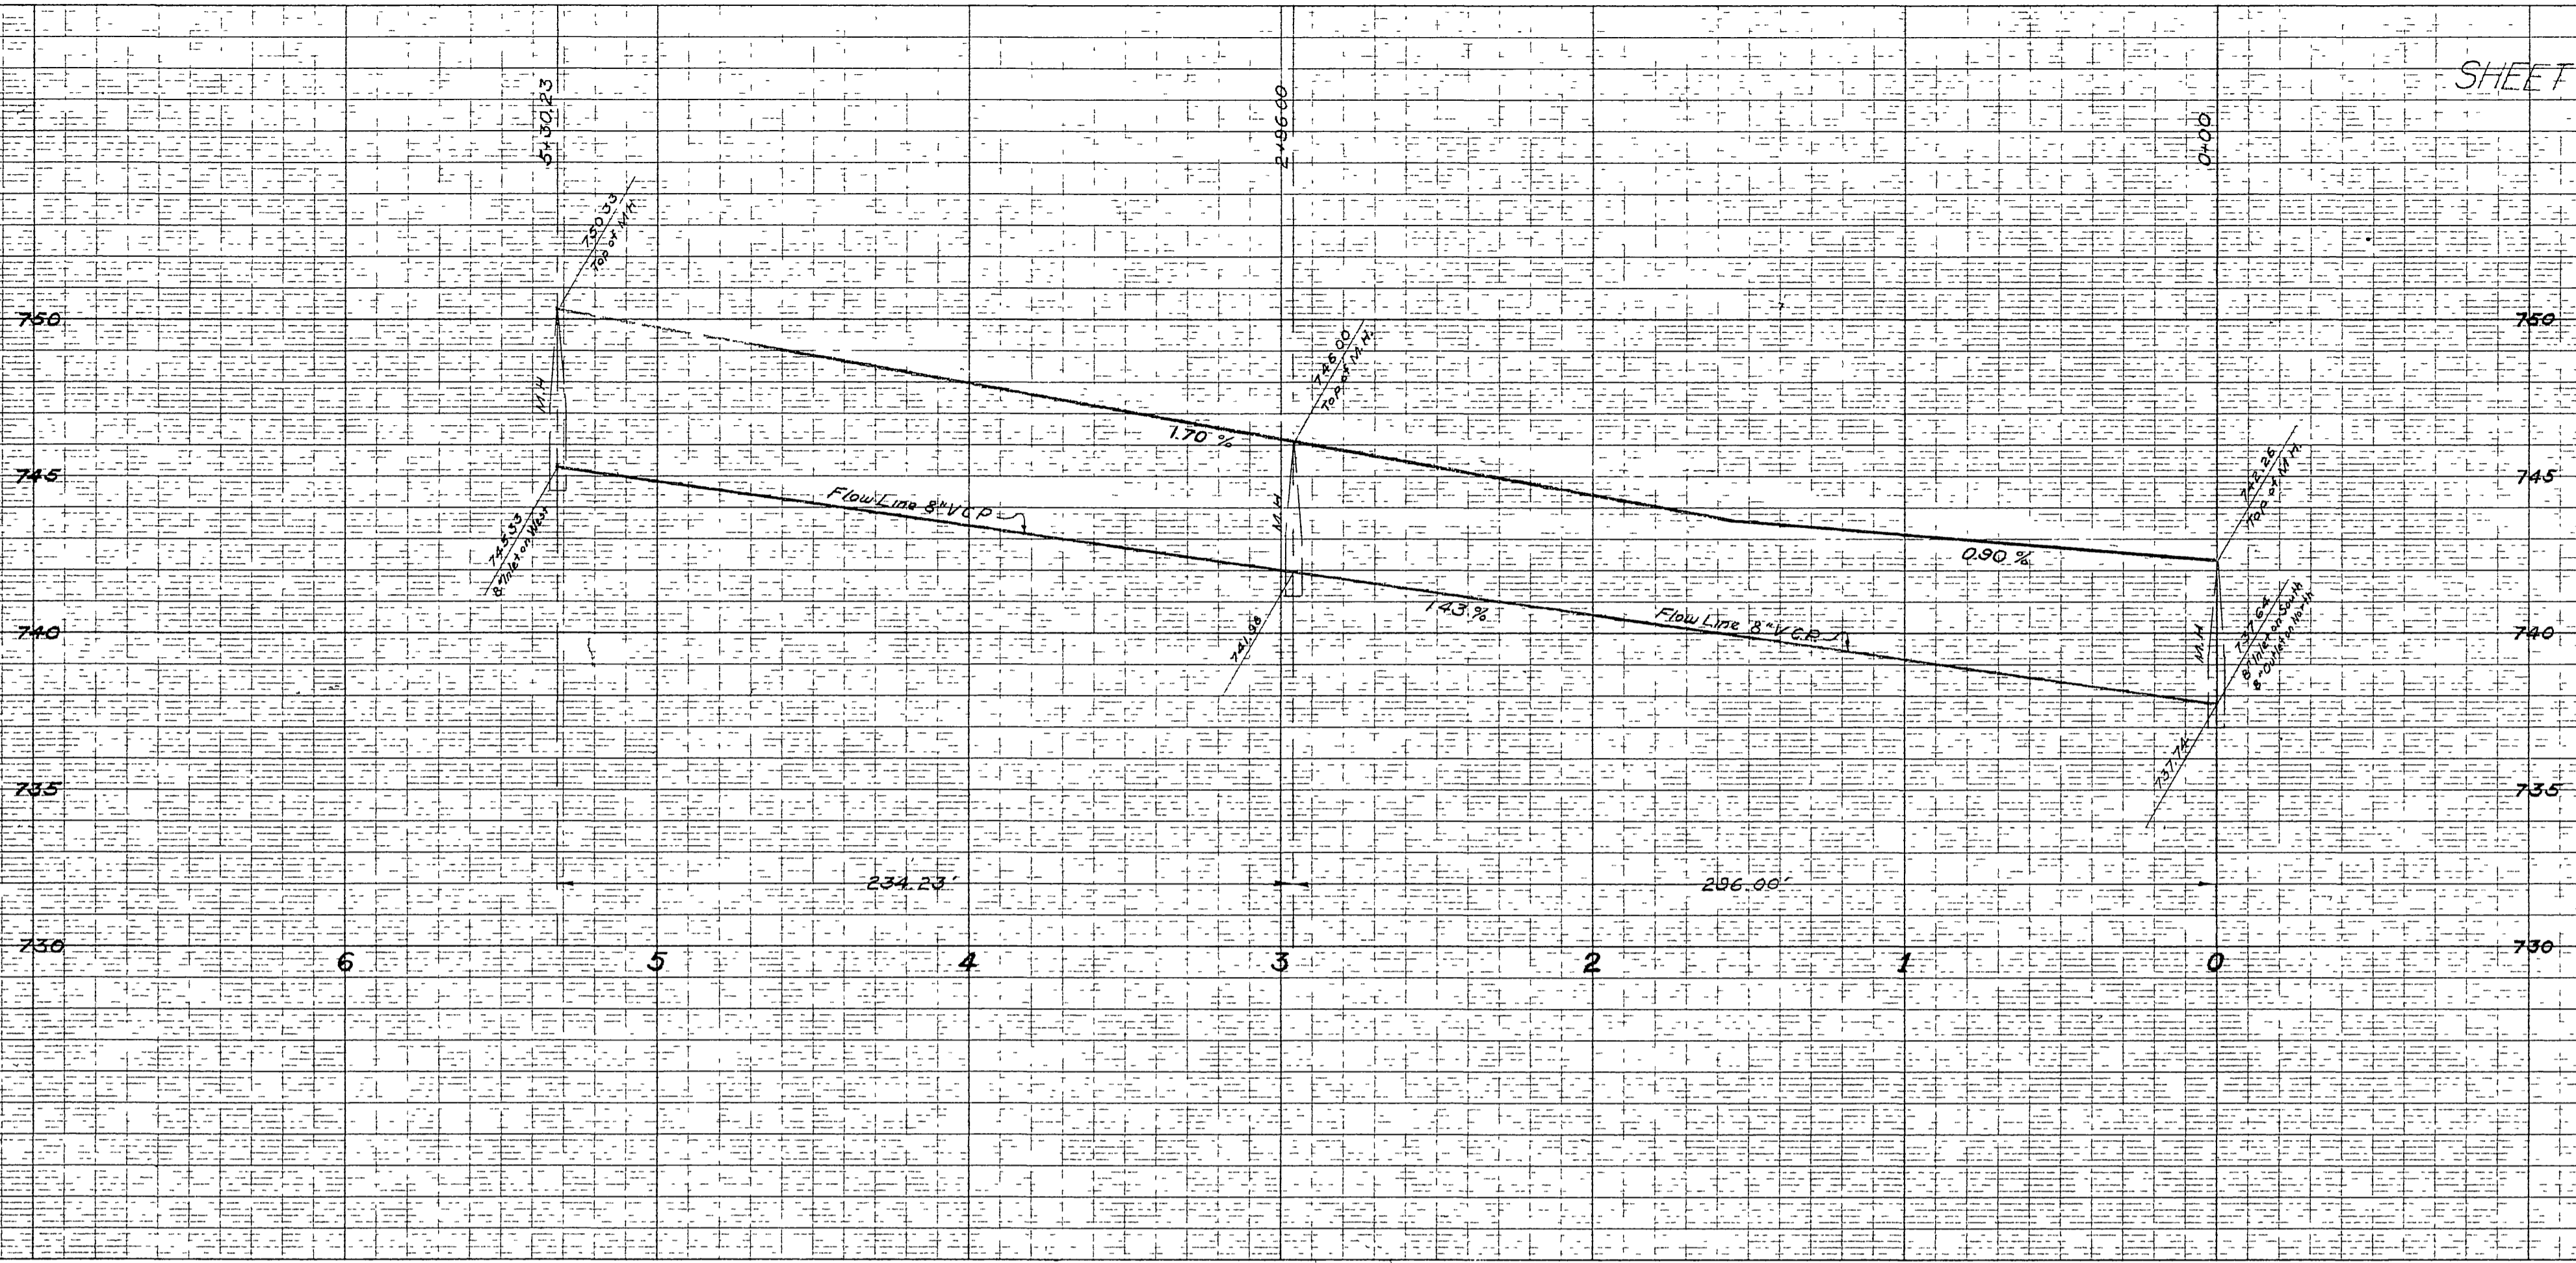



SIERRA FOOT HILLS TRACT
 SANITARY SEWERS
REYNARD FOX AVENUE
 C.V. BROWN JR. AND GORDON STEWART
 CIVIL ENGINEERS

DATE	APPROVED	SCALE 1" = 40'	FILE NO.
------	----------	-------------------	----------

S-340
 Sh. 3 of 4

411-75-3

PERFECT PROFILE
 PLATE A
 EUGENE DETZEN CO
 PRINTED IN U.S.A.
 ON 100% RAG PAPER MADE IN U.S.A.

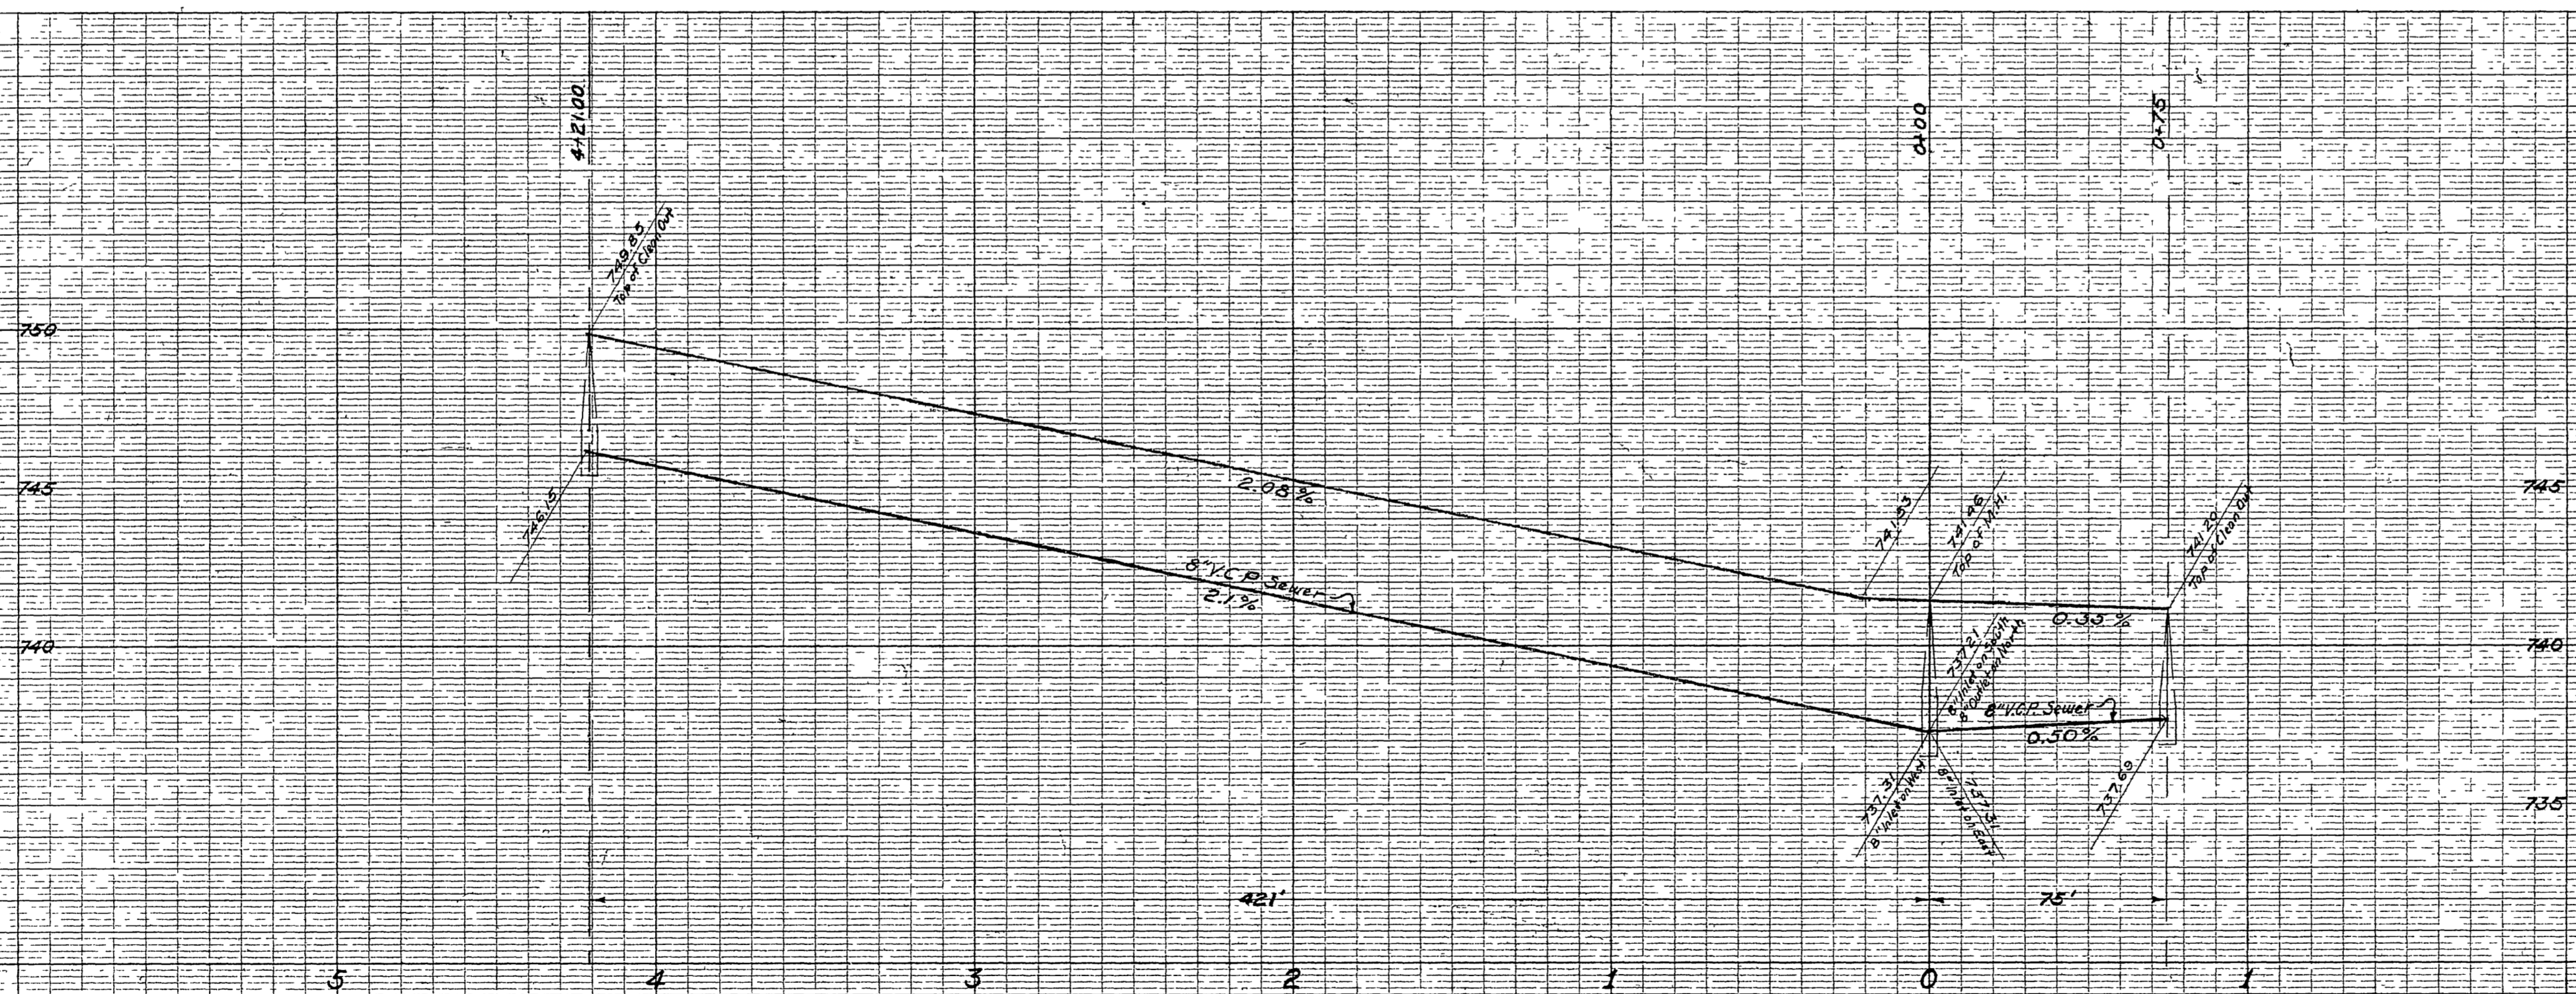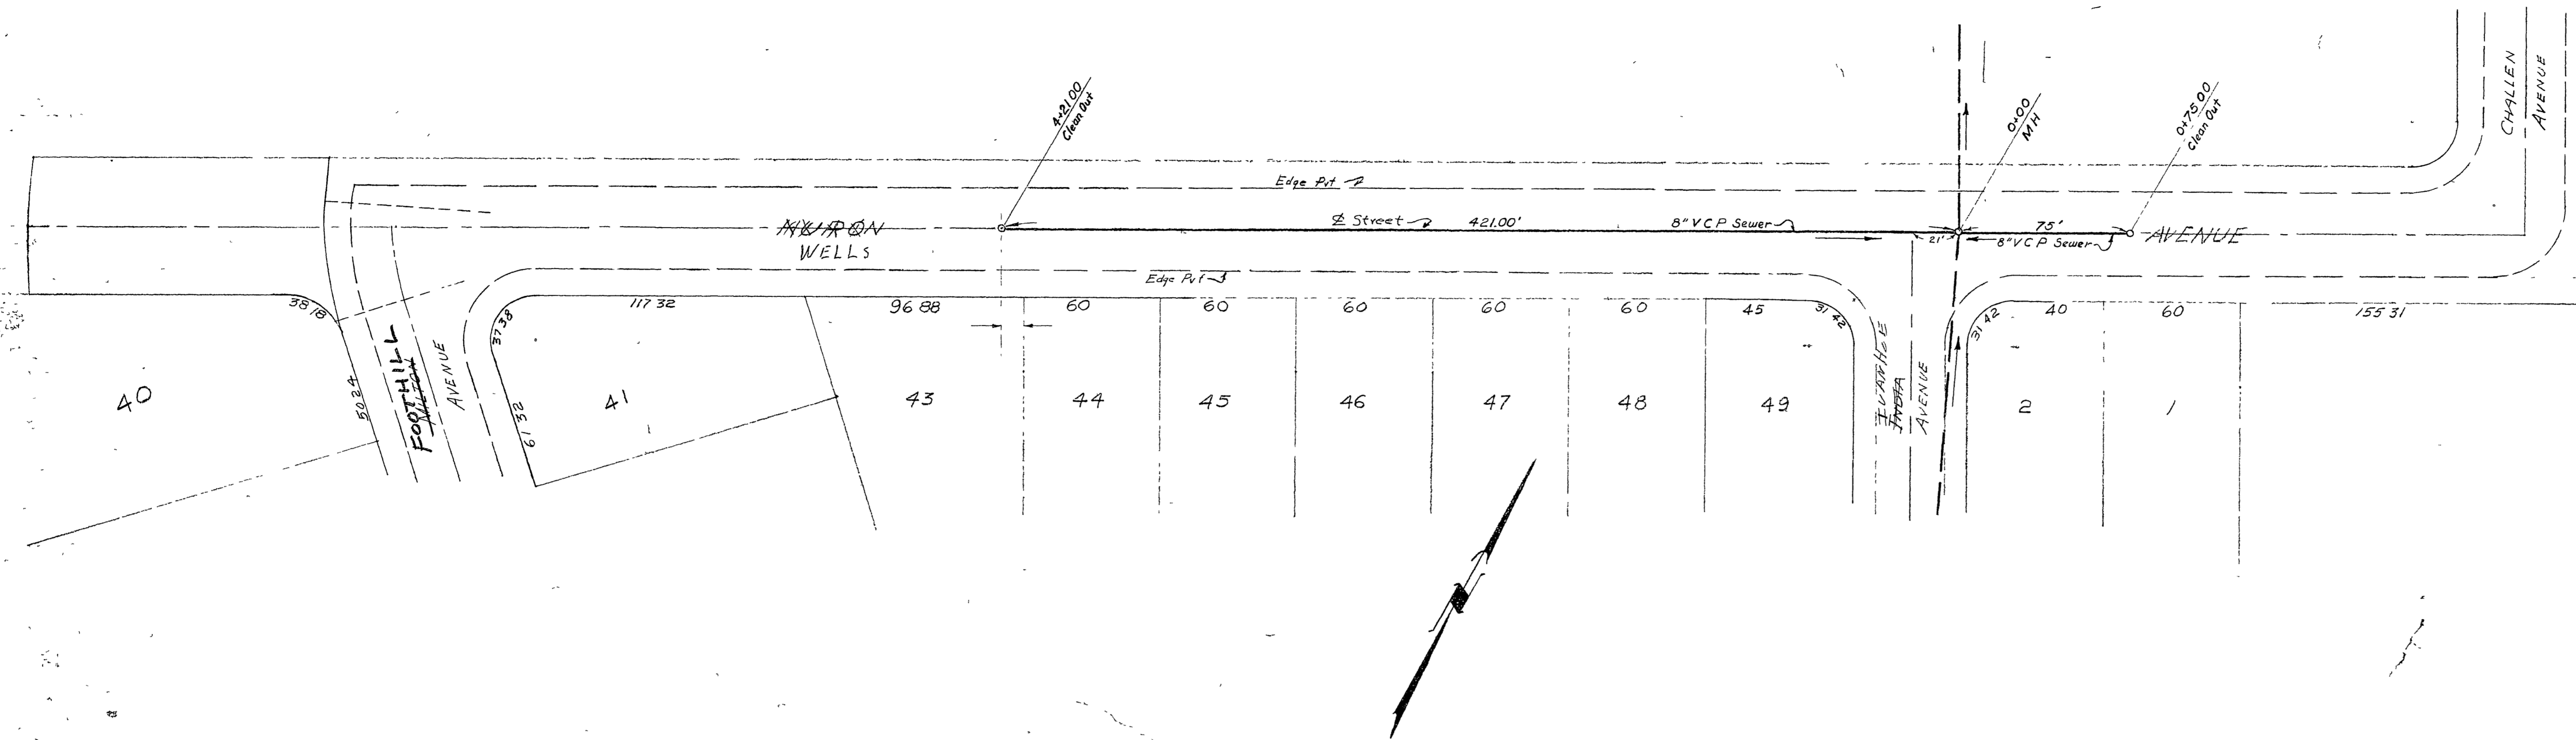

SIERRA FOOTHILL TRACT SANITARY SEWERS HURON AVENUE WELLS			
G.V. BROWN JR.		AND GORDON STEWART	
CIVIL ENGINEERS			
DATE	APPROVED	SCALE 1" = 40'	FILE NO.

S-340
Sh. 4