


| PROFILE | DATE |
|-------------|------|
| NO. | |
| DESIGNED BY | |
| CHECKED BY | |
| APPROVED BY | |

B.M. ELEV. 932.492 - SPIKE & LEAD
IN NW CURB RET. LINCOLN &
MAUDE.
F.B. R-4/ 33-42
SCALE: HOR. 1" = 50'
VERT. 1" = 10'

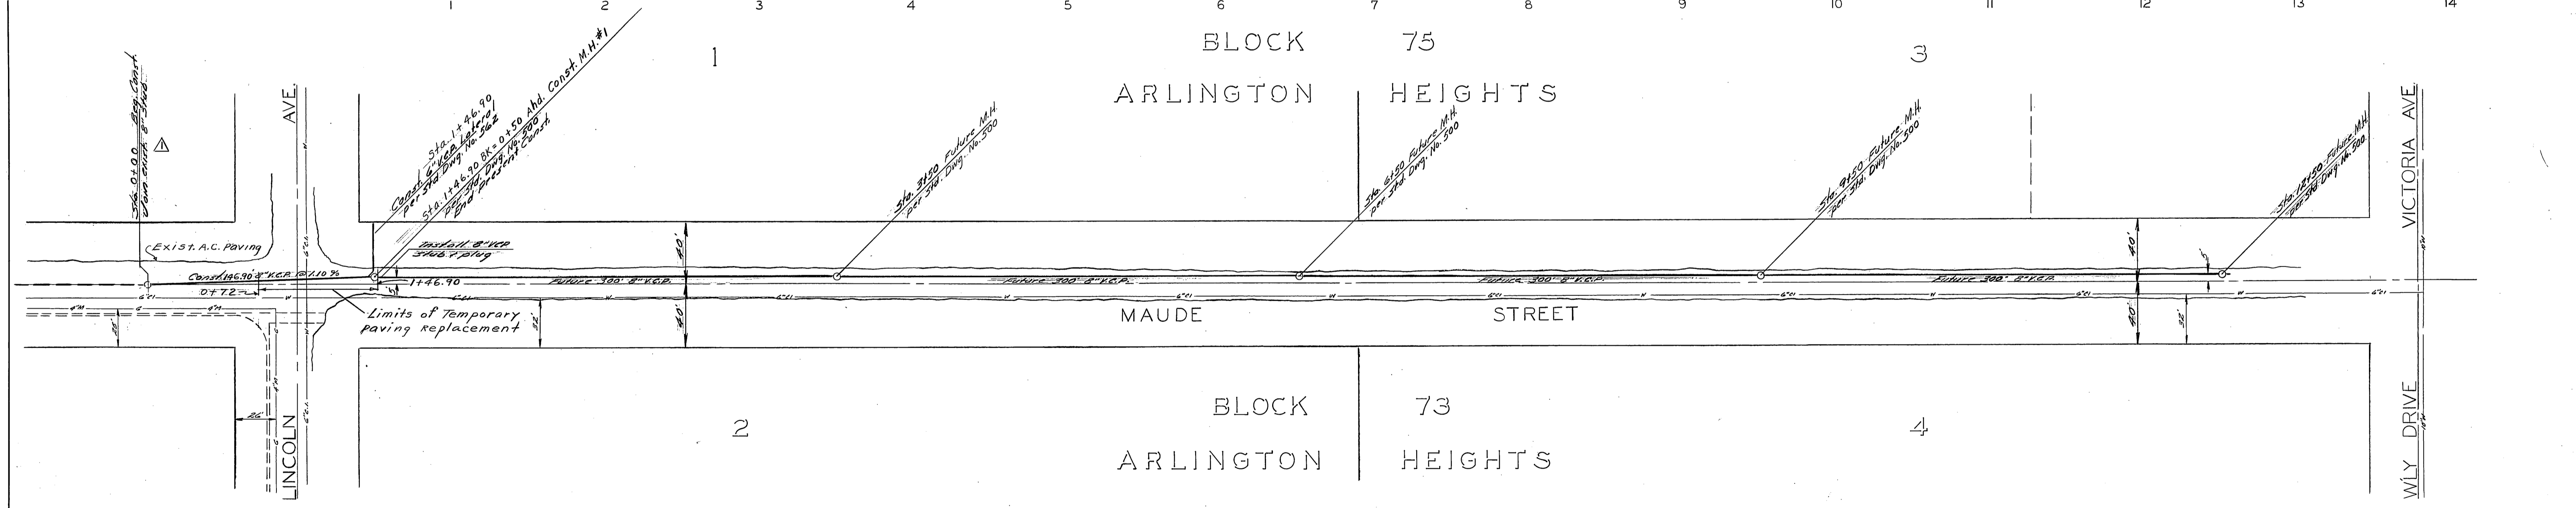


| PLAN | DATE |
|-------------|------|
| NO. | |
| DESIGNED BY | |
| CHECKED BY | |
| APPROVED BY | |

QUANTITIES

| | |
|-------------------------|----------|
| 8" V.C.P. | 147 L.F. |
| 6" V.C.P. | 35 L.F. |
| M.H. Per Std. Dwg. #500 | 1 ea. |
| 8" x 6" WYE | 1 ea. |
| Base Replacement | 6 C.Y. |
| Paving Replacement | 4.5 Ton |

- NOTES:**
- Contractor shall verify exist 8" stub elev. at sta. 0+00 prior to construction.
 - The Contractor shall comply with all applicable portions of Standard Specifications No. 461, including the requirements for insurance and bonds (1-16 and 1-17)
 - Pipe shall be bedded per Std. Dwg. No. 452 case II
 - The Contractor will be allowed 15 calendar days, after notice to begin is given by the City Engineer, to complete this project.
 - Liquidated damages shall be in the amount of 25.00 per day.
 - The intersection of Lincoln Ave. & Maude St. shall be open to traffic at all times.
 - Pavement Replacement Sta. 0+72 to 1+46.90 shall be 1" A.C. with no base material, all other shall be 2 1/2" A.C. over 9" I.B.M.

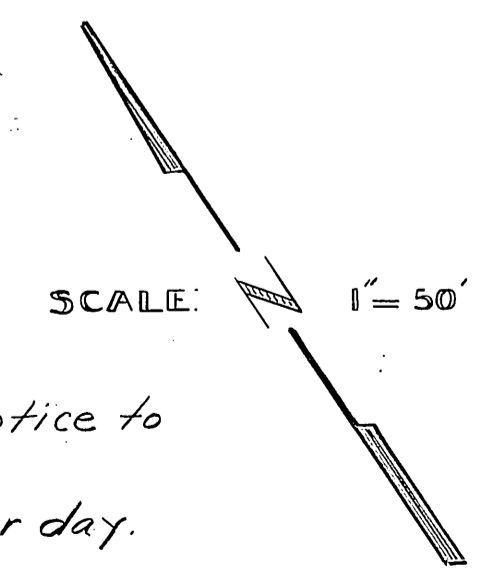

SCALE: 1" = 50'

ACCT. No. 3045

| REVISIONS | | | CITY OF RIVERSIDE CALIFORNIA DEPARTMENT OF PUBLIC WORKS |
|-------------|-------------------------|--|--|
| MARK | DATE | DESCRIPTION | |
| Δ | 6/21/62 | Revised per field location of exist. M.H. & wdg. DWG | MAUDE ST SEWER LINCOLN TO VICTORIA |
| DESIGNED BY | CHECKED BY | APPROVED BY | |
| DRAWN BY | RECOMMENDED BY | DIRECTOR OF PUBLIC WORKS | S-351 |
| APPROVED BY | ASSISTANT CITY ENGINEER | DATE | SHEET 1 OF 1 |