

ASSESSMENT NO. 435

MELODY LANE SANITARY SEWER DISTRICT


H. M. ROBERTSON

2/14/57

A SANITARY SEWER & APPURTENANCES IN  
MELODY LANE, GARFIELD ST. & SHELBY DR, BET. SHELBY DR. & MAGNOLIA AVE.

CIRCLES

MELODY LANE GARDENS UNIT NO. 1 M.B. 24/73 REC. RIV. CO

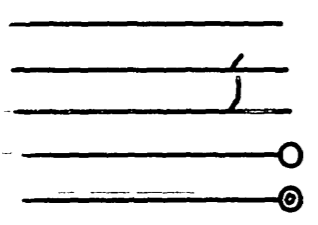

SEWER MAIN

- .. .. & WYE BRANCH
- .. .. & HO. CONN. LATERAL
- .. .. & MANHOLE
- .. .. & CLEANOUT

H. M. ROBERTSON

FEBRUARY 14, 57  
7553

12 TH DECEMBER 56

1,705.70 LIN. FT. 8" V.C.P. SEWER  
 31 EA. 8" X 4" WYE BRANCHES  
 1,050.00 LIN. FT. 4" V.C.P. HO. CONN. LATERAL  
 7 EA. MANHOLES STD. 141-D  
 1 EA. CLEANOUT STD. 141-B

15TH APRIL 1957

26TH 4:30 P.  
JUNE 57

# DIAGRAM

## EXHIBITING

IN THE CITY OF RIVERSIDE ON WHICH WORK HAS BEEN DONE UNDER THE OFFICIAL CONTRACT OF THE SUPERINTENDENT OF STREETS OF SAID CITY WITH DATED FOR THE CONSTRUCTION OF

AS IS MORE PARTICULARLY DESCRIBED IN SAID CONTRACT TO WHICH REFERENCE IS HEREBY MADE FOR FURTHER PARTICULARS; SAID DIAGRAM ALSO SHOWS THE RELATIVE LOCATION OF EACH LOT PORTION OF LOT PIECE OR PARCEL OF LAND ASSESSED FOR THE WORK DONE NUMBERED IN TO CORRESPOND TO THE RED INK NUMBERS IN THE ASSESSMENT

HEREIN FIGURES NEXT TO PROPERTY LINES SHOW LENGTH OF SAID LINES IN FEET. THE MARK (') MEANS FEET. PROPERTY LINES THAT DIFFER FROM THE RECORDED SUBDIVISIONS ARE SHOWN BY BROKEN LINES. THE DISTRICT BENEFITED IS BOUNDED BY A HEAVY DASHED LINE

PROPERTY COVERED BY THIS ASSESSMENT IS SHOWN ON THE FOLLOWING RECORDED MAPS:

HEREIN THE LEGEND OF THE DIFFERENT KINDS OF WORK PERFORMED IS SHOWN AS FOLLOWS:

CITY ENGINEER OF THE CITY OF RIVERSIDE  
THE FOLLOWING IS A STATEMENT OF AMOUNTS OF DIFFERENT KINDS OF WORK DONE BY UNDER CONTRACT DATED 19 PURSUANT TO RESOLUTION OF INTENTION NO. ADOPTED BY THE CITY COUNCIL OF THE CITY OF RIVERSIDE ON THE DAY OF 19

AT SAID CITY OF RIVERSIDE THIS DAY OF

STREET SUPERINTENDENT OF THE CITY OF RIVERSIDE

I HEREBY CERTIFY THAT THE ABOVE WORK WAS DONE IN ACCORDANCE WITH LINES AND GRADES FURNISHED BY ME AND THAT THE DIAGRAM OF THE ASSESSMENT DISTRICT FOR THE SAME IS CORRECT

CITY ENGINEER OF THE CITY OF RIVERSIDE

RECORDED AT O'CLOCK M THIS DAY OF 19

SUPERINTENDENT OF STREETS OF THE CITY OF RIVERSIDE