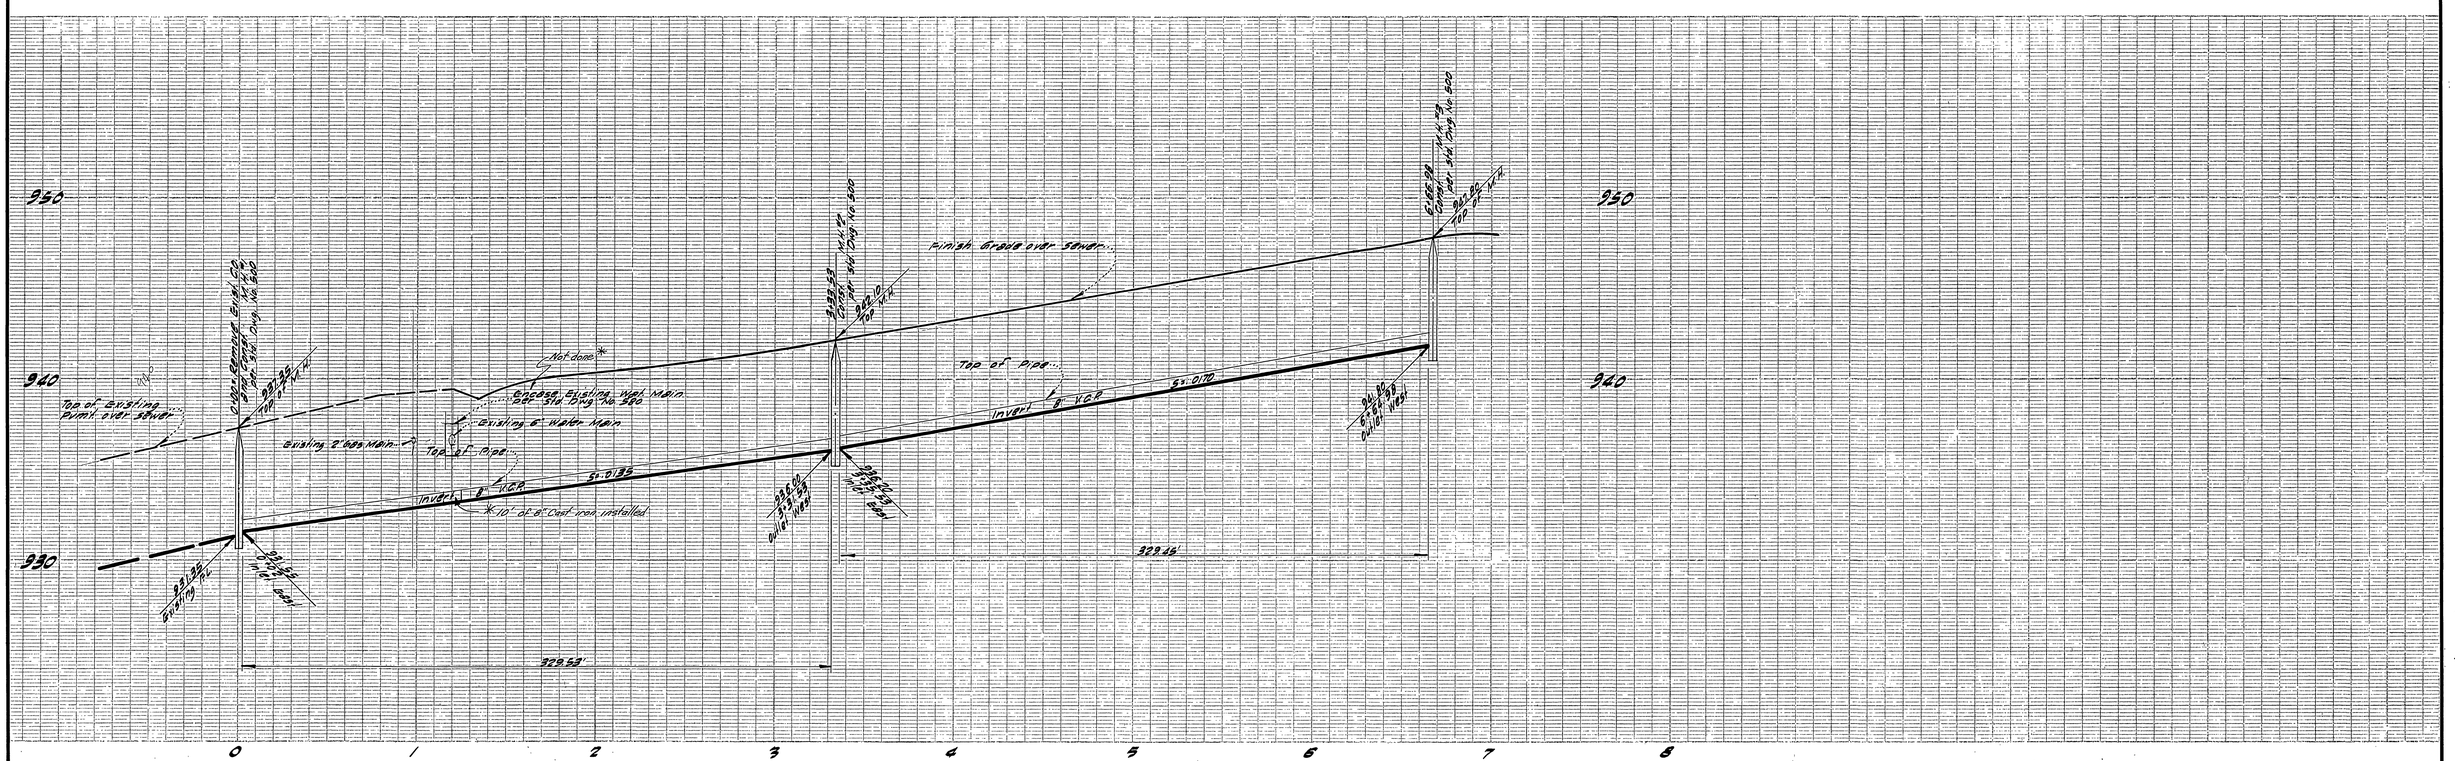
950
940
930
Top of Existing Plant over Sewer
Existing 2" Egg Main
Existing 6" Water Main
Top of Pipe
Invert 8" VCP
S=0.0132
10' of 8" Cast Iron installed
Not done
Finish Grade over Sewer
S=0.0170
Invert 8" VCP
Top of Pipe
Top of M.H.
