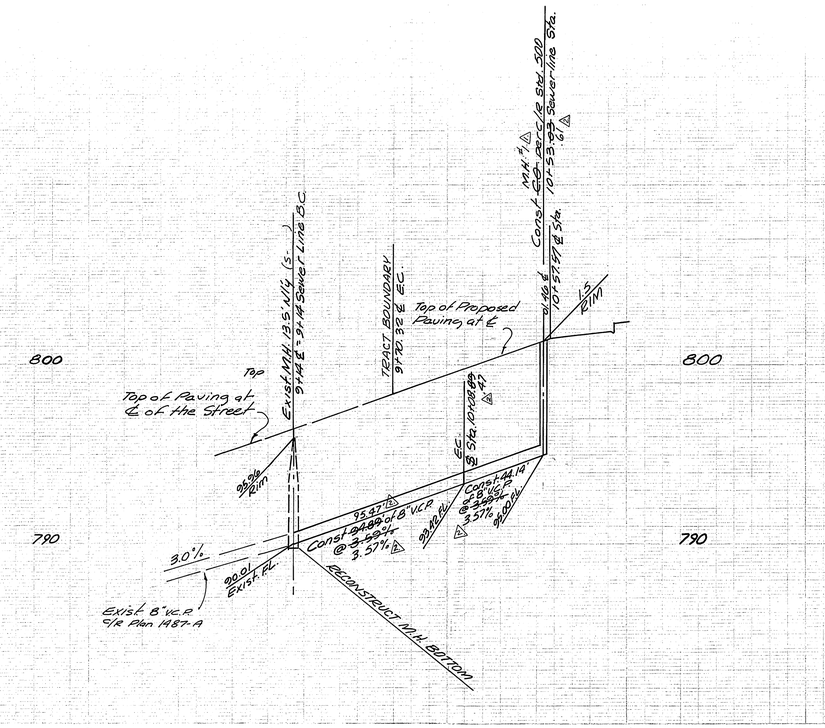

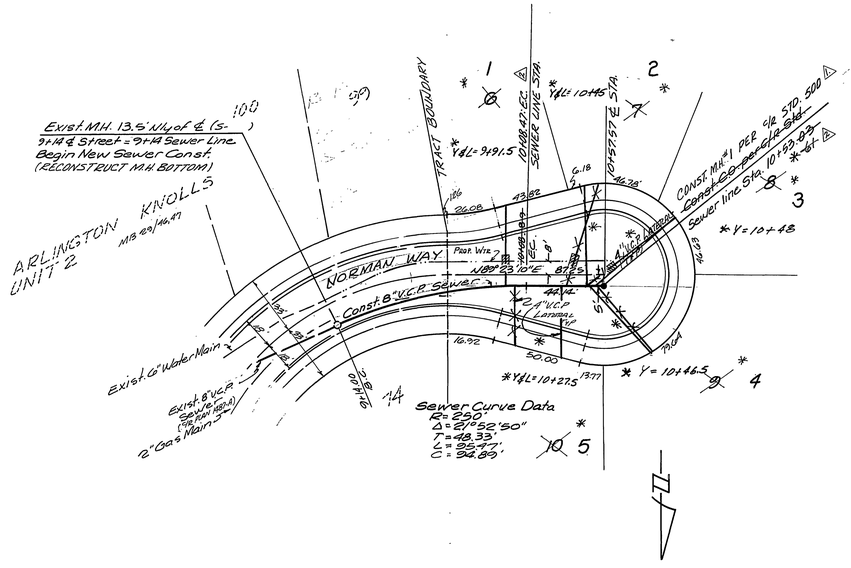
8
9
10
11
Exist. MH. 13.5' N/ly of ℄ (S-) 9+14 ℄ 9+14 Sewer Line ℄
Begin New Sewer Const. (RECONSTRUCT MH BOTTOM)
ARLINGTON KNOLLS UNIT 2
MB 29/146-47
TRACT BOUNDARY
Const. MH #1 per ℄/R STD. 500 Const. ℄ Sewer Line Sta. 10+57.97 ℄ Sta.
NORMAN WAY
Const. 8" V.C.P. SEWER
Post. Wire ℄
N89°23'10"E 87.25'
Exist. 6" Water Main
Exist. 8" V.C.P Sewer (per Plan 1487-A)
2" Gas Main
2" U.C.P Laterals
Sewer Curve Data
R = 250.
