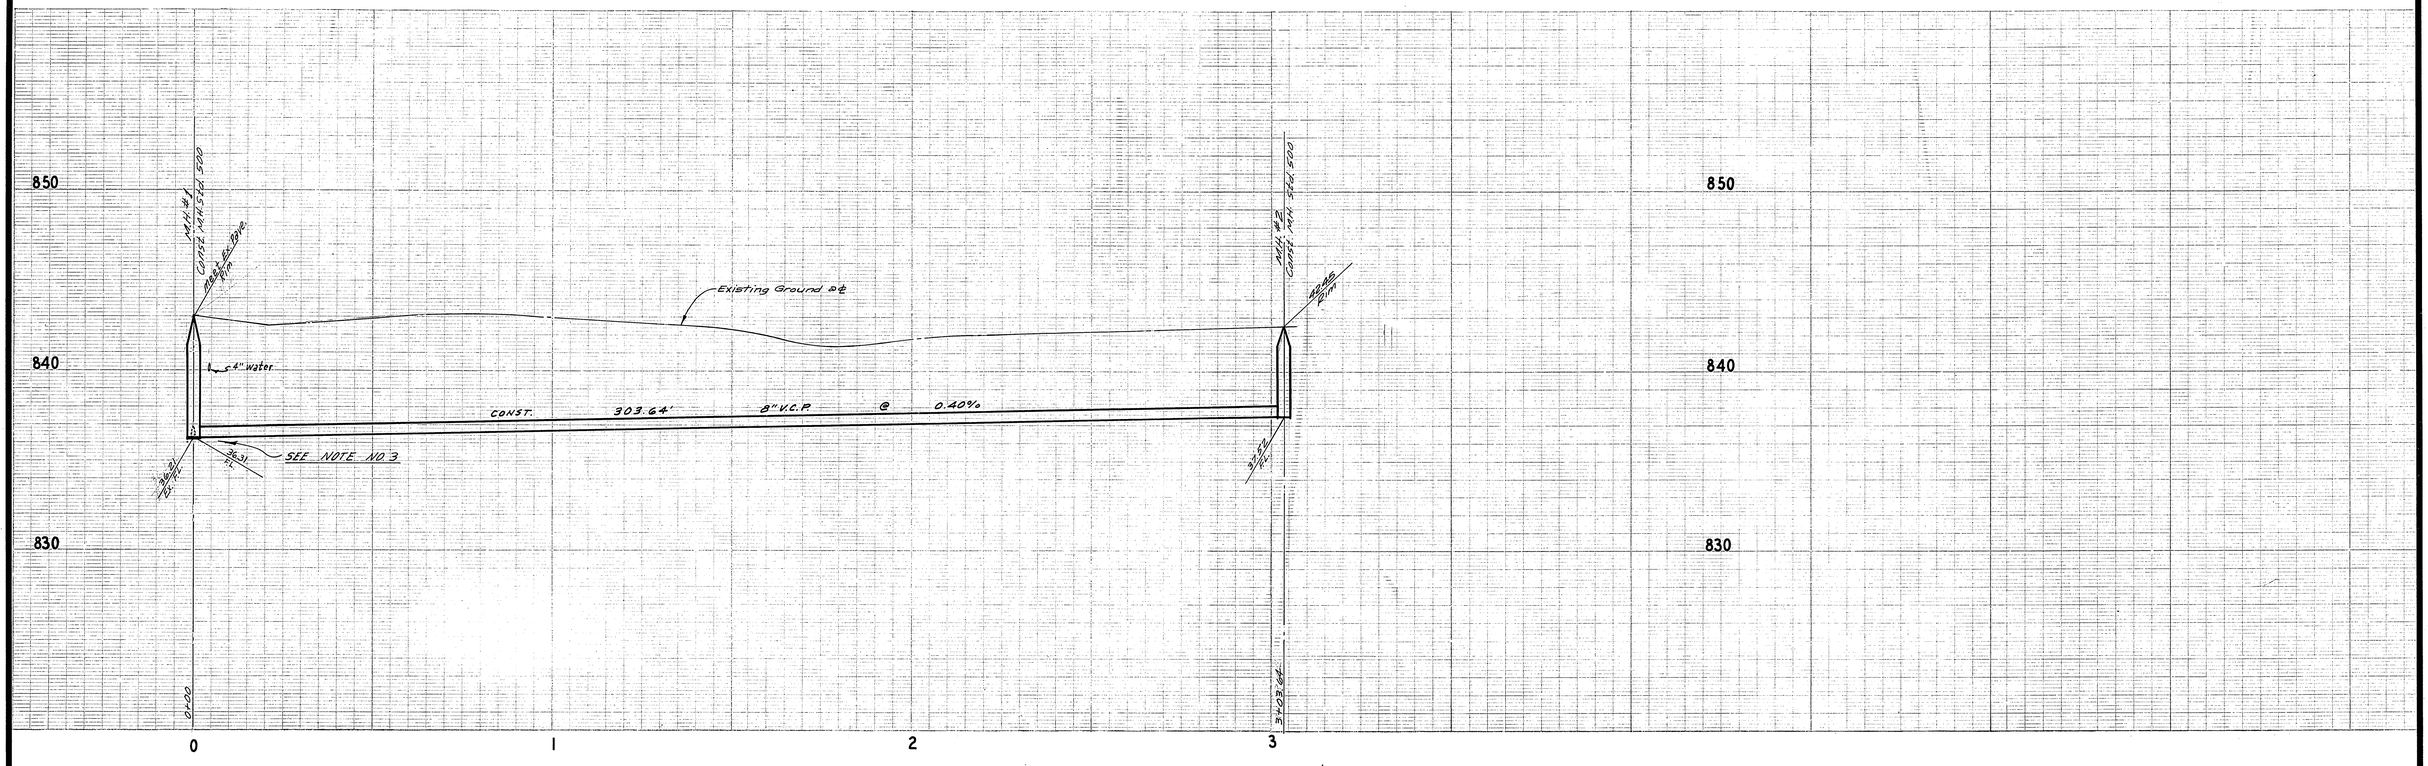

GENERAL NOTES

1. Construction shall be in accordance with the Standard Specifications for Public Works Construction, 1970 Edition, and City of Riverside Standard Drawings.
2. Location of wyes and laterals to be determined at the direction of the owner.
3. Prior to construction of sewer, contractor is to expose existing sewer and contact Engineer for verification of existing elevations.
4. 4" V.C.P. Laterals to Property Line.

BENCH MARK

S/L in curb @ N.W. corner Marietta & Orchard
C/S F.B. 438/60 Elev. = 842.17

APPROVED
General Superintendent & Chief Engineer-Water
DATE 4-20-73

ALBERT A. WEBB ASSOCIATES
CIVIL ENGINEERS
RIVERSIDE, CALIFORNIA
APPROVED BY Ernest N. Webb DATE 11/16/72
R.E. No. 9876
W.O. 72-368 FOR: Tavaglione Const. Consultant's F.B. 560'

MARK	REVISIONS	APPR.	DATE
★	"AS BUILT"	EAB	6-73
⚠	ADDED C.I. PIPE AT WATER LINE CROSSINGS, LOTS 6,7 & 8	[illegible]	4-23-73

DESIGNED BY P.E.C. DRAWN BY W.J.K. CHECKED BY [illegible]

CITY OF RIVERSIDE, CALIFORNIA
PUBLIC WORKS DEPARTMENT

APPROVED BY	BY	DATE
PRINCIPAL ENGINEER	[illegible]	4/13/73
PARK DEPARTMENT	—	—
TRAFFIC DIVISION	—	—
CHIEF PUB. WKS. ENGR.	[illegible]	

APPROVED BY William D. Gardner
DIRECTOR OF PUBLIC WORKS
DATE 4/13/73

TRACT NO. 4889
SEWER PLAN AND PROFILE
ORCHARD STREET

SCALE: HORIZ: 1"=20' ; VERT: 1"=4'

ACCOUNT No. 72-368
DRAWING NUMBER
S-923
SHEET 1 OF 1
72-368-B