



Scale:
Horizontal 1"=40'
Vertical 1"=4'

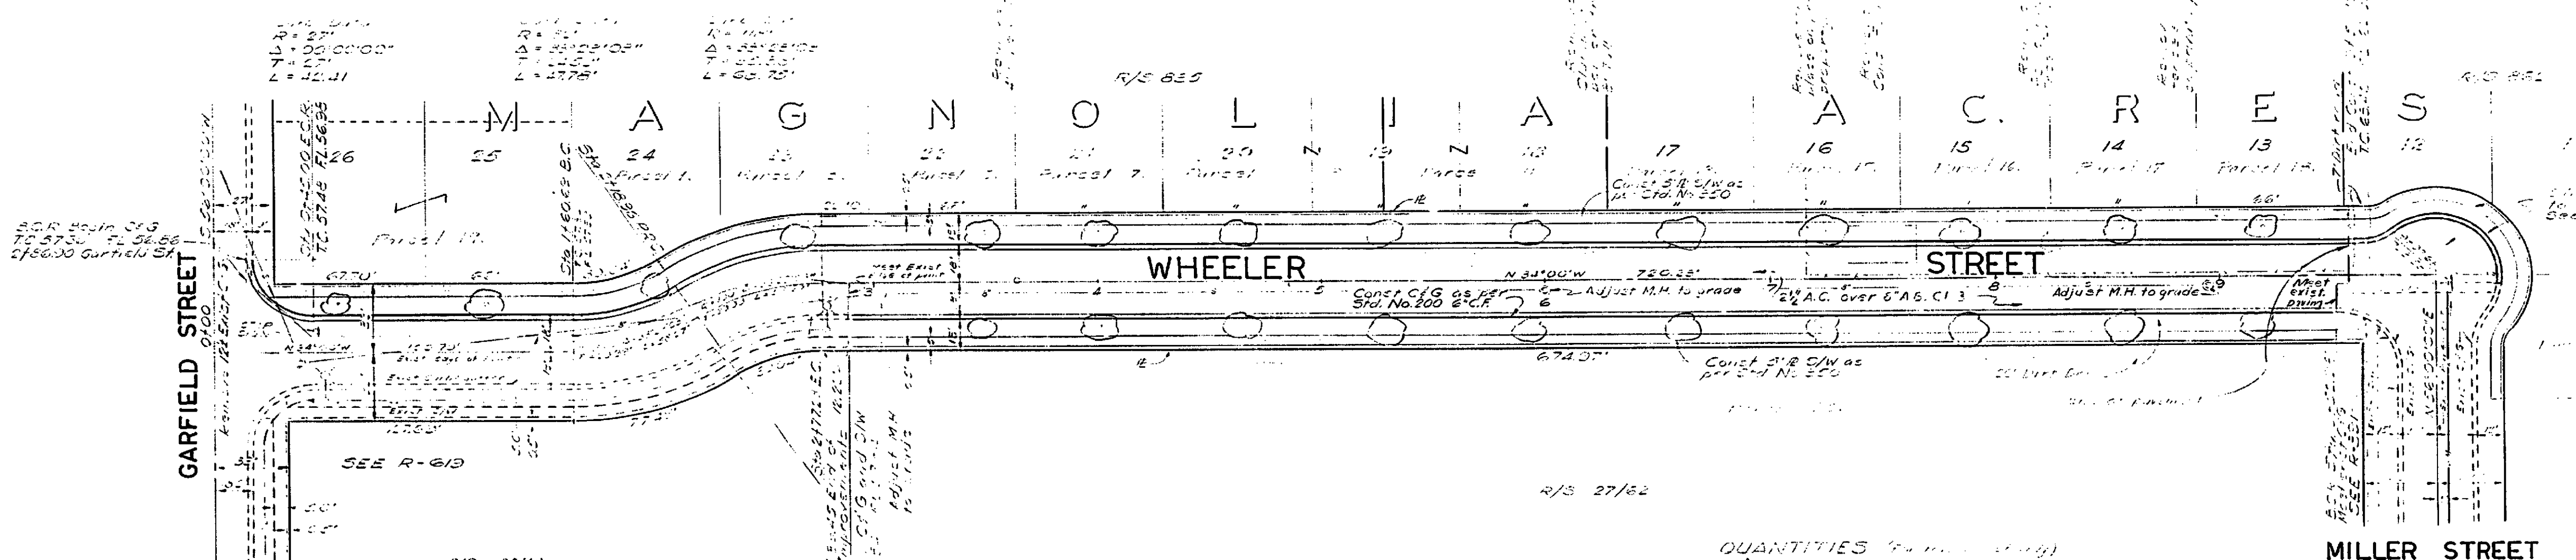


Notes:
1. All work to be done by others.

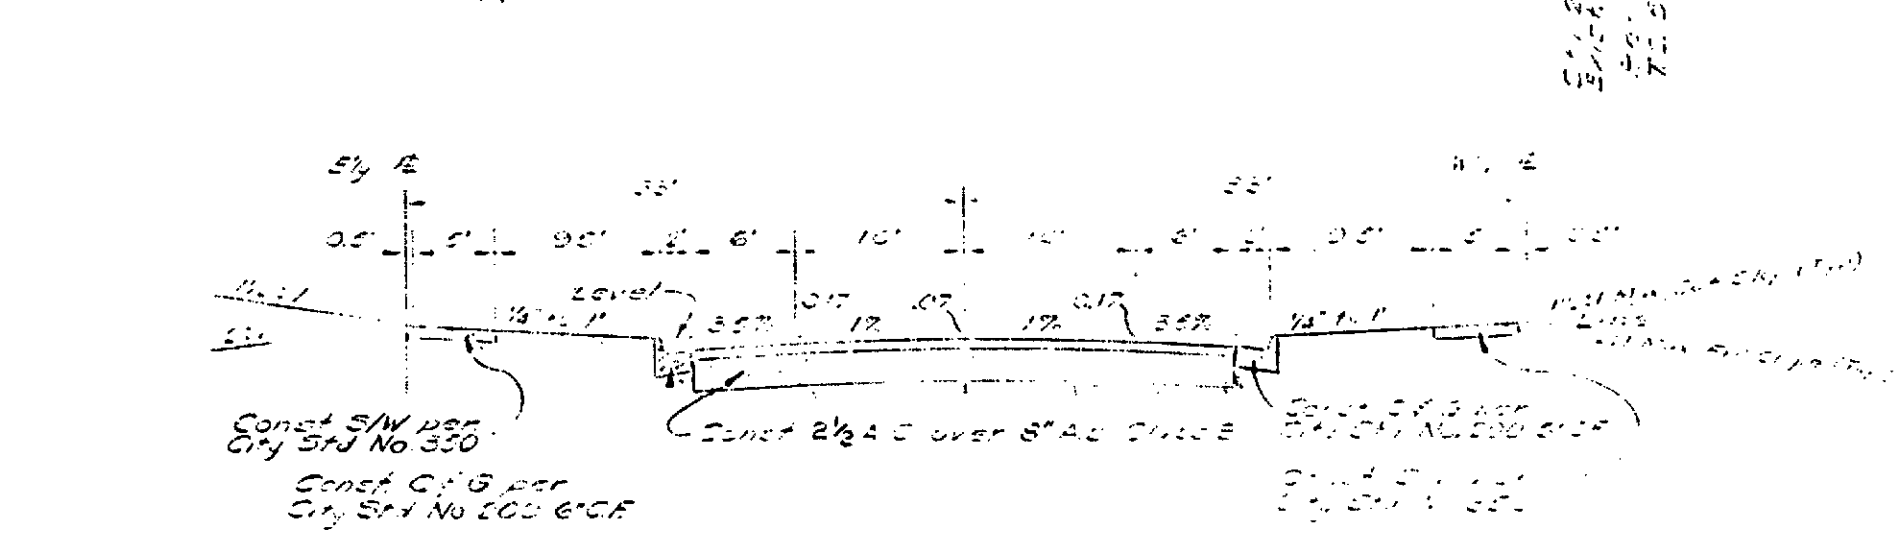

TYPICAL SECTION

QUANTITIES (See Notes 1 & 2)
12.00 LF CURB
72.00 LF GUTTER
22.00 LF SIDEWALK
3 EA. MANHOLE T. 18"

CITY OF RIVERSIDE, CALIFORNIA DEPARTMENT OF PUBLIC WORKS		WHEELER STREET IMPROVEMENT DISTRICT		ACC. NO. 6056
APPROVED BY OFFICE ENGINEER DATE 12/1/62	BY DATE 12/1/62	APPROVED BY DIRECTOR OF PUBLIC WORKS DATE 12/1/62	WHEELER STREET CURBS GUTTERS SIDEWALKS	R-1004 1 3
DESIGNED BY DRAWN BY CHECKED BY	APPR. DATE	DATE	HORIZ. SCALE: 1"=40'	VERT. SCALE: 1"=4'

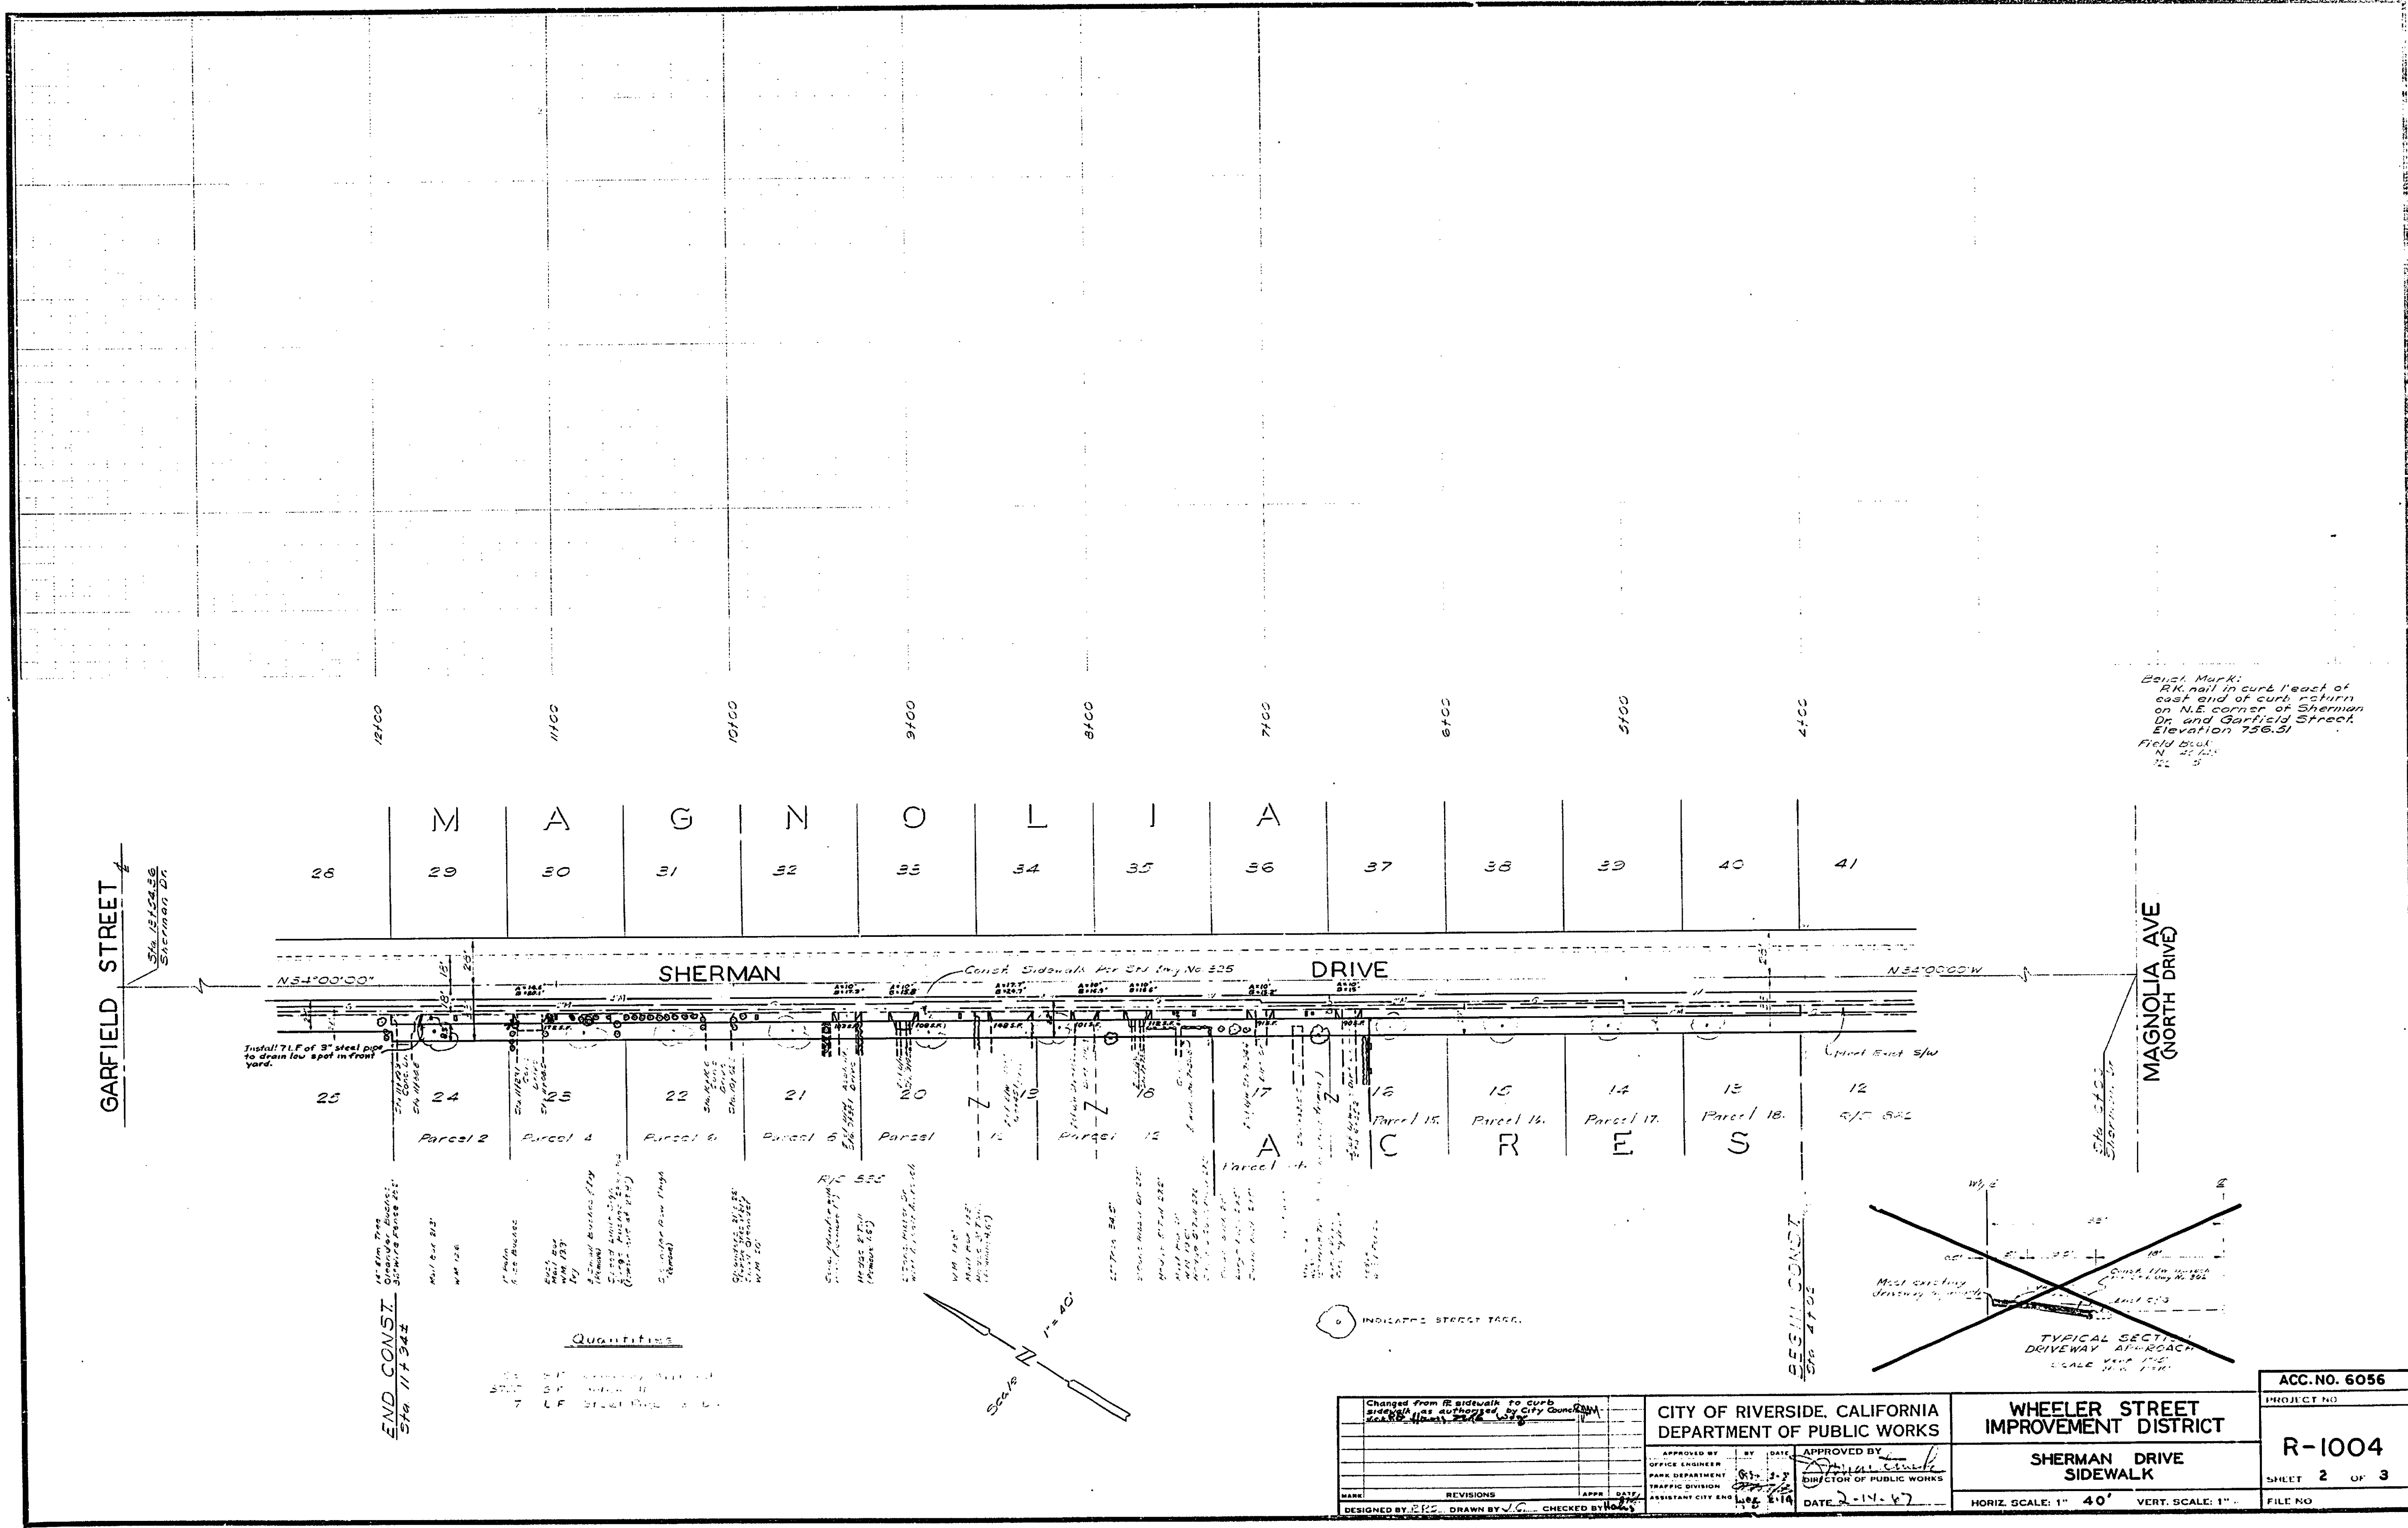


Bevel Mark:
 RK nail in curb east of
 east end of curb return
 on NE corner of Sherman
 Dr. and Garfield Street.
 Elevation 756.31
 Field Book
 N 45 22
 72 3


Install 71' of 3" steel pipe
 to drain low spot in front
 yard.

14' from Prop.
 14' from Prop.
 END CONST.
 SFR 117342


Quantities
 3' LF 3" Steel Pipe

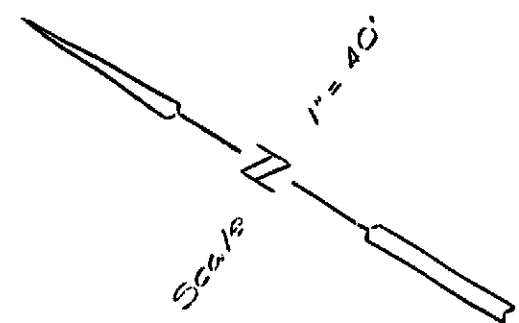

INDICATE STREET TACK.

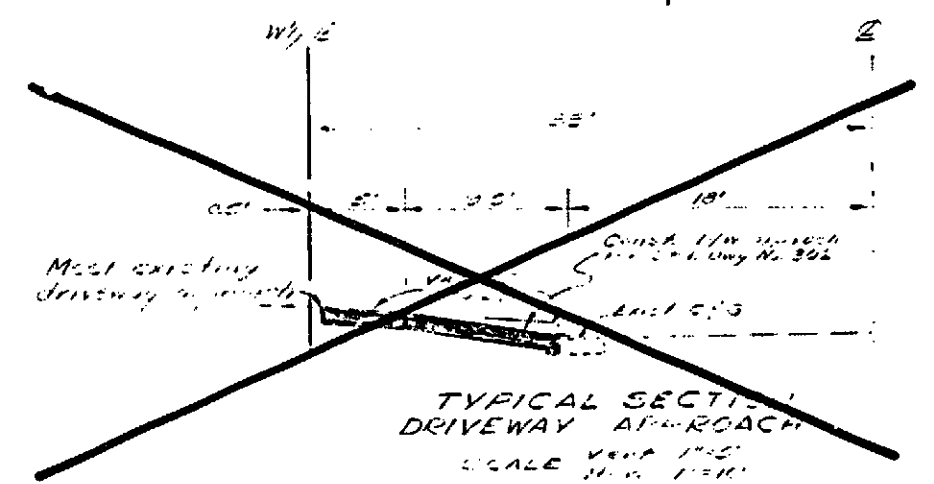


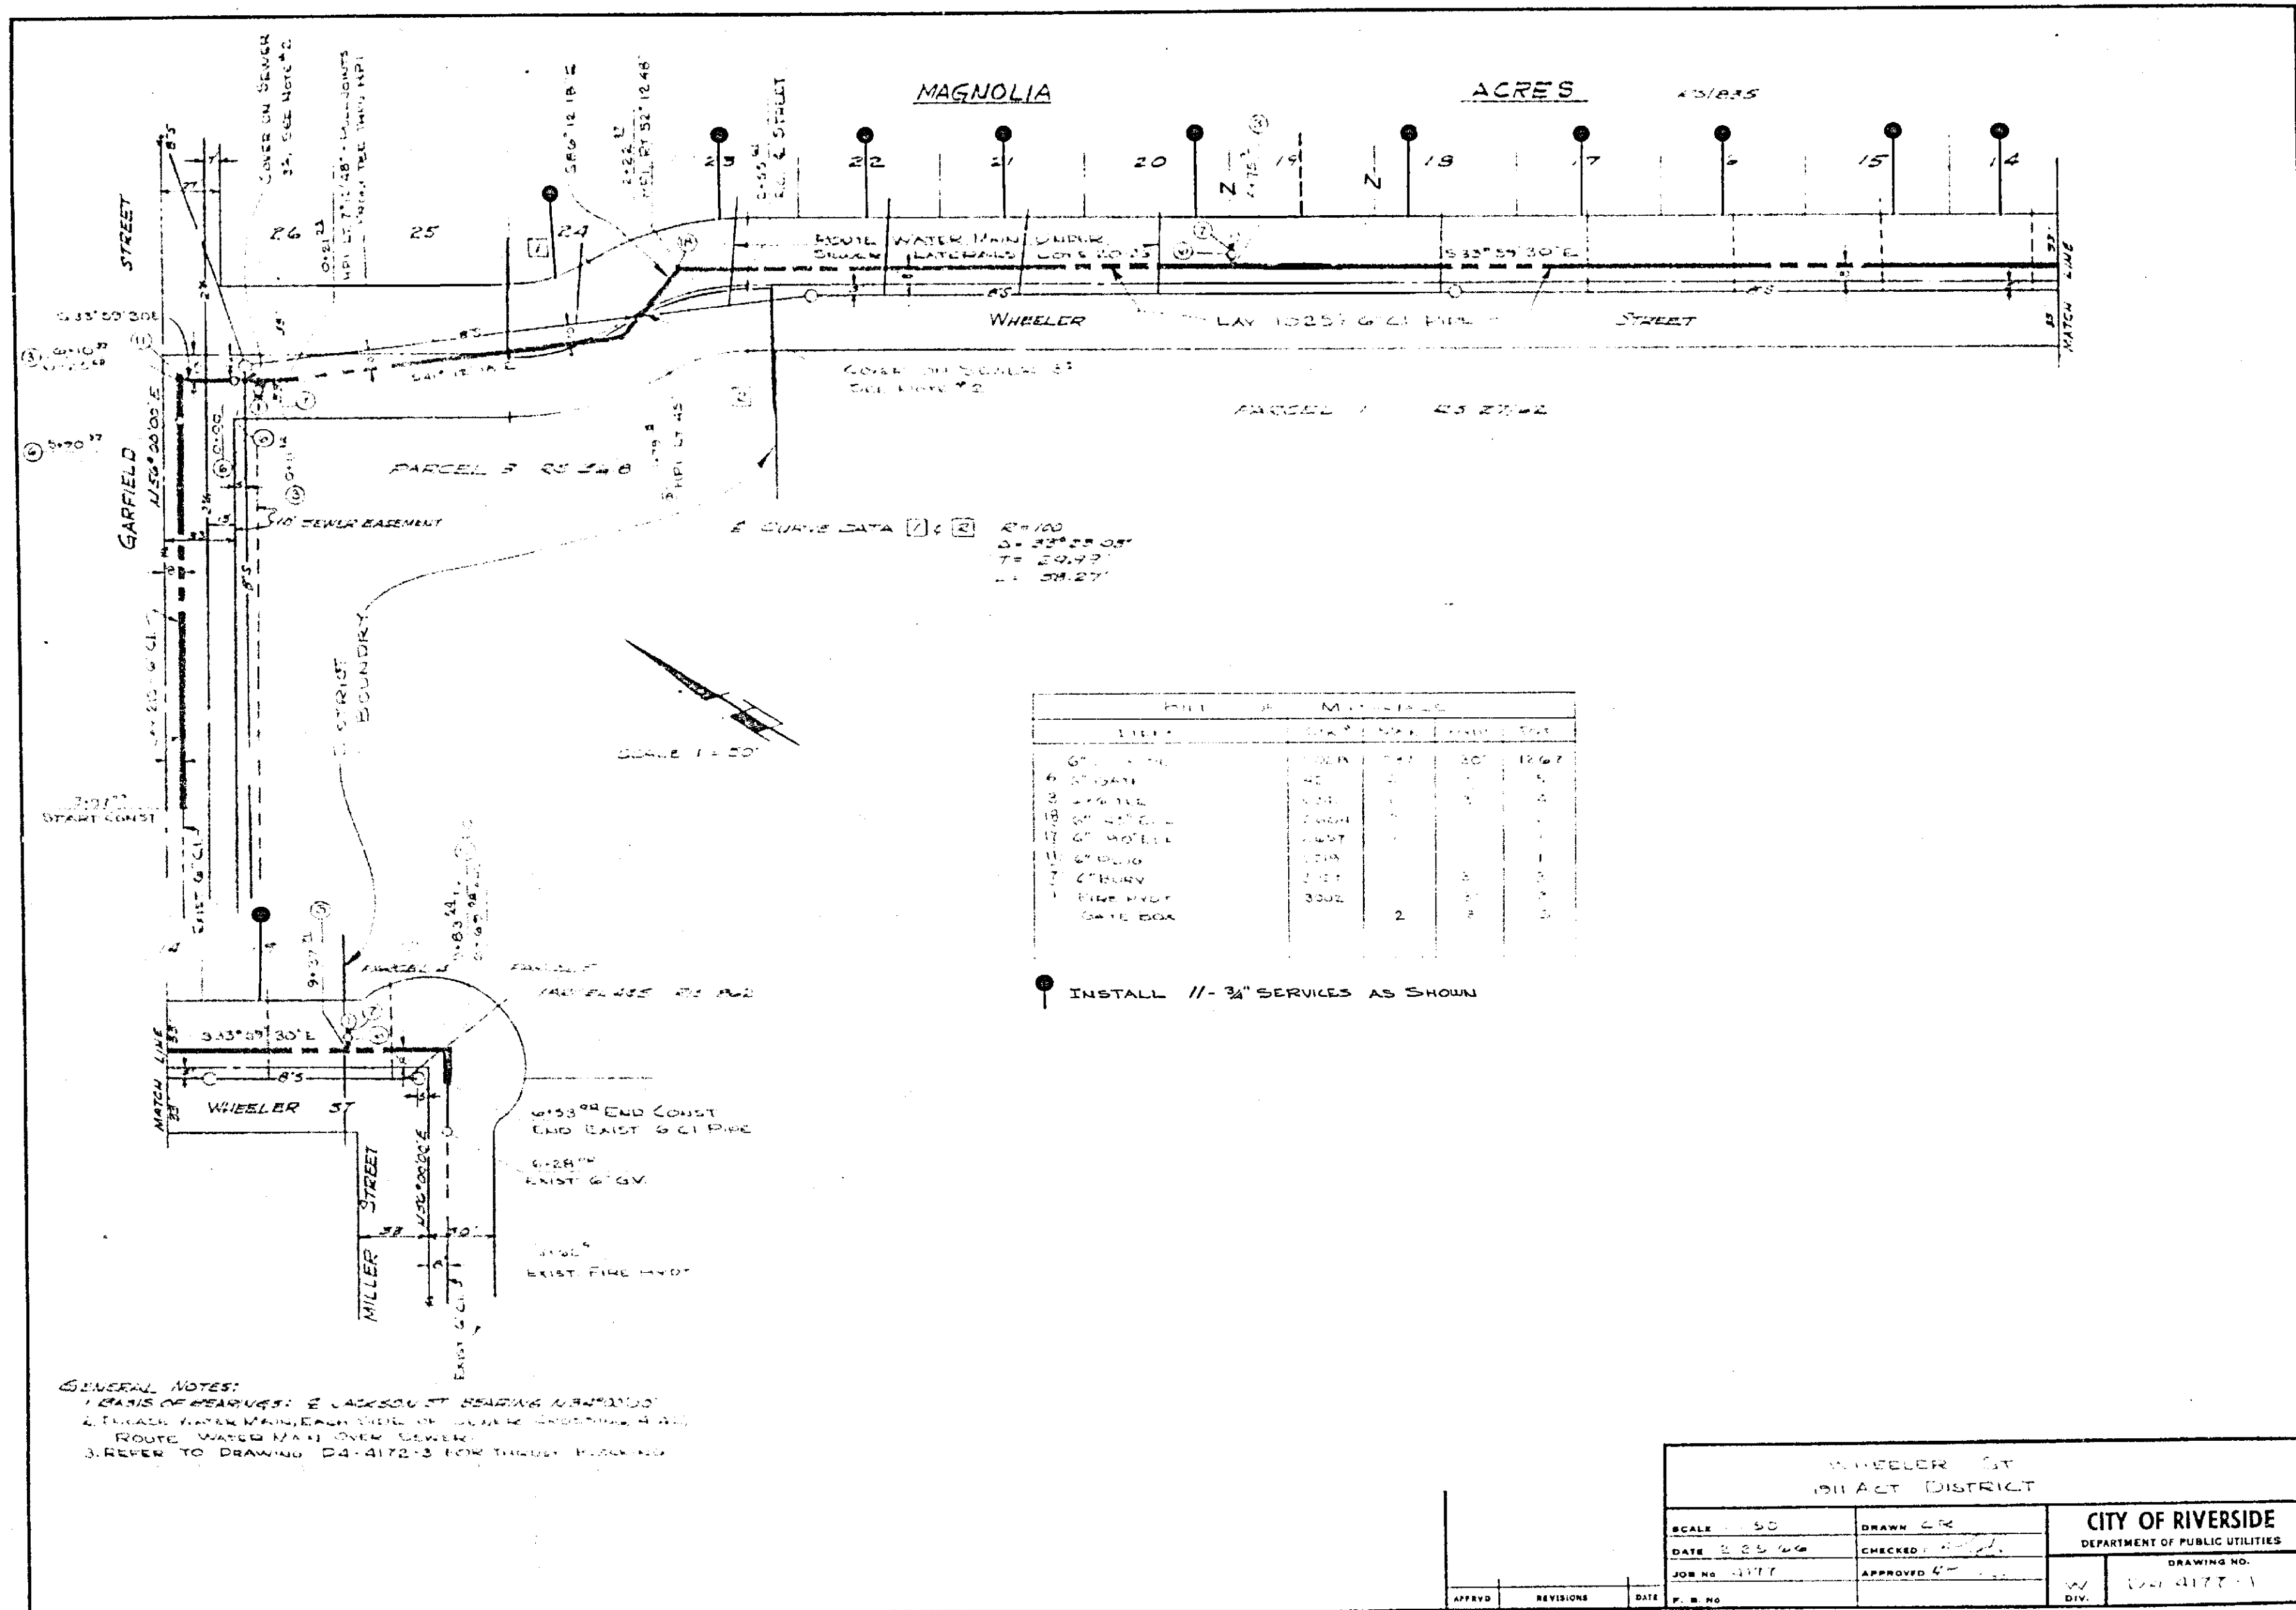

GENERAL NOTES:
 3. REFER TO DRAWING 24-1172-3 FOR TRUSS FROM NW

SCALE: 50'	DRAWN BY: [Signature]	DATE: 2-23-67	CHECKED BY: [Signature]
JOB NO: 1177	APPROVED BY: [Signature]	DIV: [Blank]	DRAWING NO: 1177-11

