


Const. Schedule For
9' WGOR Clearance
Markers Per City
Sta. Disp. No. 554

Station	Offset from Center Line
3200	13' RT
3300	"
3400	"
3500	"
3600	13' LT
3700	"
3800	"
3900	"

BENCH MARK: 1. 2. 

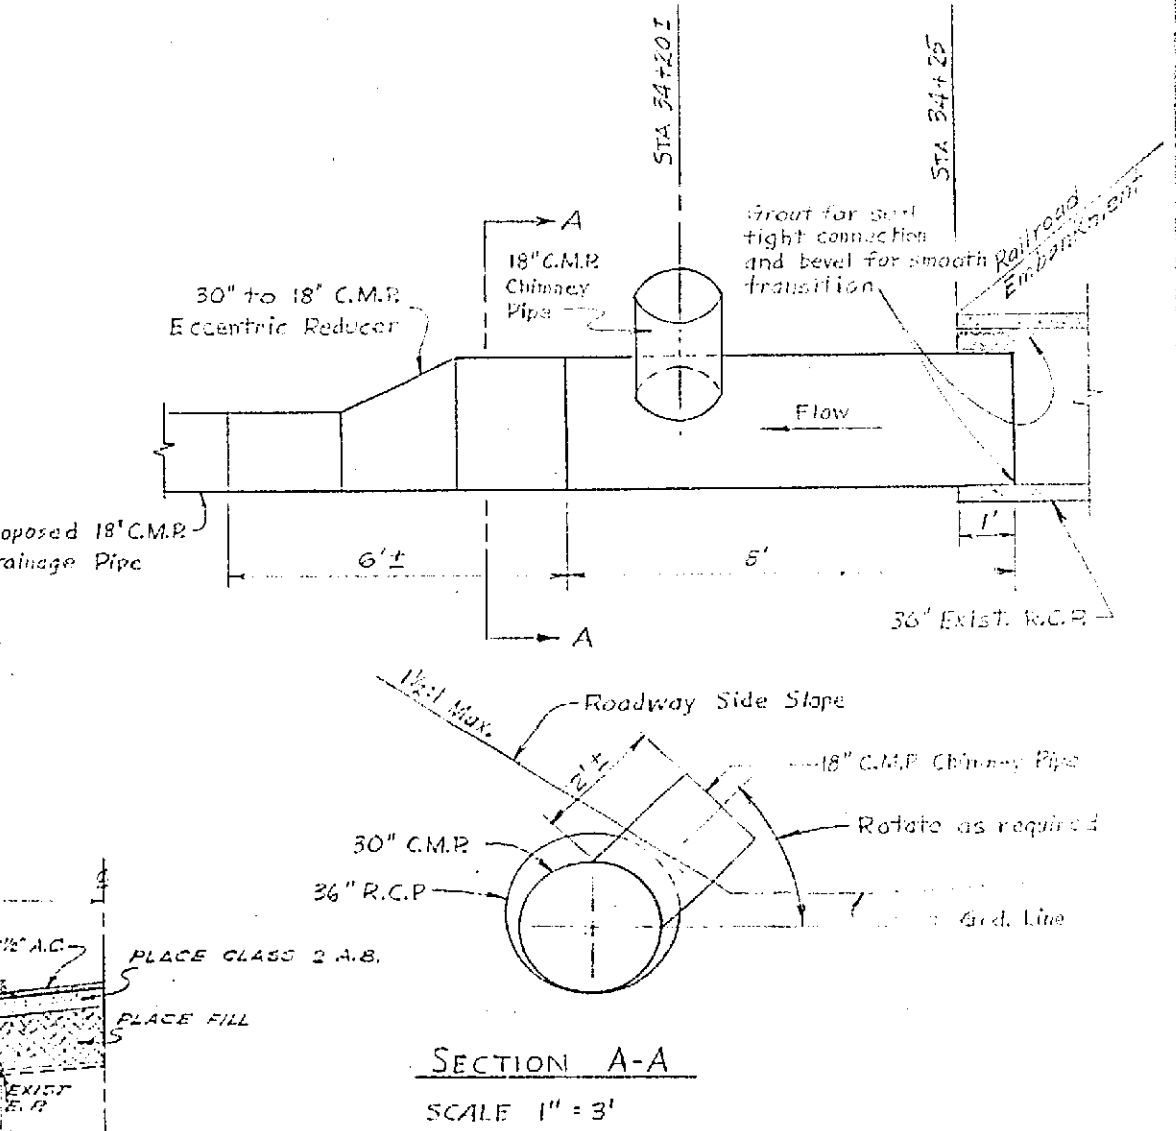

MATCH-UP PAVING SCHEDULE

STATION	FINISH	EXIST. SLOPE	PROPOSED SLOPE	FINISH	PROPOSED SLOPE
27+00	11.6	-3.3%	-3.0%	11.6	-3.3%
28+00	11.6	-3.3%	-3.0%	11.6	-3.3%
TYPICAL SECTION
SPRUCE STREET T.I.-7
NO. 6046
Sta. 27+18.2 to Sta. 30+7.5 (See Chart)
Sta. 30+7.5 to Sta. 32+94.7 (See Detail)

REVISIONS AS PER CHANGE ORDER NO. 1 BY: [Signature] DATE: 1/15/55	ALBERT A. WEBB ASSOCIATES CIVIL ENGINEERS RIVERSIDE, CALIFORNIA APPROVED BY: [Signature] DATE: 1/15/55 R.E. NO. 3876	Adapted from plan R-1022 to show City's portion of work 1/2" Scale by [Signature] Changed Units of Weaving per Addendum No. 1 J. Campbell use of [Signature]	CITY OF RIVERSIDE, CALIFORNIA DEPARTMENT OF PUBLIC WORKS		STREET PLAN AND PROFILE SPRUCE STREET FROM 425' E'LY OF CHICAGO TO S.P.R.R. HORIZ. SCALE 1" = 50' VERT. SCALE 1" = 5' PROJECT NO. 55 R-1022A SHEET 1 OF 1 FILE NO. GJ-44 A
			APPROVED BY: [Signature] DATE: 1/15/55 OFFICE ENGINEER TRAFFIC DIVISION ASSISTANT CITY ENGINEER	APPROVED BY: [Signature] DATE: 1/15/55 DIRECTOR OF PUBLIC WORKS	