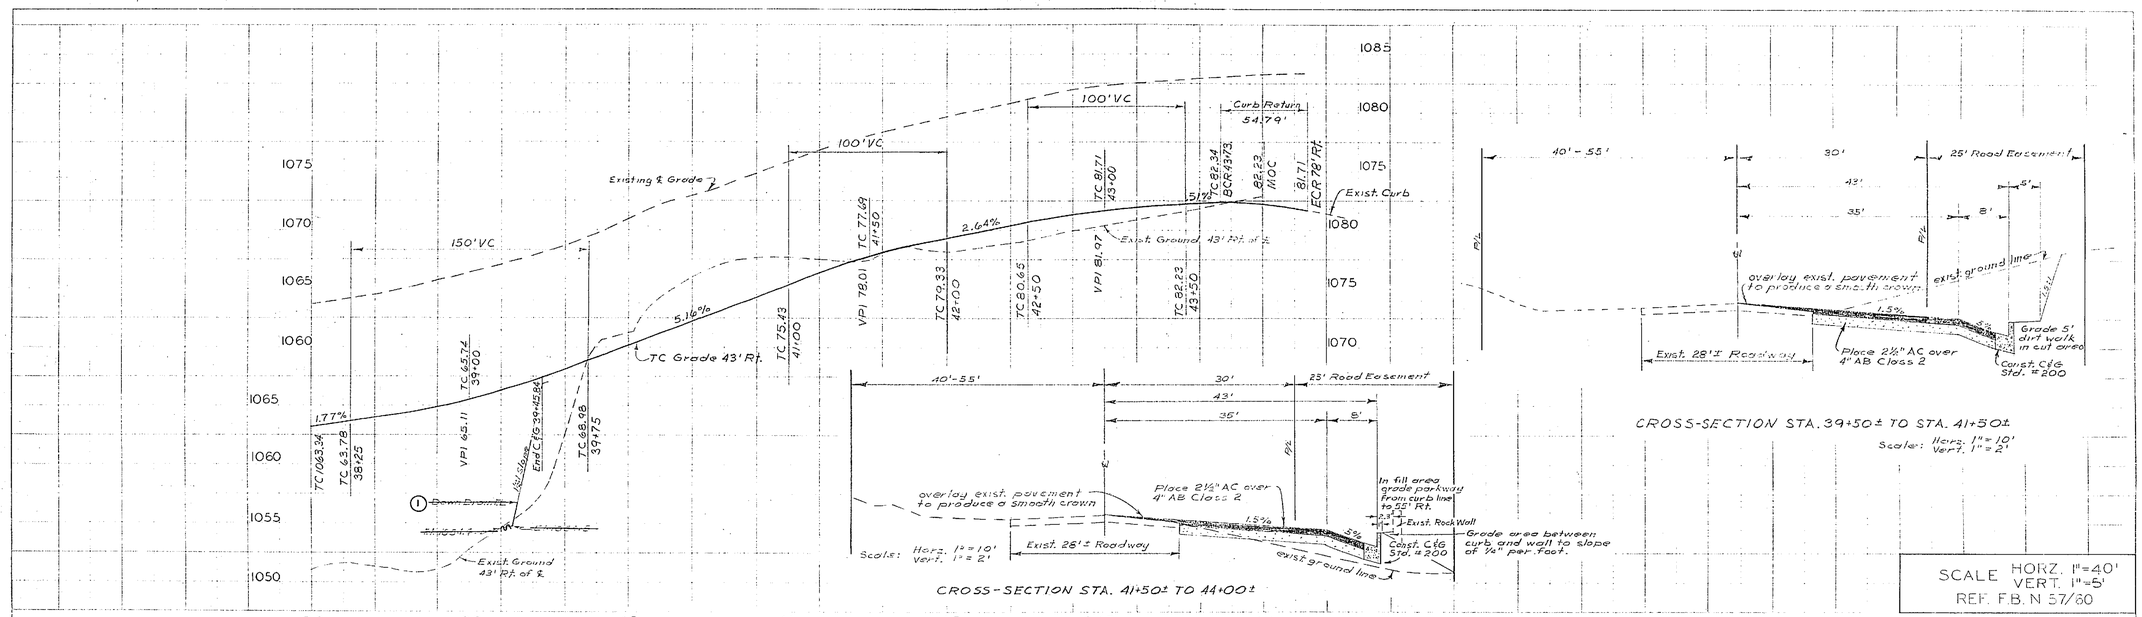

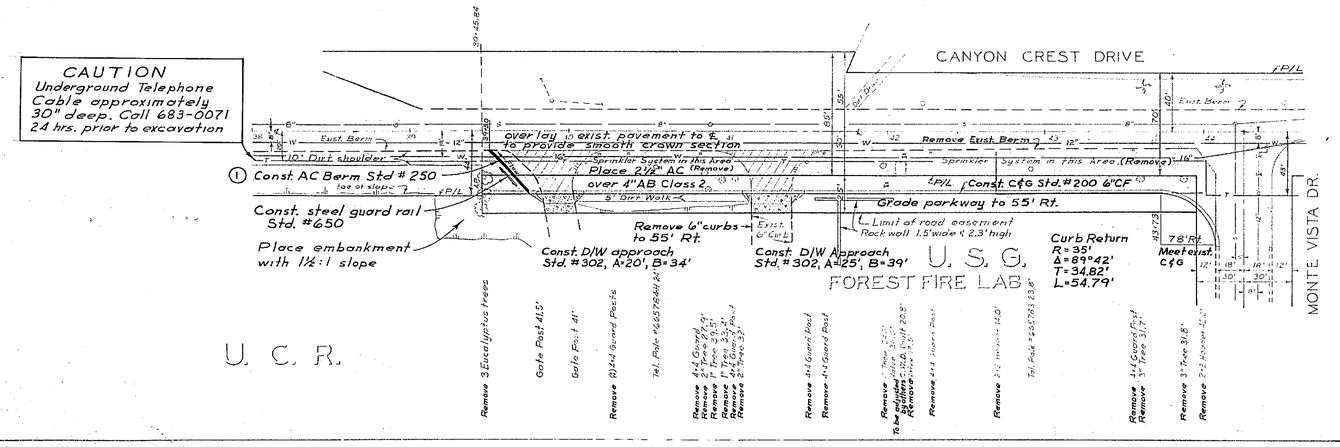

Estimate of Quantities

Clearing and Grubbing	Lump Sum
Excavation	715 CY
Tree Removal	3 Ea
Curb and Gutter	482 LF
Driveway Approach	579 SF
AC	250 Tons
AB Class 2	164 CY
AC berm Std.#250	40 LF
Steel Guard Rail	16 LF

Note: Exist. utilities within const. area will be relocated or removed by the respective Utility Co.

REVISIONS			CITY OF RIVERSIDE, CALIFORNIA
MARK	DATE	DESCRIPTION	DEPARTMENT OF PUBLIC WORKS
①	4-9-65	Revisions as requested by U.C.R. Sam ℄ℓ, CRX	SS-PROJECT NO. 244
			PLAN AND PROFILE
			CANYON CREST DRIVE
			BETWEEN PENNSYLVANIA AVE & MONTE VISTA DR.

DESIGNED BY FHE
DRAWN BY Sam
CHECKED BY
SUBMITTED BY Charles E. Richardson
PARK DEPT. 4-8-71
TRAFFIC DIV. 4-8-71
RECOMMENDED
APPROVED BY J. Mountcastle
DATE 4-5-65
R-1024
SHEET 1 OF 1