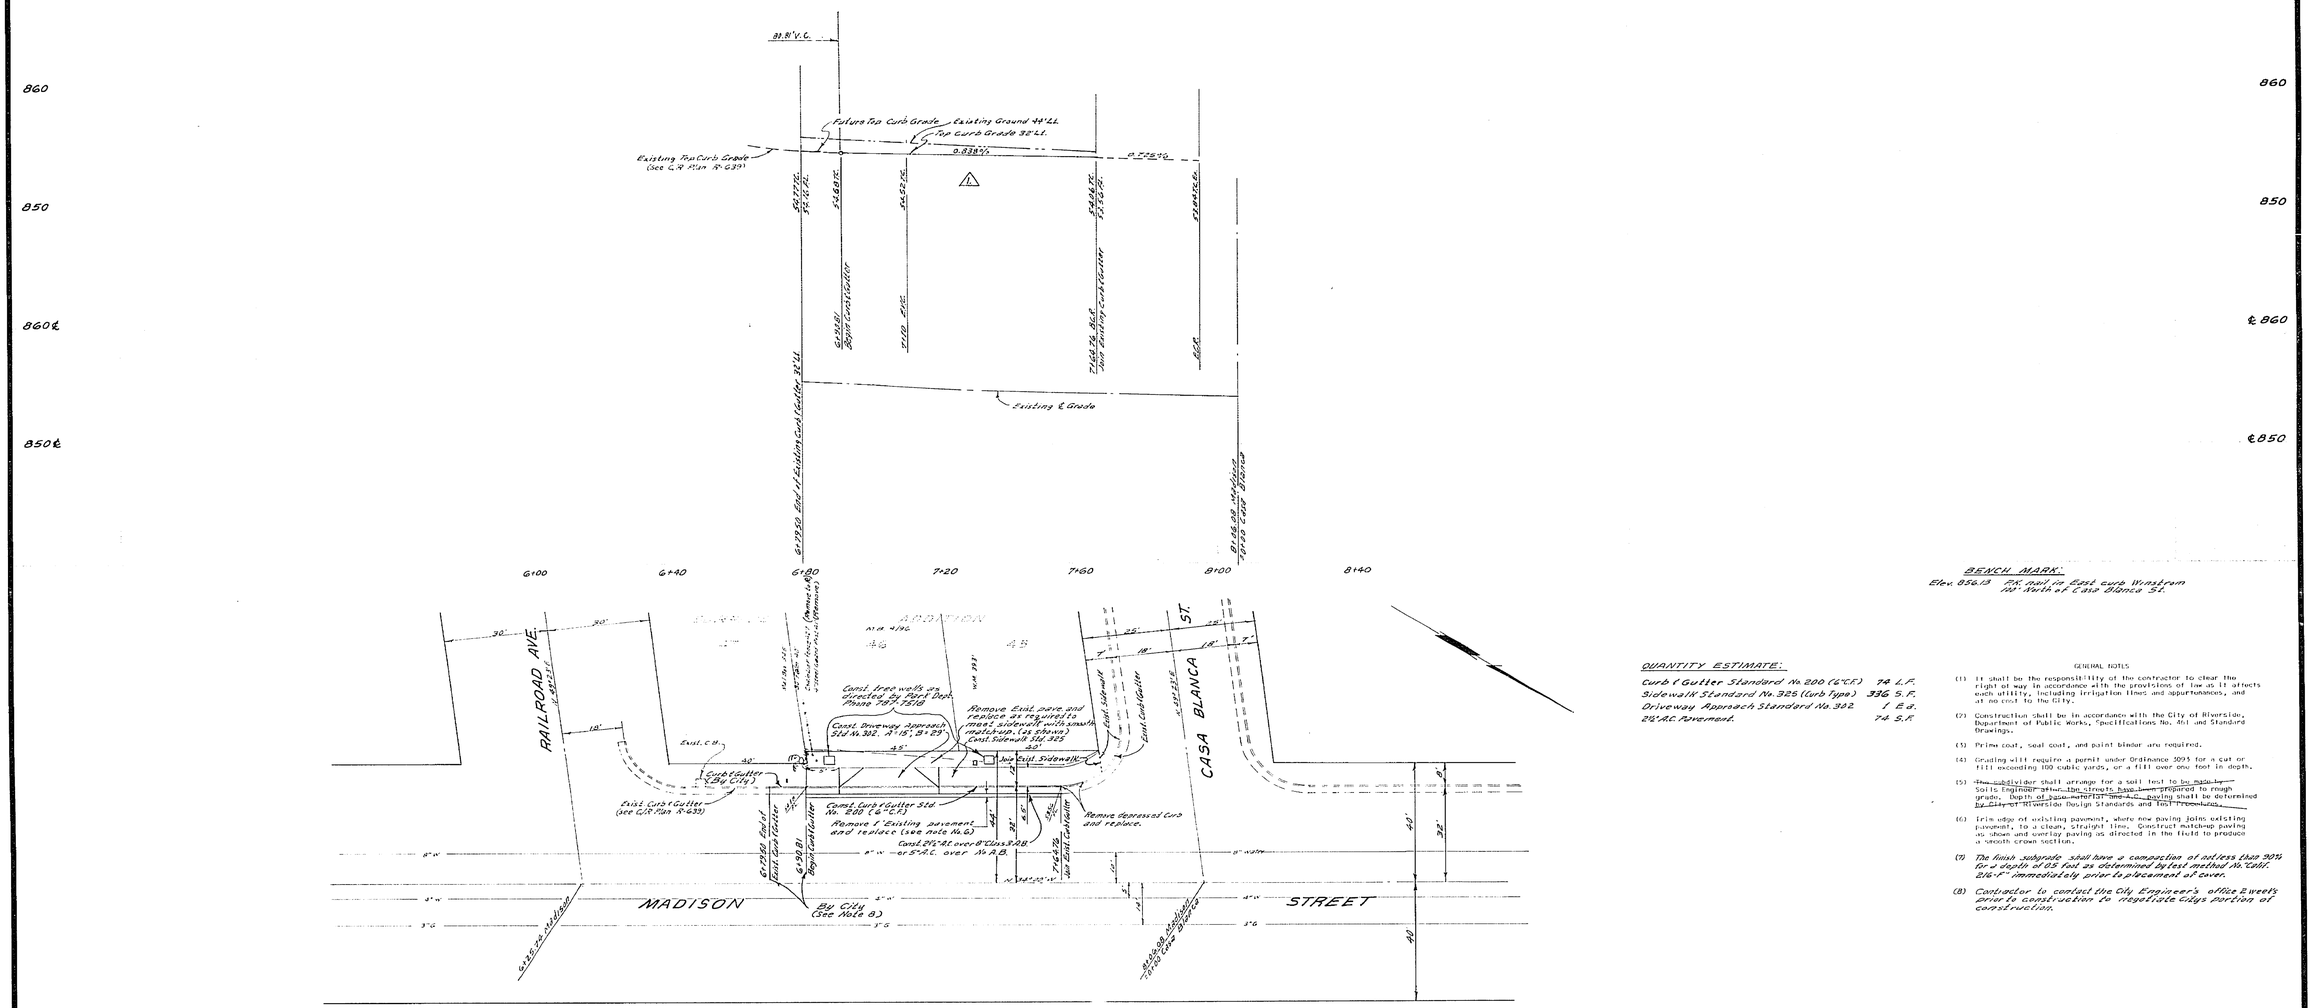

TYPICAL SECTION
MADISON STREET
NO SCALE

NOTICE TO CONTRACTOR

The existence and location of any underground utilities or structures shown on these plans are obtained by a search of the available records. To the best of our knowledge, these are all existing utilities except as shown on these plans.

The contractor is required to take due precautionary measures to protect the utility lines shown and any other lines not of record or not shown on these plans.

BENCH MARK

Elev. 856.13 PK nail in East curb Winstram 110' North of Casa Blanca St.

QUANTITY ESTIMATE:

Curb & Gutter Standard No. 200 (6" C.F.)	74	L.F.
Sidewalk Standard No. 325 (Curb Type)	336	S.F.
Driveway Approach Standard No. 302	1	Ea.
2½" A.C. Pavement	74	S.F.

GENERAL NOTES

(1) It shall be the responsibility of the contractor to clear the right of way in accordance with the provisions of law as it affects each utility, including irrigation lines and appurtenances, and at no cost to the City.

(2) Construction shall be in accordance with the City of Riverside, Department of Public Works, Specifications No. 461 and Standard Drawings.

(3) Prime coat, seal coat, and paint blinder are required.

(4) Grading will require a permit under Ordinance 3095 for a cut or fill exceeding 100 cubic yards, or a fill over one foot in depth.

(5) ~~The subdivider~~ shall arrange for a soil test to be made by ~~the~~ Soils Engineer after the streets have been prepared to rough grades. Depth of base material and A.C. paving shall be determined ~~by City of Riverside Design Standards and Test Procedure.~~

(6) Trim edge of existing pavement, where new paving joins existing pavement, to a clean, straight line. Construct matchup paving as shown and overlay paving as directed in the field to produce a smooth crown section.

(7) The finish subgrade shall have a compaction of not less than 90% for a depth of 0.5 feet as determined by test method No. Calif. 216-F immediately prior to placement of cover.

(8) Contractor to contact the City Engineer's office 2 weeks prior to construction to negotiate City's portion of construction.

N-54 S.B. 615

ALBERT A. WEBB ASSOCIATES CIVIL ENGINEERS RIVERSIDE, CALIFORNIA	CITY OF RIVERSIDE, CALIFORNIA DEPARTMENT OF PUBLIC WORKS
APPROVED BY [signature] DATE 6/26/67 R.E. No. 3916	STREET PLAN & PROFILE MADISON STREET Southwest side, between Railroad Ave. & Casa Blanca Z.C. A-96-656
W.O. 67-165 FOR: JOE MARIETTA F.B. G 50	HORIZ. SCALE: 1" = 20' VERT. SCALE: 1" = 5'
MARK: 1 REVISIONS: Revised Top Curb grade to meet Dr. forman; BY: BEL; APPR.: [illegible]; DATE: 9-2-65 DESIGNED BY: BEL DRAWN BY: BEL CHECKED BY: MF REC.	APPROVED BY: OFFICE ENGINEER [illegible] 7-21; PARK DEPARTMENT —; TRAFFIC DIVISION [illegible] 7-19; ASSISTANT CITY ENG. [illegible] 7-26 APPROVED BY (DIRECTOR OF PUBLIC WORKS) [signature] DATE 7/27/67
	PROJECT NO. R-1236 SHEET 1 OF 1 FILE NO. 67-165