



PROFILE SCALE
 HORIZ. : 1" = 20'
 VERT. : 1" = 2'

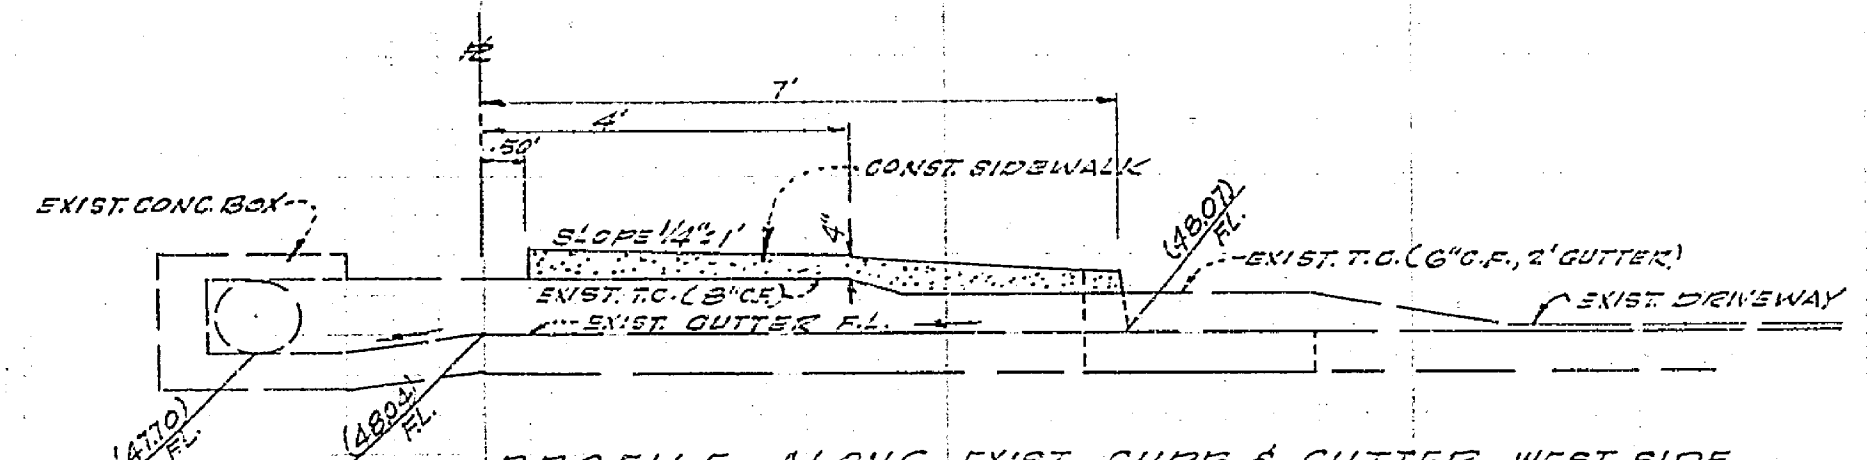


PROFILE ALONG EXIST. CURB & GUTTER, WEST SIDE.
 SCALE HORIZ. 1" = 20'
 VERT. 1" = 2'

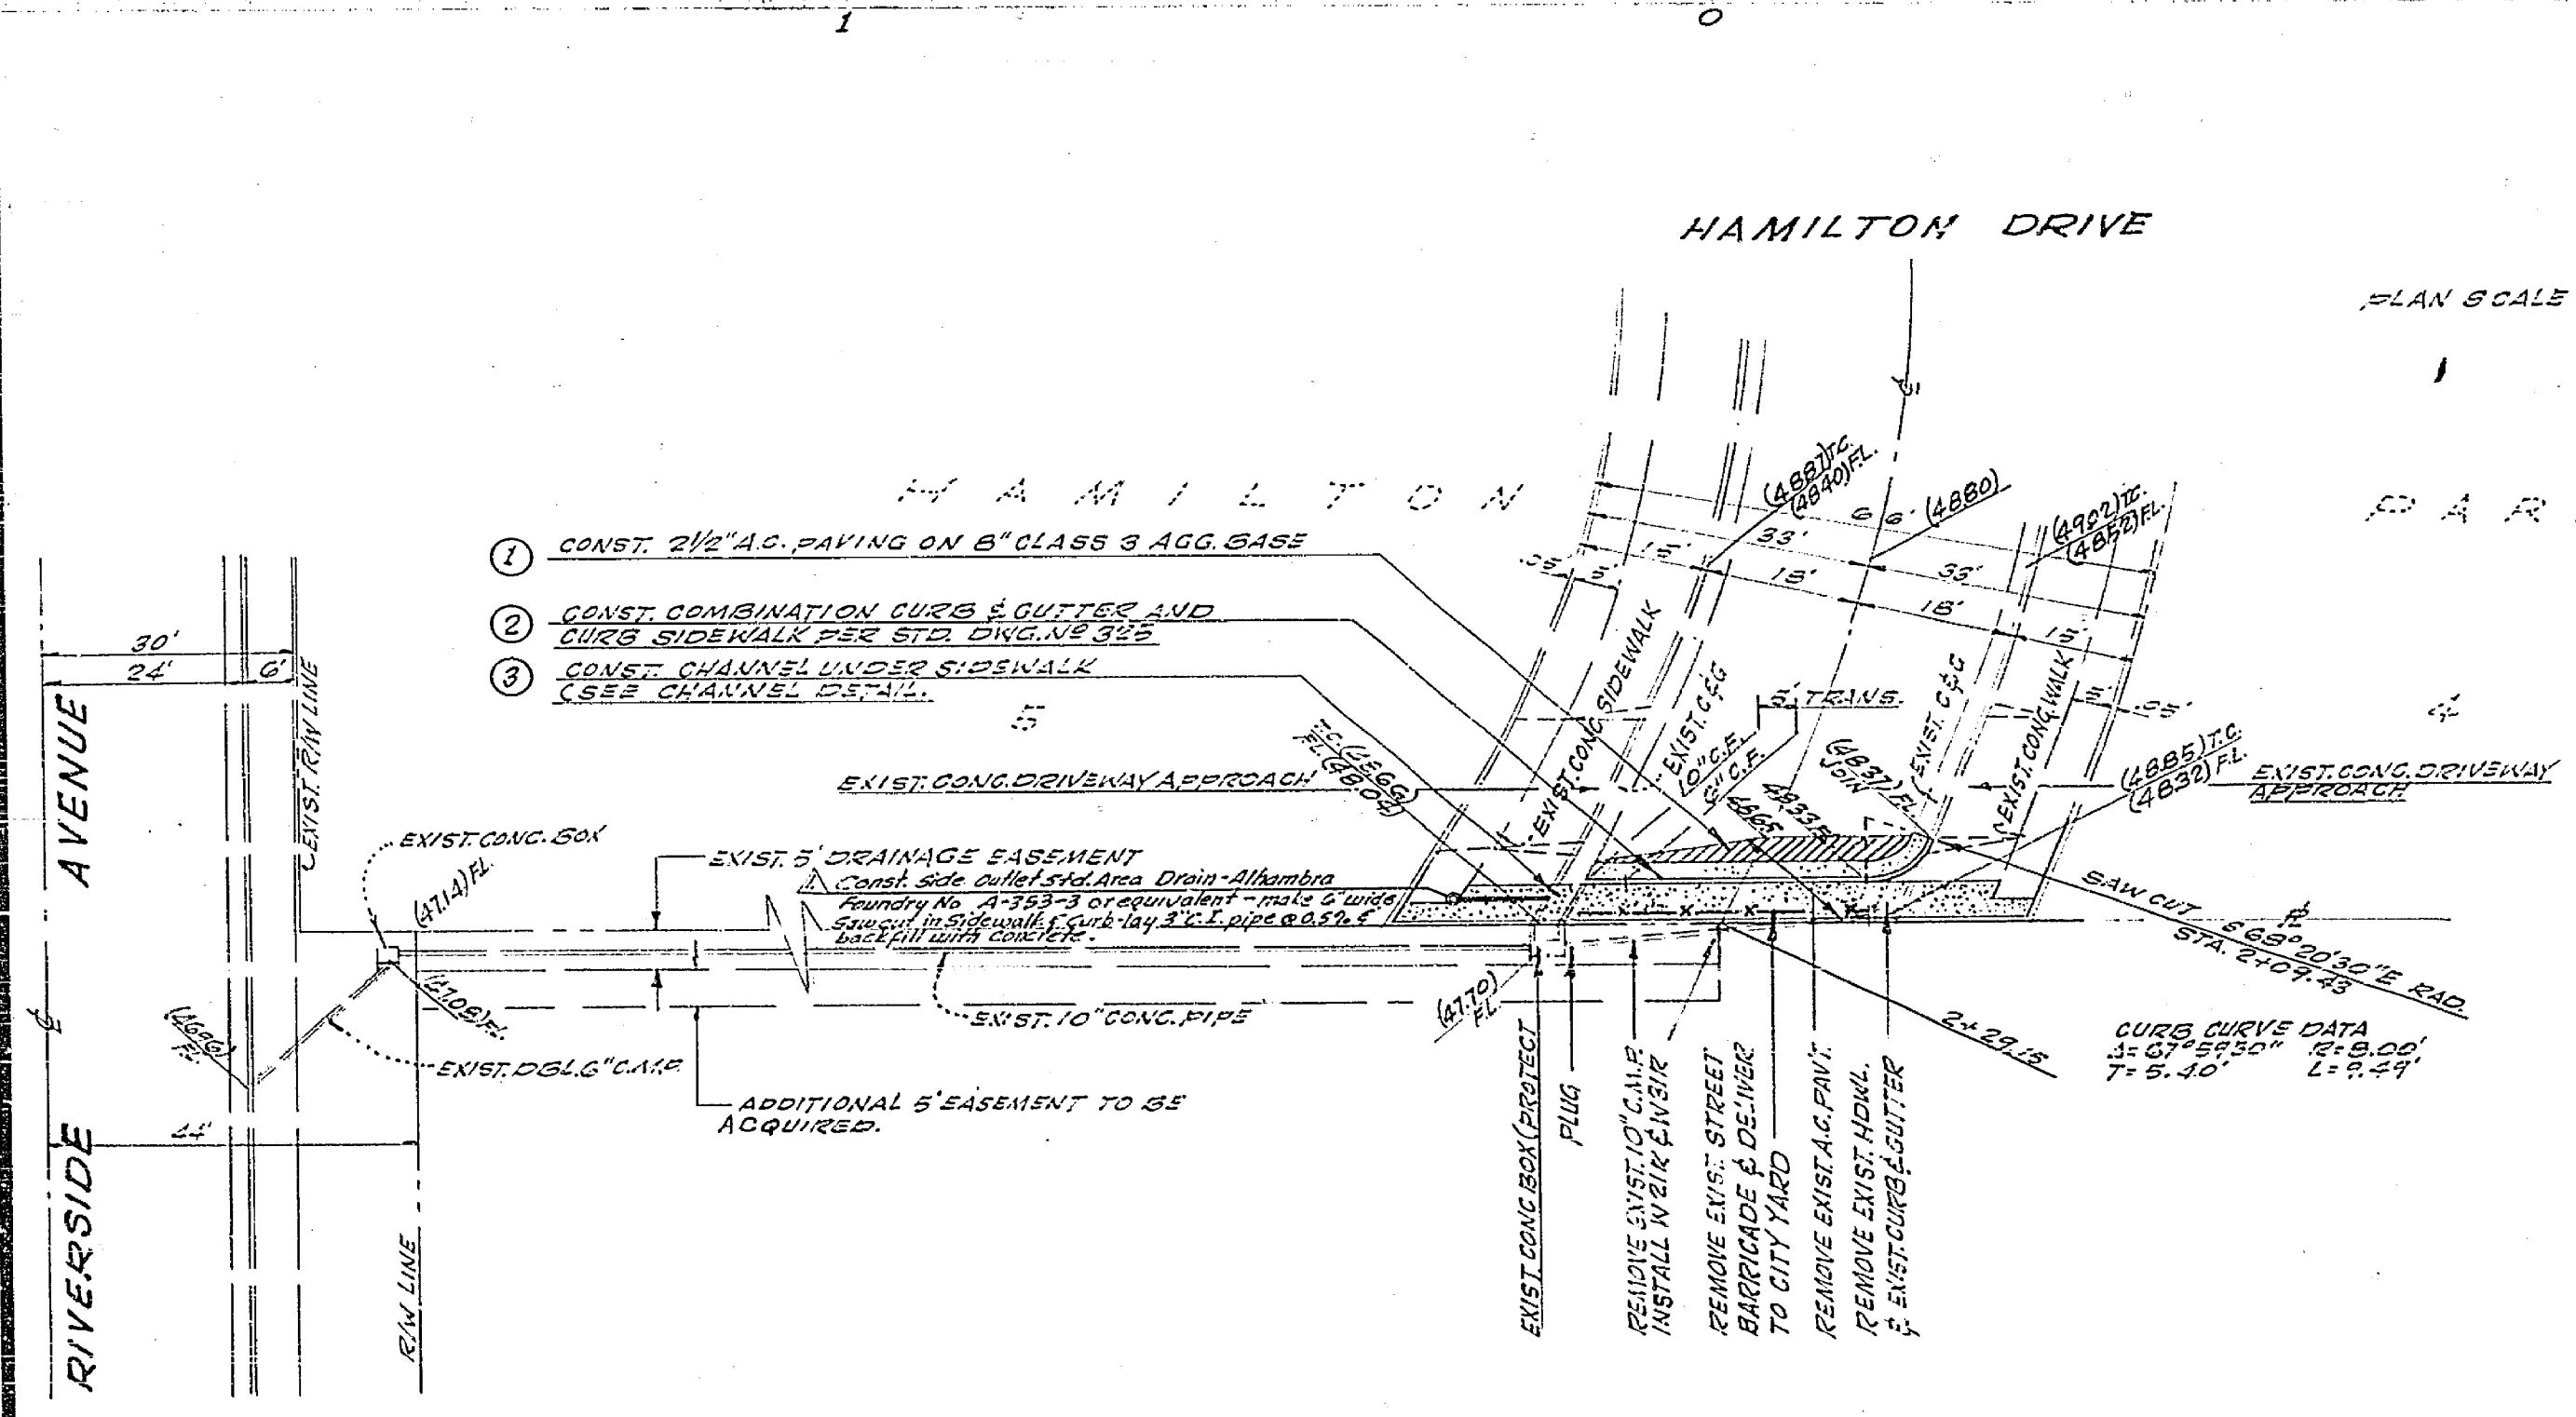


- 1 CONST. 2 1/2" A.C. PAVING ON 6" CLASS 3 AGG. BASE
- 3 CONST. CHANNEL UNDER SIDEWALK (SEE CHANNEL DETAIL)

PLAN SCALE: 1" = 20'

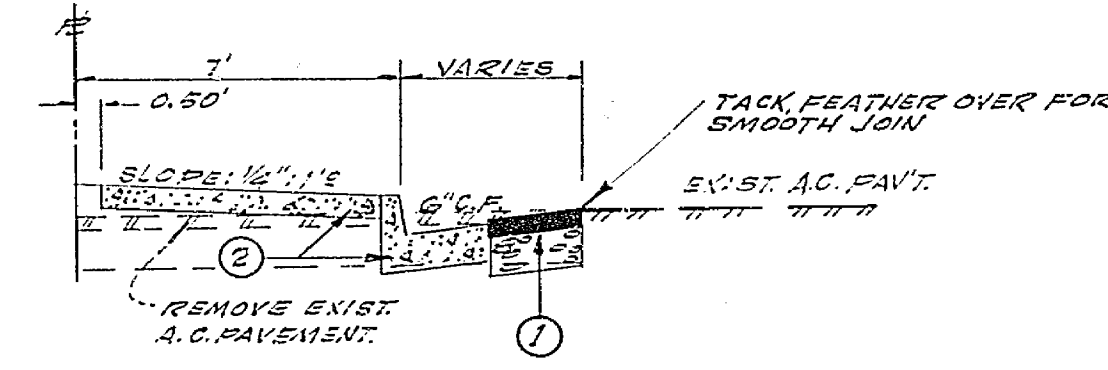

TYPICAL SECTION
 COMB. CURB & GUTTER AND CURB SIDEWALK
 SCALE: 1" = 4'

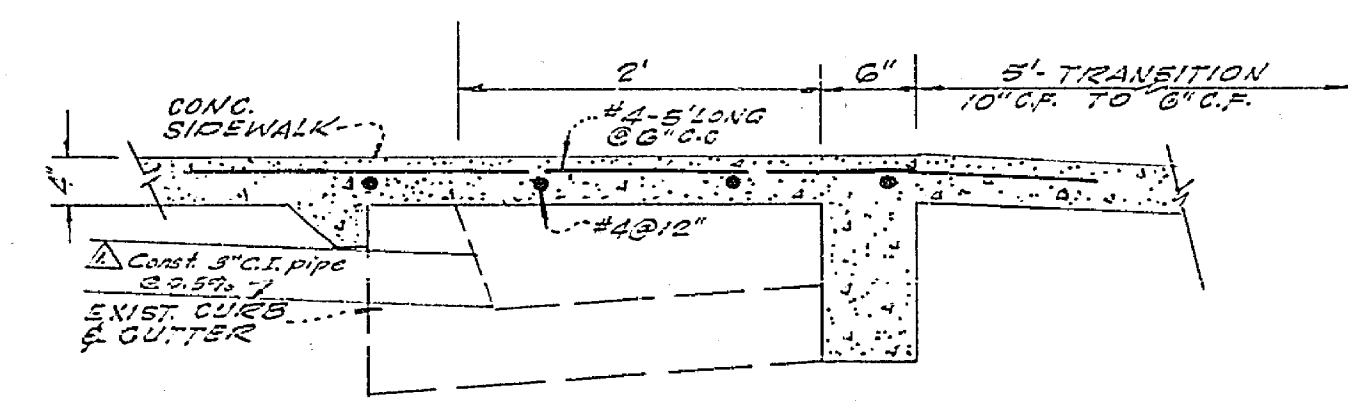

CHANNEL DETAIL
 SCALE: 1" = 1'

GENERAL NOTES

- 1 CONSTRUCTION SHALL BE IN ACCORDANCE WITH THE CITY OF RIVERSIDE DEPT. OF PUBLIC WORKS, SPECIFICATIONS NO. 261 AND STANDARD DRAWINGS.
- 2 IT SHALL BE THE RESPONSIBILITY OF THE CONTRACTOR TO CLEAR THE RIGHT OF WAY IN ACCORDANCE WITH THE PROVISIONS OF LAW AS IT AFFECTS EACH UTILITY INCLUDING IRRIGATION LINES AND APPURTENANCES AND AT NO COST TO THE CITY.
- 3 PRIME COAT, SEAL COAT AND PAINT BINDER ARE REQUIRED.
- 4 TRIM EDGE OF EXISTING PAVEMENT WHERE NEW PAVEMENT JOINS EXISTING PAVEMENT TO A CLEAN STRAIGHT LINE. CONSTRUCT MATCHUP PAVING AS SHOWN.

BENCH MARK
 PK MARK IN LEAD IN SW CURB RETURN, CENTRAL & RIVERSIDE AVE. CITY F.G. 7-27, 97. ELEV. 835.61

CRAWLEY, HAWKINS & ASSOC. ENGINEERS AND SURVEYORS 3709 ELIZABETH ST., RIVERSIDE, CALIF.		CITY OF RIVERSIDE, CALIFORNIA DEPARTMENT OF PUBLIC WORKS		STREET PLAN AND PROFILE HAMILTON DRIVE CLOSING OF SOUTH END	PROJECT NO. R-1347
APPROVED: <i>George O. Crawley</i> 4/12 1969 U.C.C.E. 9455	DATE 4/12/69	APPROVED BY: <i>William B. Hester</i> DIRECTOR OF PUBLIC WORKS	DATE 4/13/69	SHEET 1 OF 1	FILE NO. 4148
DESIGNED BY: _____ DRAWN BY: _____ CHECKED BY: _____	REVISIONS: _____ APRIL DATE: _____	ASSISTANT CITY ENG. _____	HORIZ. SCALE: 1" = 20' VERT. SCALE: 1" = 2'		