


STREET NAME SCHEDULE
 (A) COLUMBIA AVE.
 CLOVERDALE AVE.
 CONTACT TRAFFIC DIVISION FOR BLOCK NUMBERS PRIOR TO ORDERING STREET NAME SIGNS.

ESTIMATE OF QUANTITIES

ROADWAY EXCAVATION	315	CY
CURB & GUTTER 6" C.F.	320	LF
CROSS GUTTER & APRON	1500	SF
SIDEWALK 6' WIDE	2500	SF
2 1/2" AC PAVING	3600	SF
1" CLASS 3 A.B.	250	LF
2X4 REDWOOD HEADER	1	EA.
STREET SIGN	1	EA.
BARICADE	1	EA.

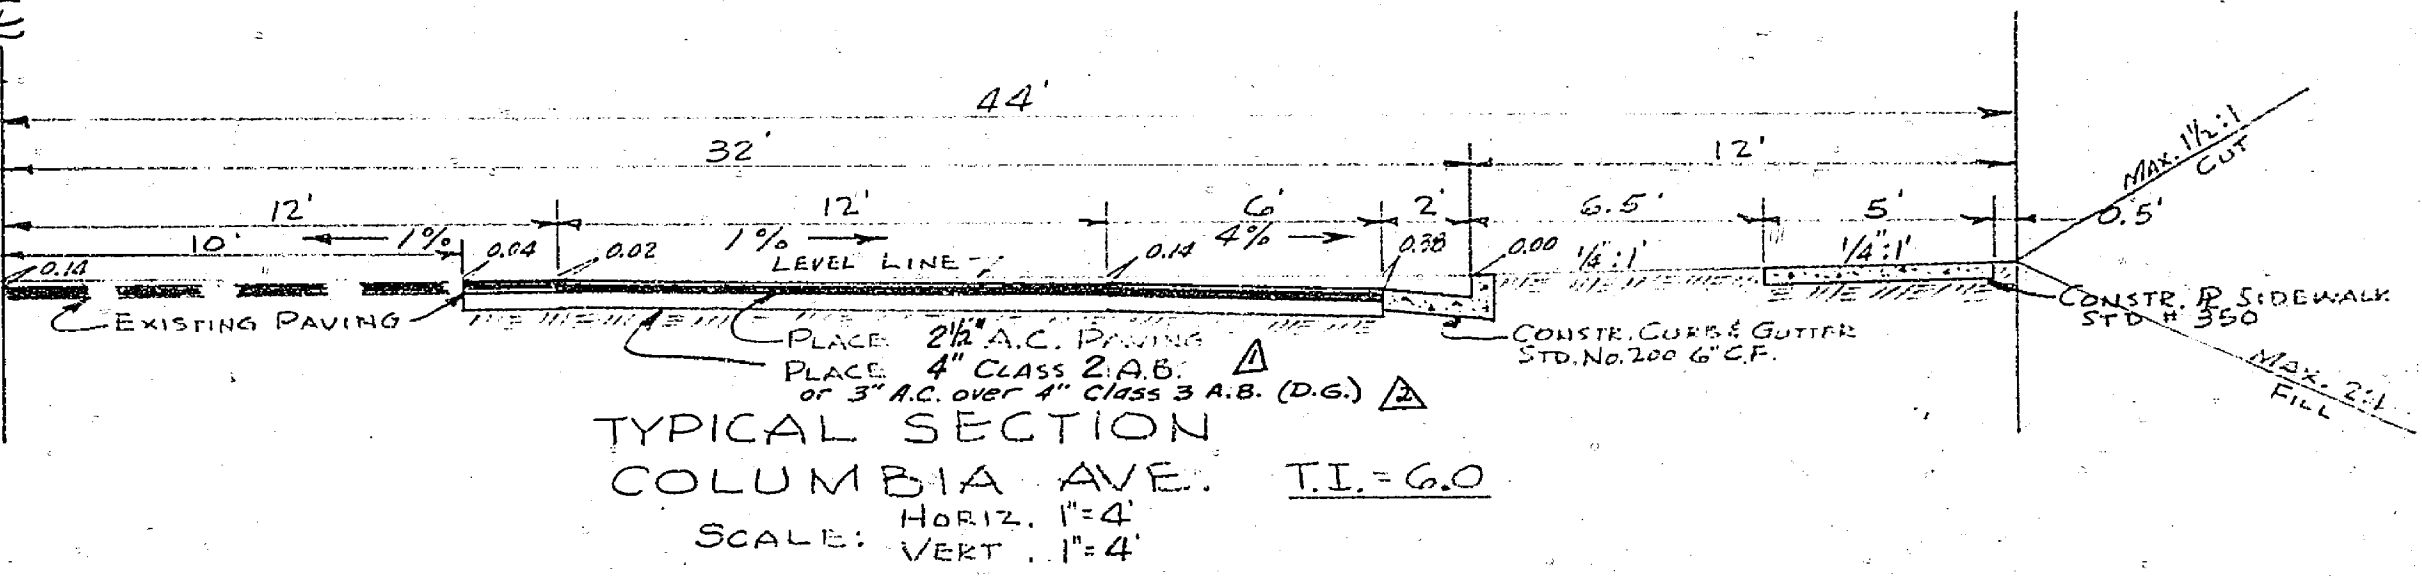

- GENERAL NOTES**
1. ALL CONSTRUCTION SHALL BE IN ACCORDANCE WITH SPECIFICATIONS NO. 461 OF THE CITY OF RIVERSIDE DEPARTMENT OF PUBLIC WORKS AND CITY OF RIVERSIDE STANDARD DRAWINGS.
 2. IT SHALL BE THE RESPONSIBILITY OF THE CONTRACTOR TO CLEAR THE RIGHT OF WAY IN ACCORDANCE WITH THE PROVISIONS OF LAW AS IT AFFECTS EACH UTILITY INCLUDING IRRIGATION LINES AND APPURTENANCES, AND AT NO COST TO THE CITY OF RIVERSIDE.
 3. THE DEVELOPER SHALL ARRANGE FOR A SOIL TEST AT THE SUBGRADE LEVEL BY A SOILS ENGINEER. THICKNESS OF PAVEMENT AND THICKNESS AND TYPE OF AGGREGATE BASE SHALL BE DETERMINED BY THE SOILS ENGINEER AND SUBMITTED TO THE CITY OF RIVERSIDE FOR APPROVAL PRIOR TO CONSTRUCTION.
 4. DEVELOPER IS TO FURNISH AND INSTALL STREET NAME SIGN AND POST PER RIVERSIDE CITY STANDARD DRAWING NO. 662.
 5. TRIM EDGE OF EXISTING PAVING TO A CLEAN STRAIGHT LINE. CONSTRUCT MATCH-UP PAVING AND OVERLAY EXISTING PAVING AS DIRECTED IN THE FIELD, TO PRODUCE A SMOOTH GRADUAL SECTION. ENGINEER ESTIMATES OVERLAY TO BE 0 TONS.
 6. FURMS COAT, SEAL COAT AND PAINT BINDER REQUIRED.
 7. DRIVEWAY APPROACHES TO BE CONSTRUCTED PER STD. DWG. # 302 AND TO BE LOCATED IN FIELD.

TYPICAL SECTION CLOVERDALE AVE. TI-5.0
 SCALE: HORIZ. 1" = 4'
 VERT. 1" = 4'

THORNE SURVEYING, INC.
 3920 - 11th Street
 RIVERSIDE, CALIFORNIA
 APPROVED BY: JOSEPH C. GONZALEZ
 R.E. 11466

DESIGNED BY	DRAWN BY	CHECKED BY

CITY OF RIVERSIDE, CALIFORNIA
 DEPARTMENT OF PUBLIC WORKS

STREET PLAN AND PROFILE
 COLUMBIA AVE.
 CLOVERDALE ST.
 R.S. 10 65

F.B. 616/57
 B.M. TOP I.P. UNDER CAP
 @ MAIN & COLUMBIA
 ELEV. 813.99
 PROJECT NO. W.D. 1684
R-1359
 SHEET 1 OF 1
 FILE NO. F.B. 32/31
 WORK 1684