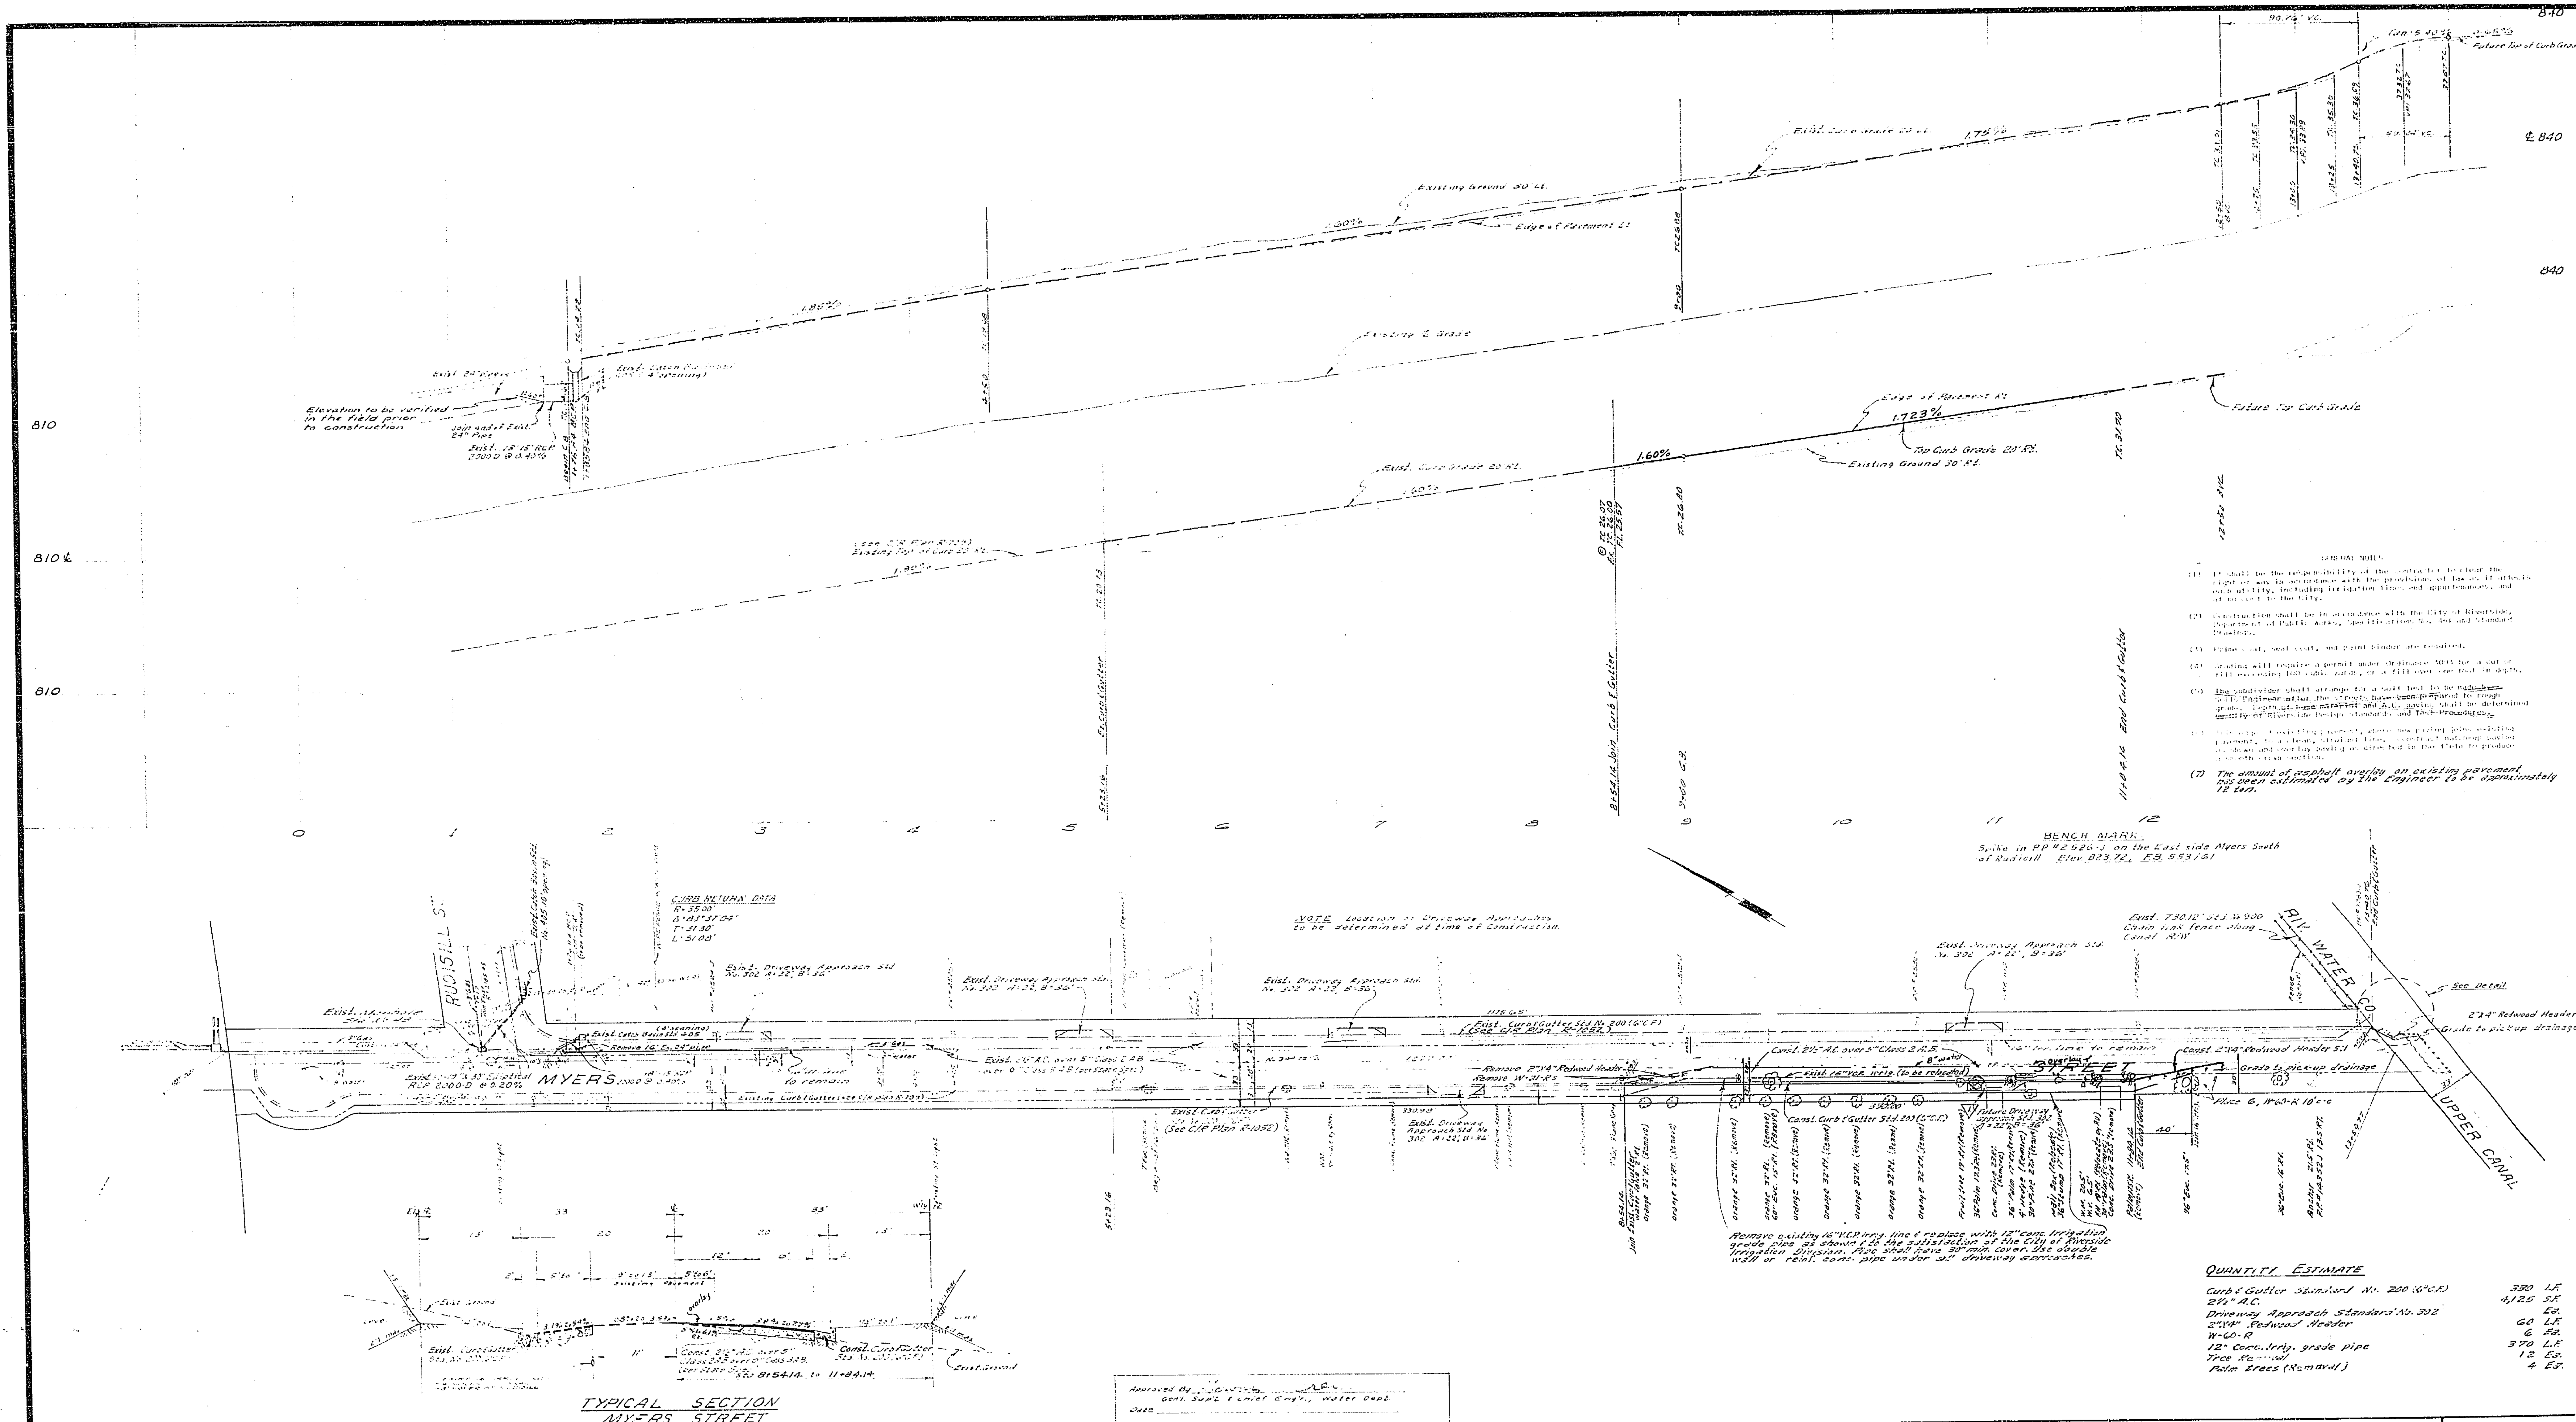

GENERAL NOTES

(1) It shall be the responsibility of the contractor to clear the right of way in accordance with the provisions of law as it affects each utility, including irrigation lines and appurtenances, and at no cost to the City.

(2) Construction shall be in accordance with the City of Riverside, Department of Public Works, Specifications No. 464 and Standard Provisions.

(3) Prime coat, seal coat, and paint binder are required.

(4) Grading will require a permit under Ordinance 3095 for a cut or fill exceeding 100 cubic yards, or a fill over one foot in depth.

(5) The subdivider shall arrange for a soil test to be made by a Soils Engineer after the streets have been prepared to rough grade. Depth of base material and A.C. paving shall be determined by ... of Riverside Design Standards and Test Procedures.

(6) Trim edge of existing pavement, where new paving joins existing pavement, to a clean, straight line. Construct matchup paving as shown and overlay paving as directed in the field to produce a smooth cross section.

(7) The amount of asphalt overlay on existing pavement has been estimated by the Engineer to be approximately 12 ton.

QUANTITY ESTIMATE

Curb & Gutter Standard No. 200 (6" C.F.)	330	L.F.
2½" A.C.	4,125	S.F.
Driveway Approach Standard No. 302		Ea.
2"x4" Redwood Header	60	L.F.
W-60-R	6	Ea.
12" Conc. Irrig. grade pipe	370	L.F.
Tree Removal	12	Ea.
Palm Trees (Removal)	4	Ea.

NOTICE TO CONTRACTOR

The existence and location of any underground utility pipes or structures shown on these plans are obtained by a search of the available records. To the best of our knowledge, there are no existing utilities except as shown on these plans.

The Contractor is required to take due precautionary measures to protect the utility lines shown and any other lines not of record or not shown on these plans.

Approved By ________ Genl. Sup't. & Chief Eng'r., Water Dept.
Date ________

ALBERT A. WEBB ASSOCIATES
CIVIL ENGINEERS
RIVERSIDE, CALIFORNIA
APPROVED BY [signature] DATE 9/23/69
R.E. No. 9872
W.O. 69-263 FOR: FLEETWOOD ENTERPRISE F.B. 101 Z

MARK	REVISIONS	APPR.	DATE
1	Changed Const. Dim's. Future Driveway ...		

DESIGNED BY BEL DRAWN BY BEL CHECKED BY REC

CITY OF RIVERSIDE, CALIFORNIA
DEPARTMENT OF PUBLIC WORKS

APPROVED BY	BY	DATE
OFFICE ENGINEER		
PARK DEPARTMENT		
TRAFFIC DIVISION		
ASSISTANT CITY ENG.		

APPROVED BY
DIRECTOR OF PUBLIC WORKS
DATE

STREET PLAN & PROFILE
MYERS STREET
Between Rudisill & Riv. Water Co. Canal
ZONING CASE R-51-689
HORIZ. SCALE: 1" = 50' VERT. SCALE: 1" = 5'

PROJECT NO. R-1386
SHEET 1 OF 1
FILE NO. 69-263-A